


**NOTES:**

1. SEE (D) FOR KITCHEN CABINET WOOD TRIM & PULLS
2. VERIFY CABINET OPENINGS W/ APPLIANCES PRIOR TO FABRICATION
3. MEDICINE CABINETS TO BE BUILT IN W/ MIRROR FACE
4. ALLOW FOR MARBLE SILL BETWEEN CERAMIC TILE & CARPET

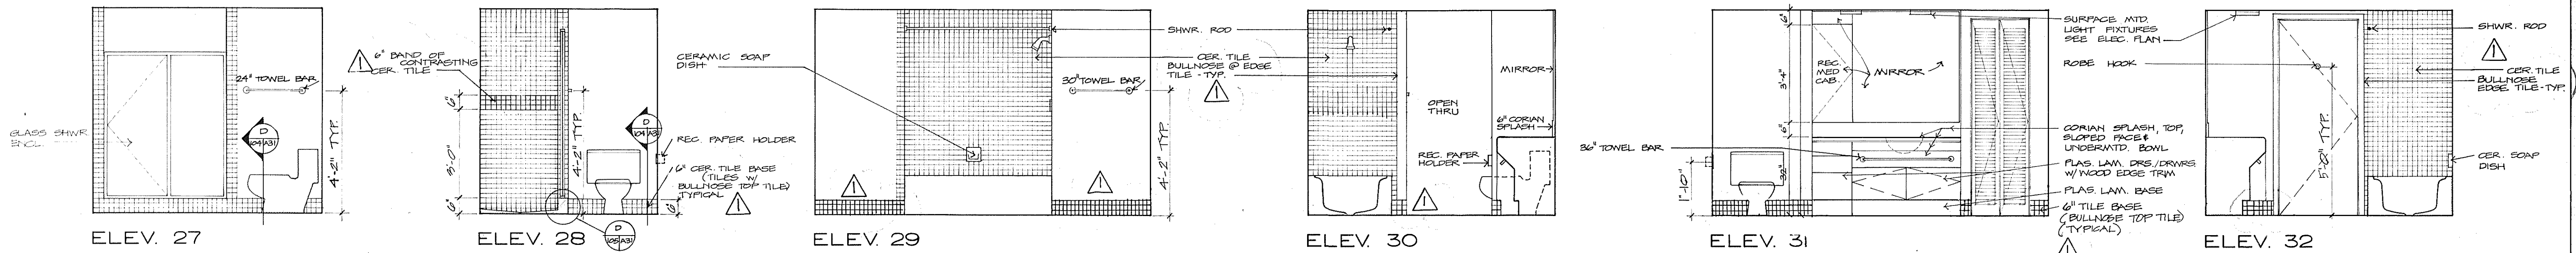

ELEV. 27  
UNITS B-R, B+R  
REVERSE B-L, B+L  
**BATH 1**


ELEV. 28

ELEV. 29  
UNITS B-R, B+R  
REVERSE B-L, B+L  
**BATH 2**

ELEV. 30

ELEV. 31

ELEV. 32

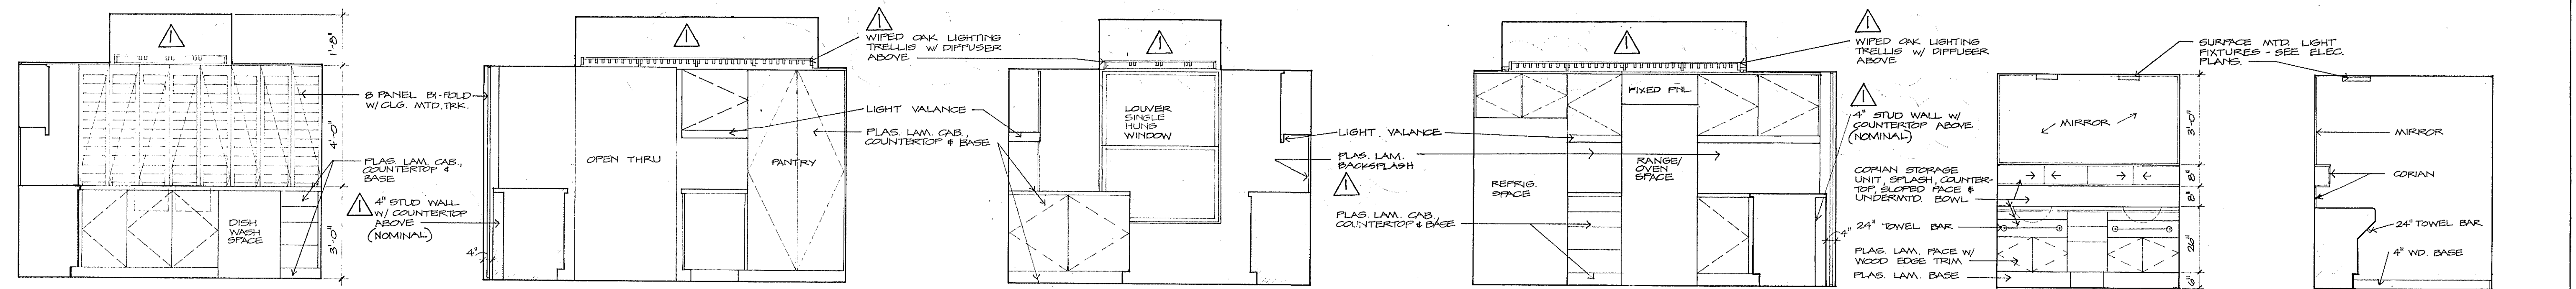

ELEV. 33  
UNITS C-R, C+R, C-MOD-R, D-R, D+R, D-MOD-R  
REVERSE C-L, C+L, C-MOD-L, D-L, D+L, D-MOD-L  
**KITCHEN**


ELEV. 34

ELEV. 35

ELEV. 36

ELEV. 37  
UNITS C-R, C+R, C-MOD-R  
REVERSE C-L, C+L, C-MOD-L  
**DRESSING**

ELEV. 38

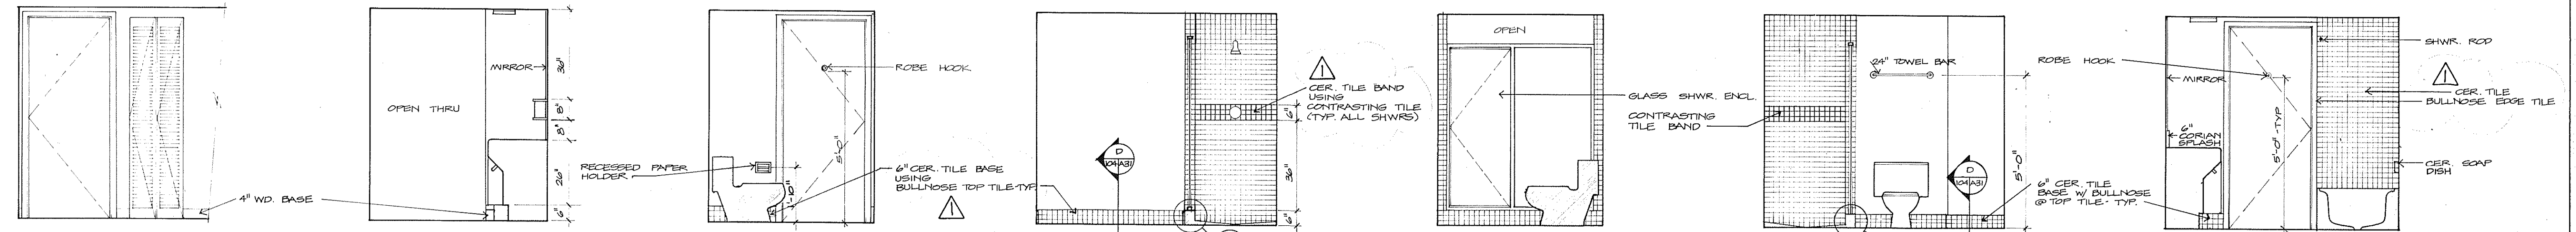

ELEV. 39

ELEV. 40


ELEV. 41  
UNITS C-R, C+R, C-MOD-R  
REVERSE C-L, C+L, C-MOD-L  
**BATH 1**

ELEV. 42

ELEV. 43

ELEV. 44

ELEV. 45  
UNITS C-R, C+R, C-MOD-R  
REVERSE C-L, C+L, C-MOD-L  
**BATH 2**

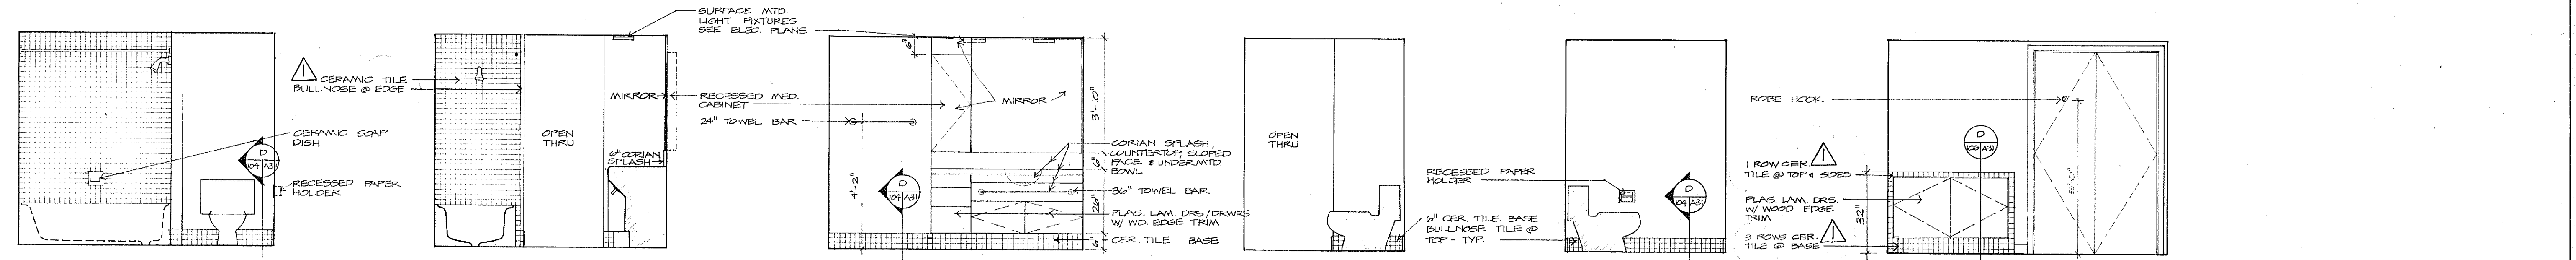

ELEV. 46

ELEV. 47

ELEV. 48

ELEV. 49

ELEV. 50

ELEV. 51  
UNIT D+R  
REVERSE D+L  
**BATH 1**