
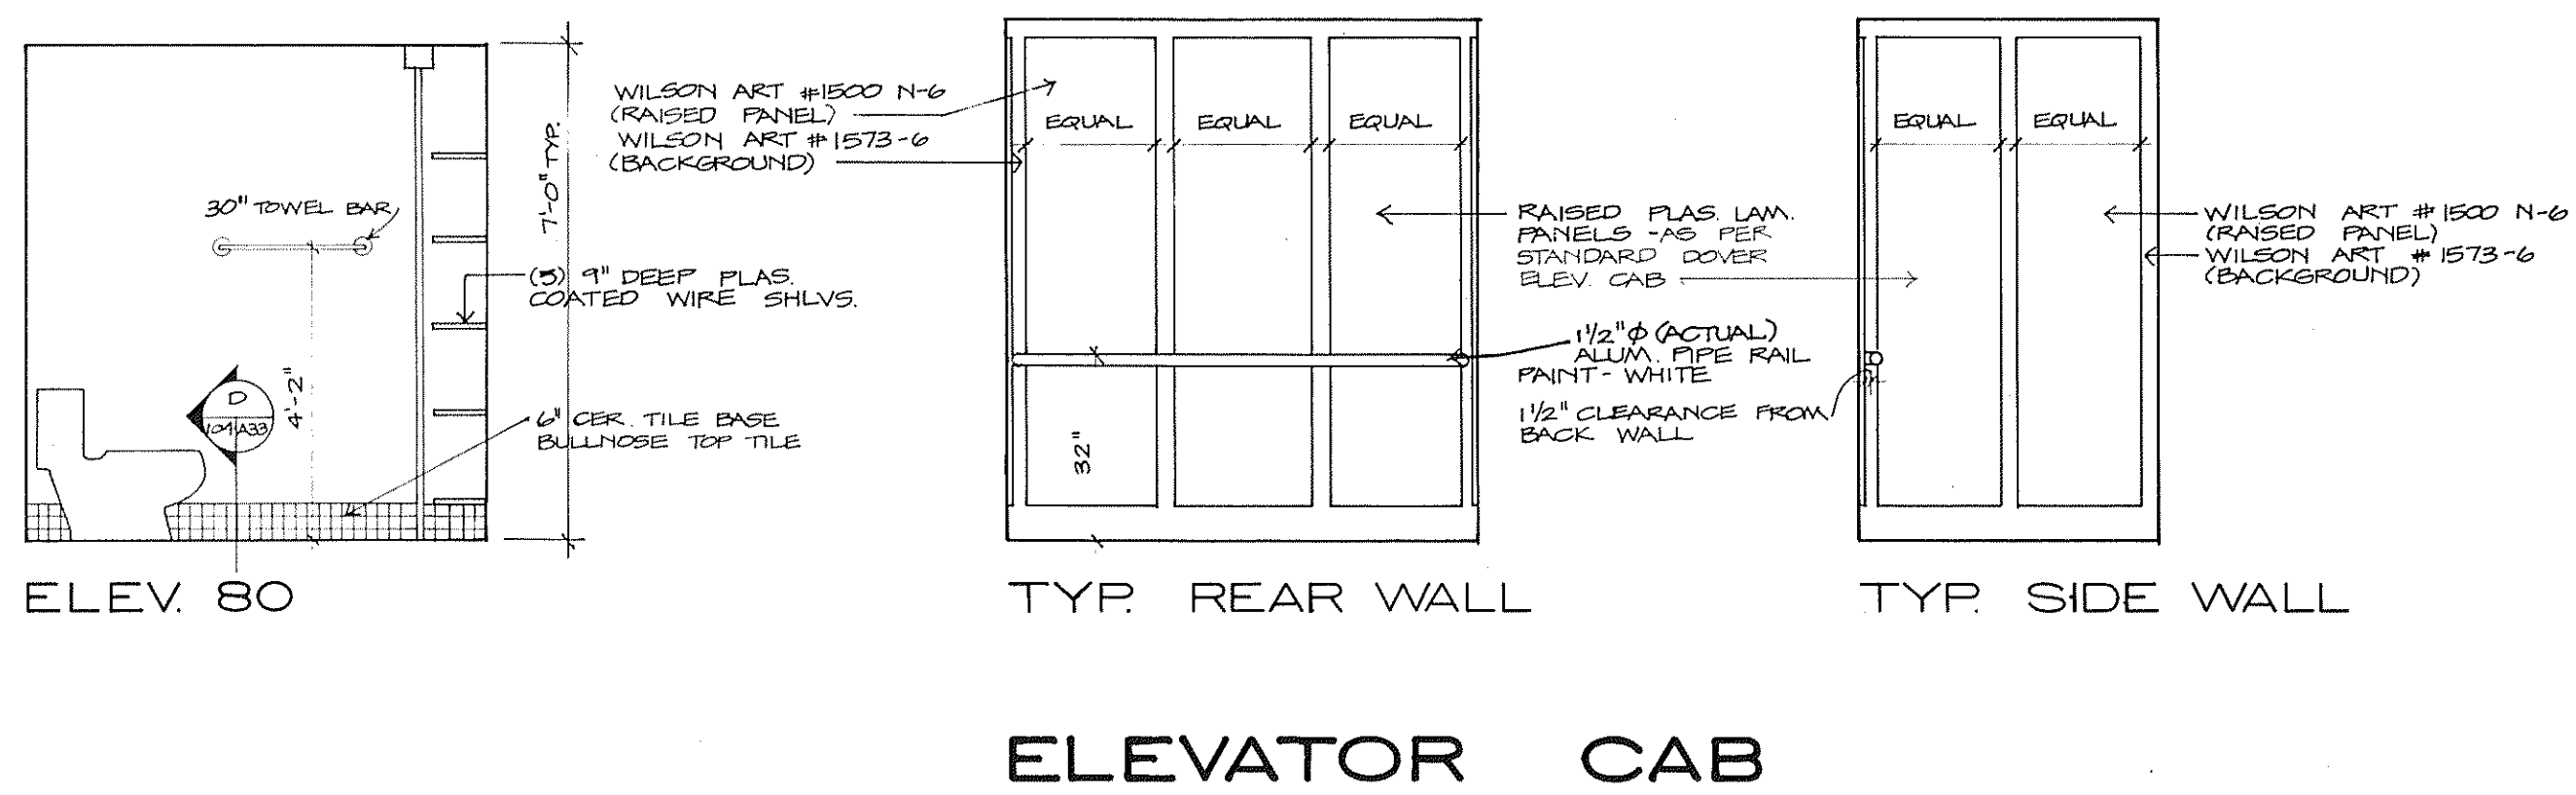


NOTES:
 1. MEDICINE CABINETS TO BE BUILT IN W/ MIRROR FACE
 2. ALLOW FOR MARBLE SILL BETWEEN CERAMIC TILE & CARPET

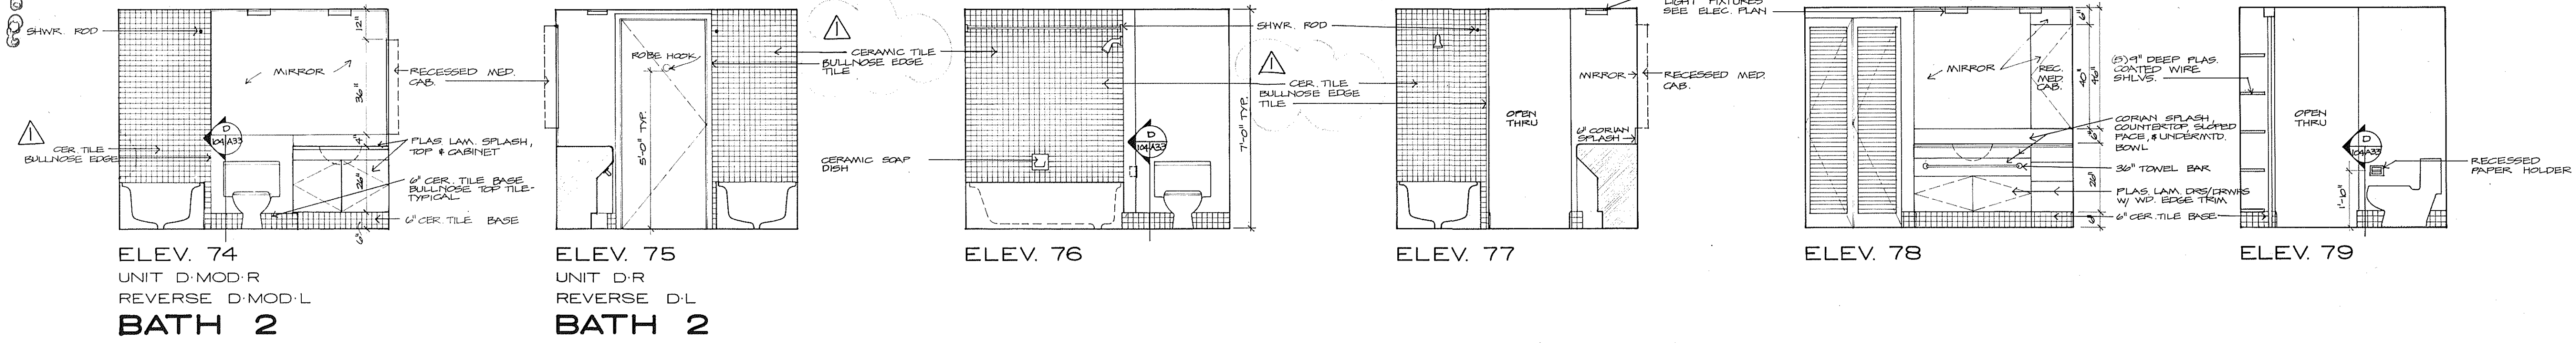

SUNSET BEACH
 SOF LONG BOAT KEY
 ARVIDA CORPORATION · EDWARD J SEBERT AIA ARCHITECT & PLANNER PA THE SWA GROUP
 BRABHAM KUHN'S DEBAY CONSULTING ENGINEERS · OLSEN WHITE & ASSOCIATES STRUCTURAL ENGINEERS · BENNETT & BISHOP INC CONSULTING ENGINEERS & SURVEYORS

INTERIOR ELEVATIONS 3/8" = 1'-0"

ISSUED	10 DEC. 82
REVISED	4-1-83
SHEET	A-33
	OF 37