
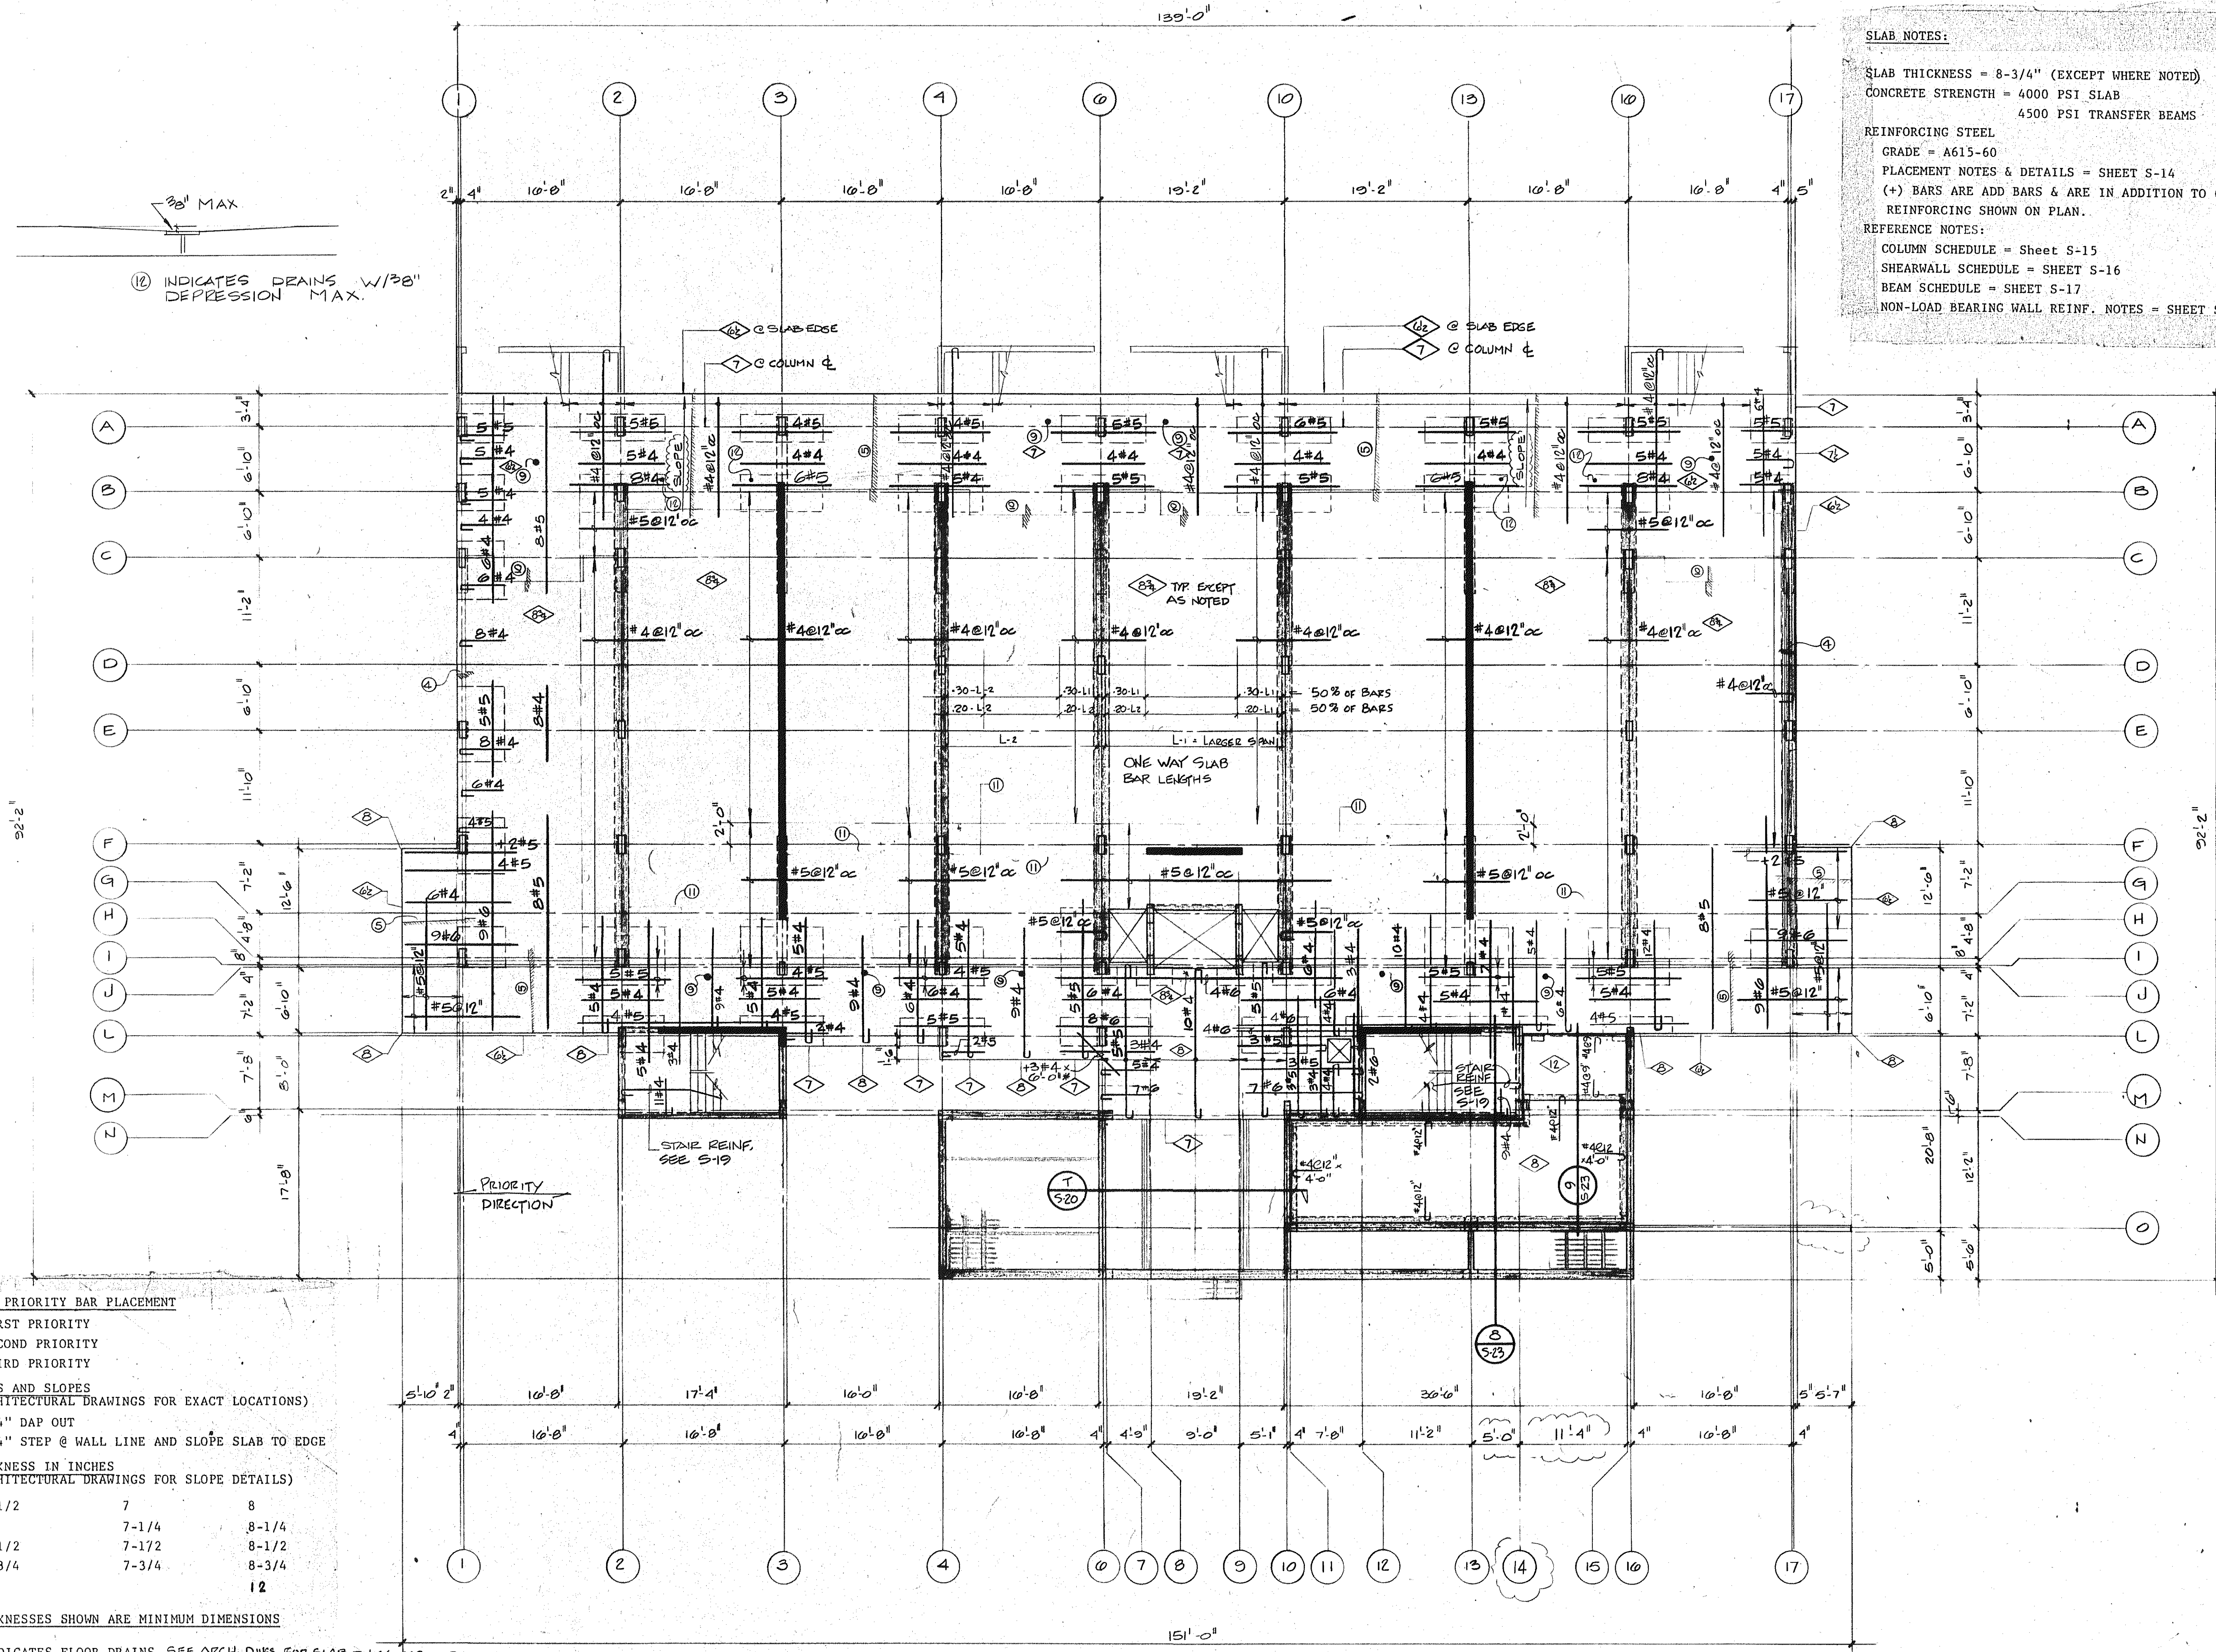


SLAB NOTES:

SLAB THICKNESS = 8-3/4" (EXCEPT WHERE NOTED)
 CONCRETE STRENGTH = 4000 PSI SLAB
 4500 PSI TRANSFER BEAMS

REINFORCING STEEL
 GRADE = A615-60
 PLACEMENT NOTES & DETAILS = SHEET S-14
 (+) BARS ARE ADD BARS & ARE IN ADDITION TO GRID
 REINFORCING SHOWN ON PLAN.

REFERENCE NOTES:
 COLUMN SCHEDULE = SHEET S-15
 SHEARWALL SCHEDULE = SHEET S-16
 BEAM SCHEDULE = SHEET S-17
 NON-LOAD BEARING WALL REINF. NOTES = SHEET S-14

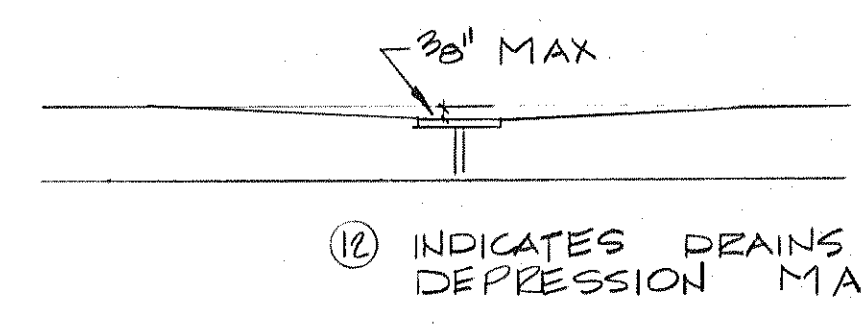

LEGEND

CHANGE IN PRIORITY BAR PLACEMENT

① FIRST PRIORITY
 ② SECOND PRIORITY
 ③ THIRD PRIORITY

SLAB STEPS AND SLOPES
 (SEE ARCHITECTURAL DRAWINGS FOR EXACT LOCATIONS)

④ 3/4" DAP OUT
 ⑤ 3/4" STEP @ WALL LINE AND SLOPE SLAB TO EDGE

SLAB THICKNESS IN INCHES
 (SEE ARCHITECTURAL DRAWINGS FOR SLOPE DETAILS)

5-1/2	7	8
6	7-1/4	8-1/4
6-1/2	7-1/2	8-1/2
6-3/4	7-3/4	8-3/4
		12

SLAB THICKNESSES SHOWN ARE MINIMUM DIMENSIONS GENERAL

⑨ INDICATES FLOOR DRAINS SEE ARCH. DWGS FOR SLAB THICKNESS & DRAINS
 3/4" STEP AT WALL LINE AND SLOPE TO DRAIN
 ⑩ INDICATES UNIT LINE AND START OF SLOPE TO DRAINS.

SUNSET BEACH
ISSUED: 12-10-82
REVISED: 1-4-83
 4-1-83
 11-11-83
SHEET S5
OF