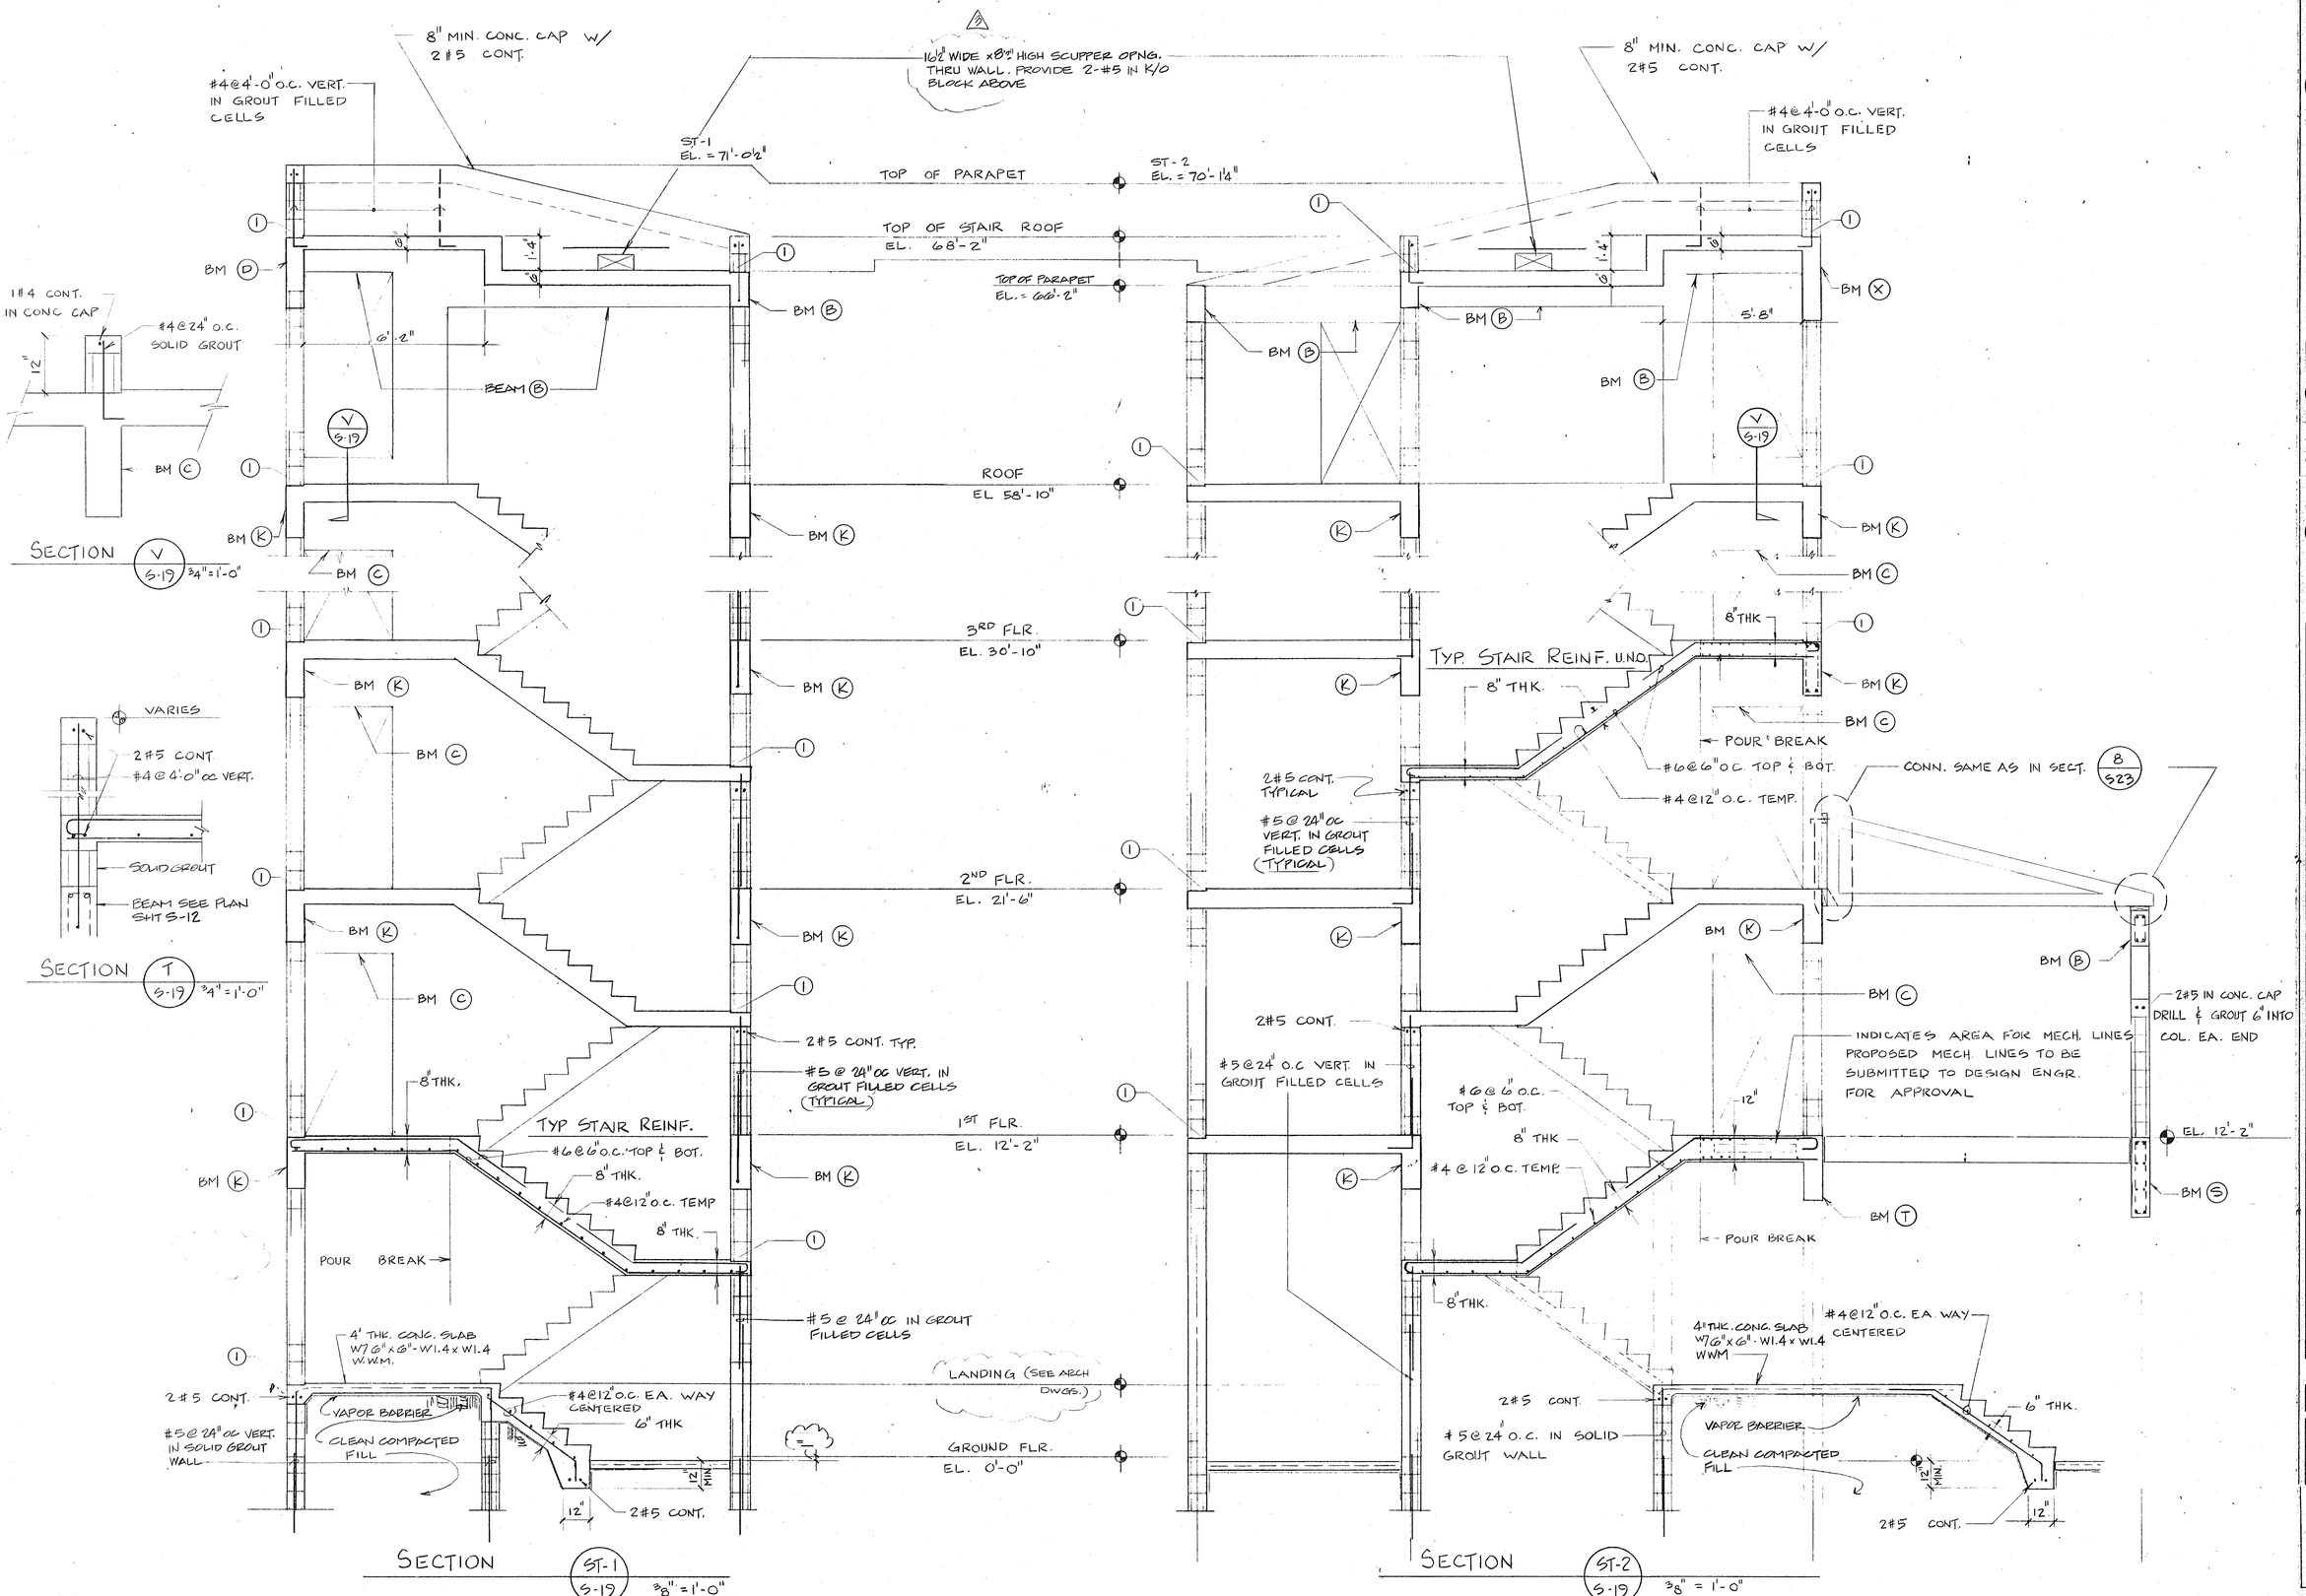

SUNSET BEACH OF LONGBOAT KEY

BLDG.- #1 SECTIONS & DETAILS

3/8"=1'-0"

ARVIDA CORPORATION · EDWARD J. SEIBERT AIA ARCHITECT & PLANNER PA · THE SWA GROUP
BRABHAM · KUHNS · DEBAY · CONSULTING ENGINEERS · OLSEN, WHITE & ASSOCIATES STRUCTURAL ENGINEERS · BENNETT & BISHOP INC CONSULTING ENGINEERS & SURVEYORS

ISSUED	12-10-82
REVISED	1-4-83
	4-1-83
	11-11-83

SHEET S.19 OF