
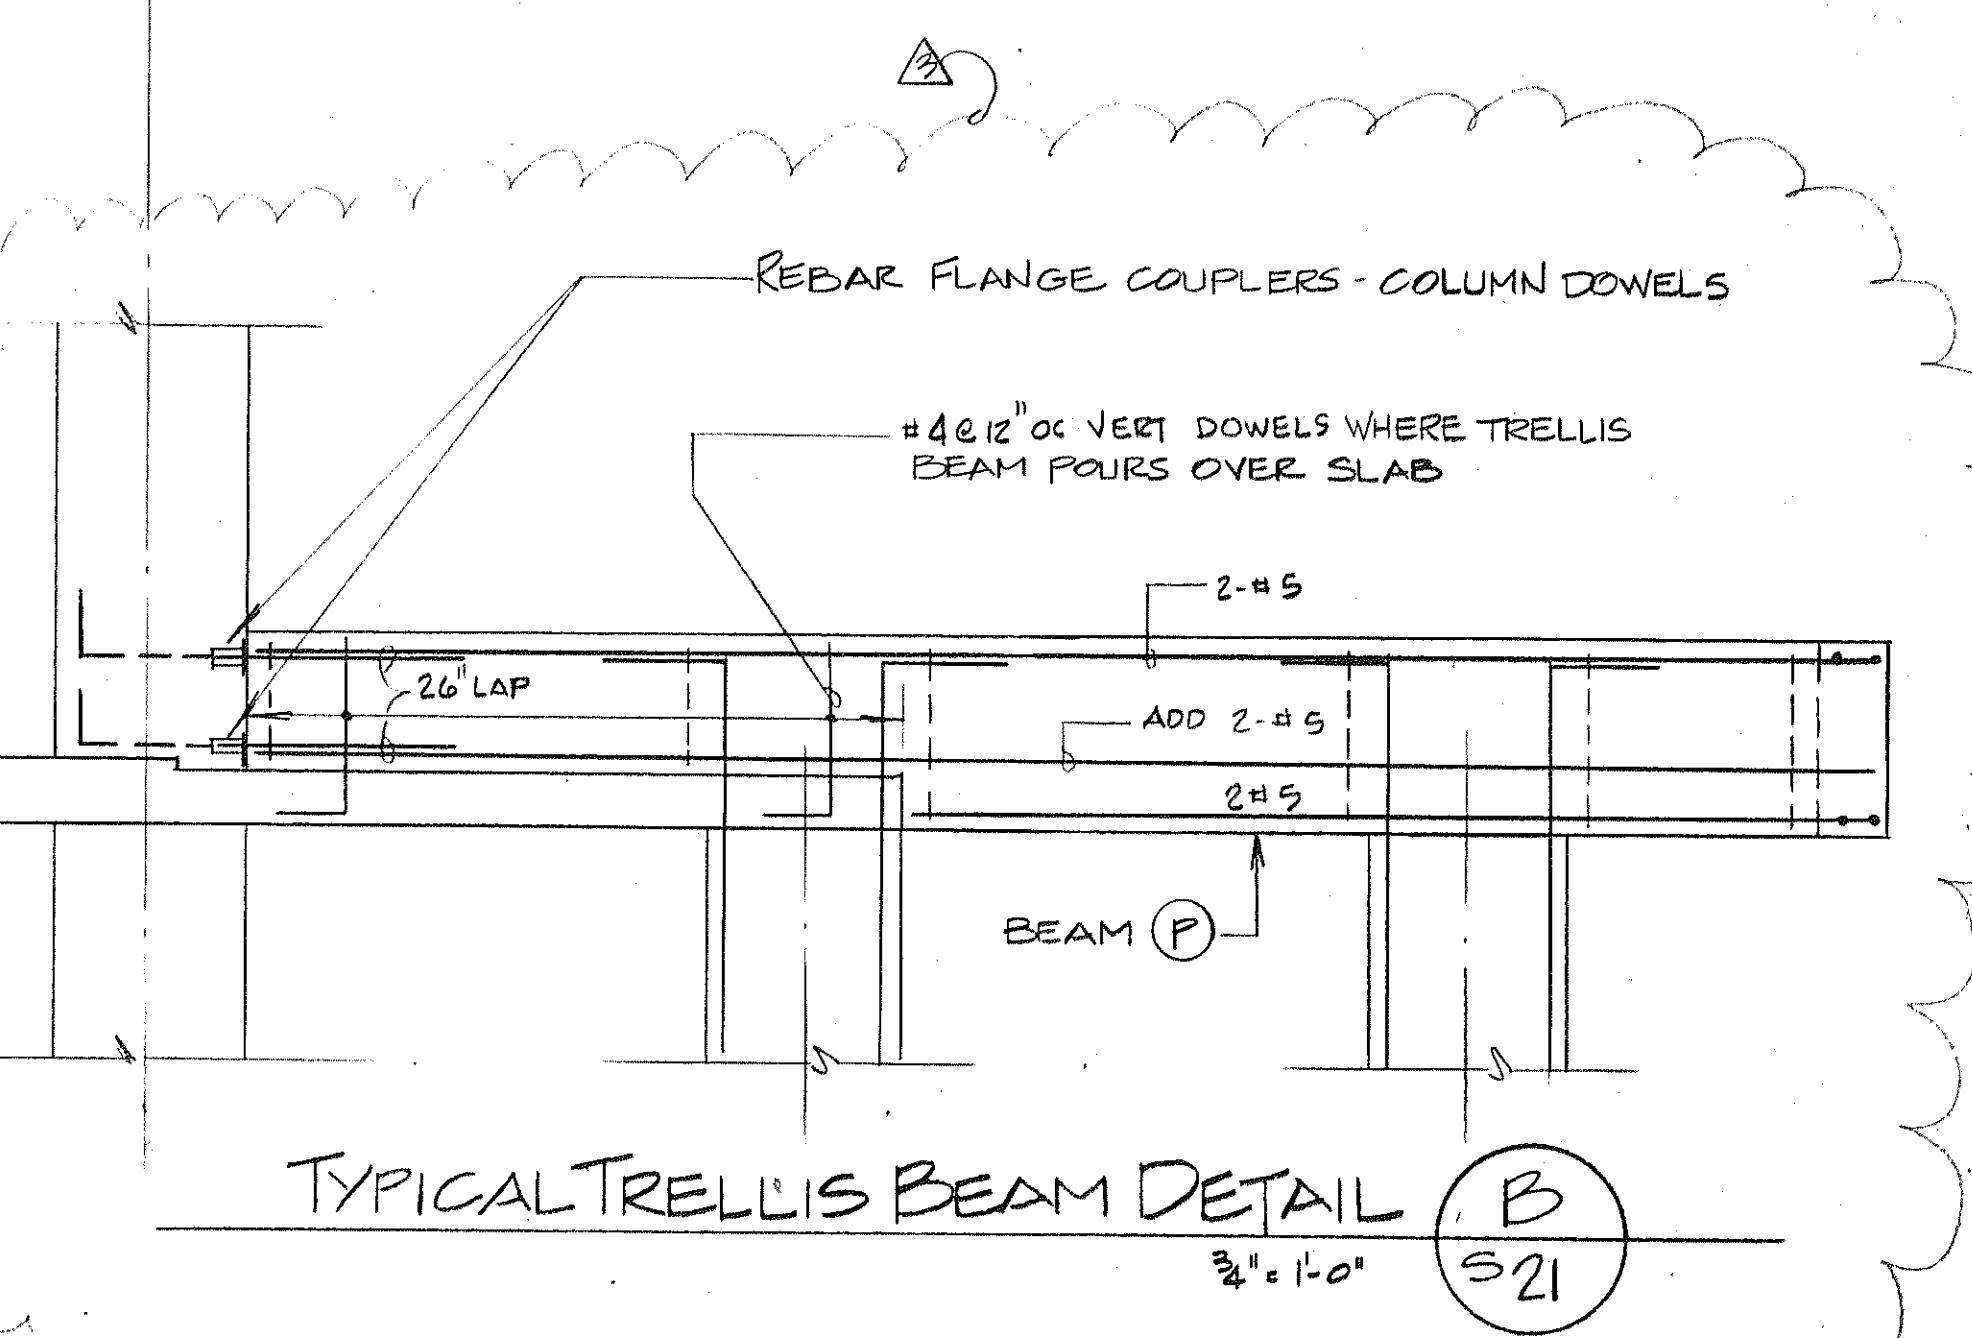


- LEGEND**
- ① 3/4" DAP OUT (STEP) TO OCCUR BEHIND WALLS & DOOR MULLIONS
 - ② SLOPE SLAB DOWN TO EXTERIOR FACE OF BUILDING
 - ③ TRANSFER BEAM
 - ④ 8" CONC. SLAB
 - ⑤ 8 3/4" CONC. SLAB

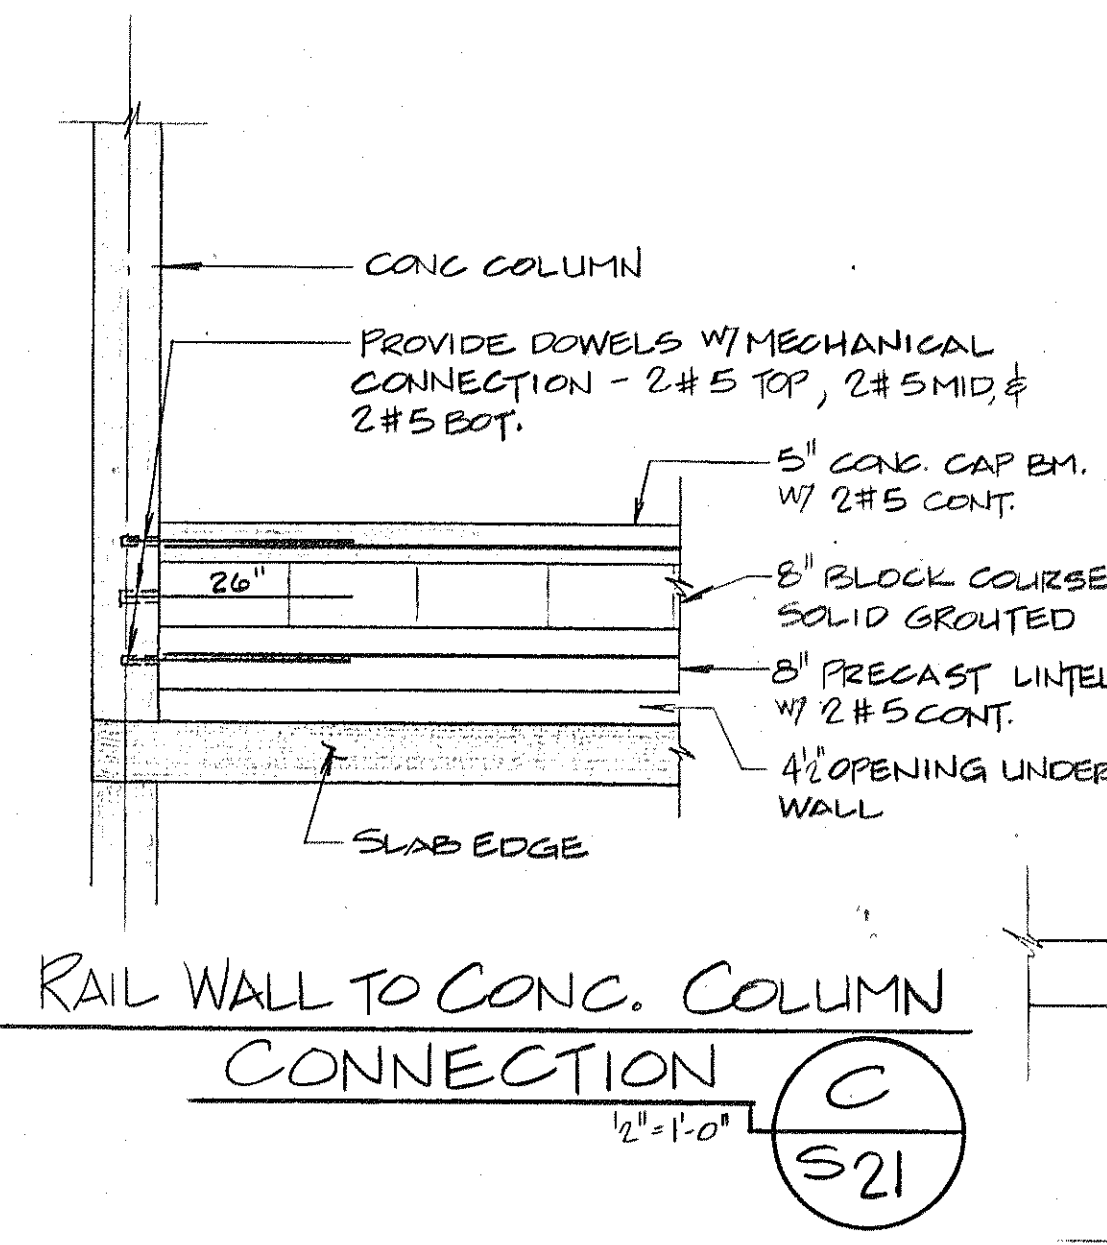

SECTION 1
3/8" = 1'-0"

SECTION 2
3/8" = 1'-0"

SECTION 3
3/8" = 1'-0"

BUILDING #1
 ISSUED 12-10-82
 REVISED 1-4-83
 11-11-82
 SHEET
 OF 21