
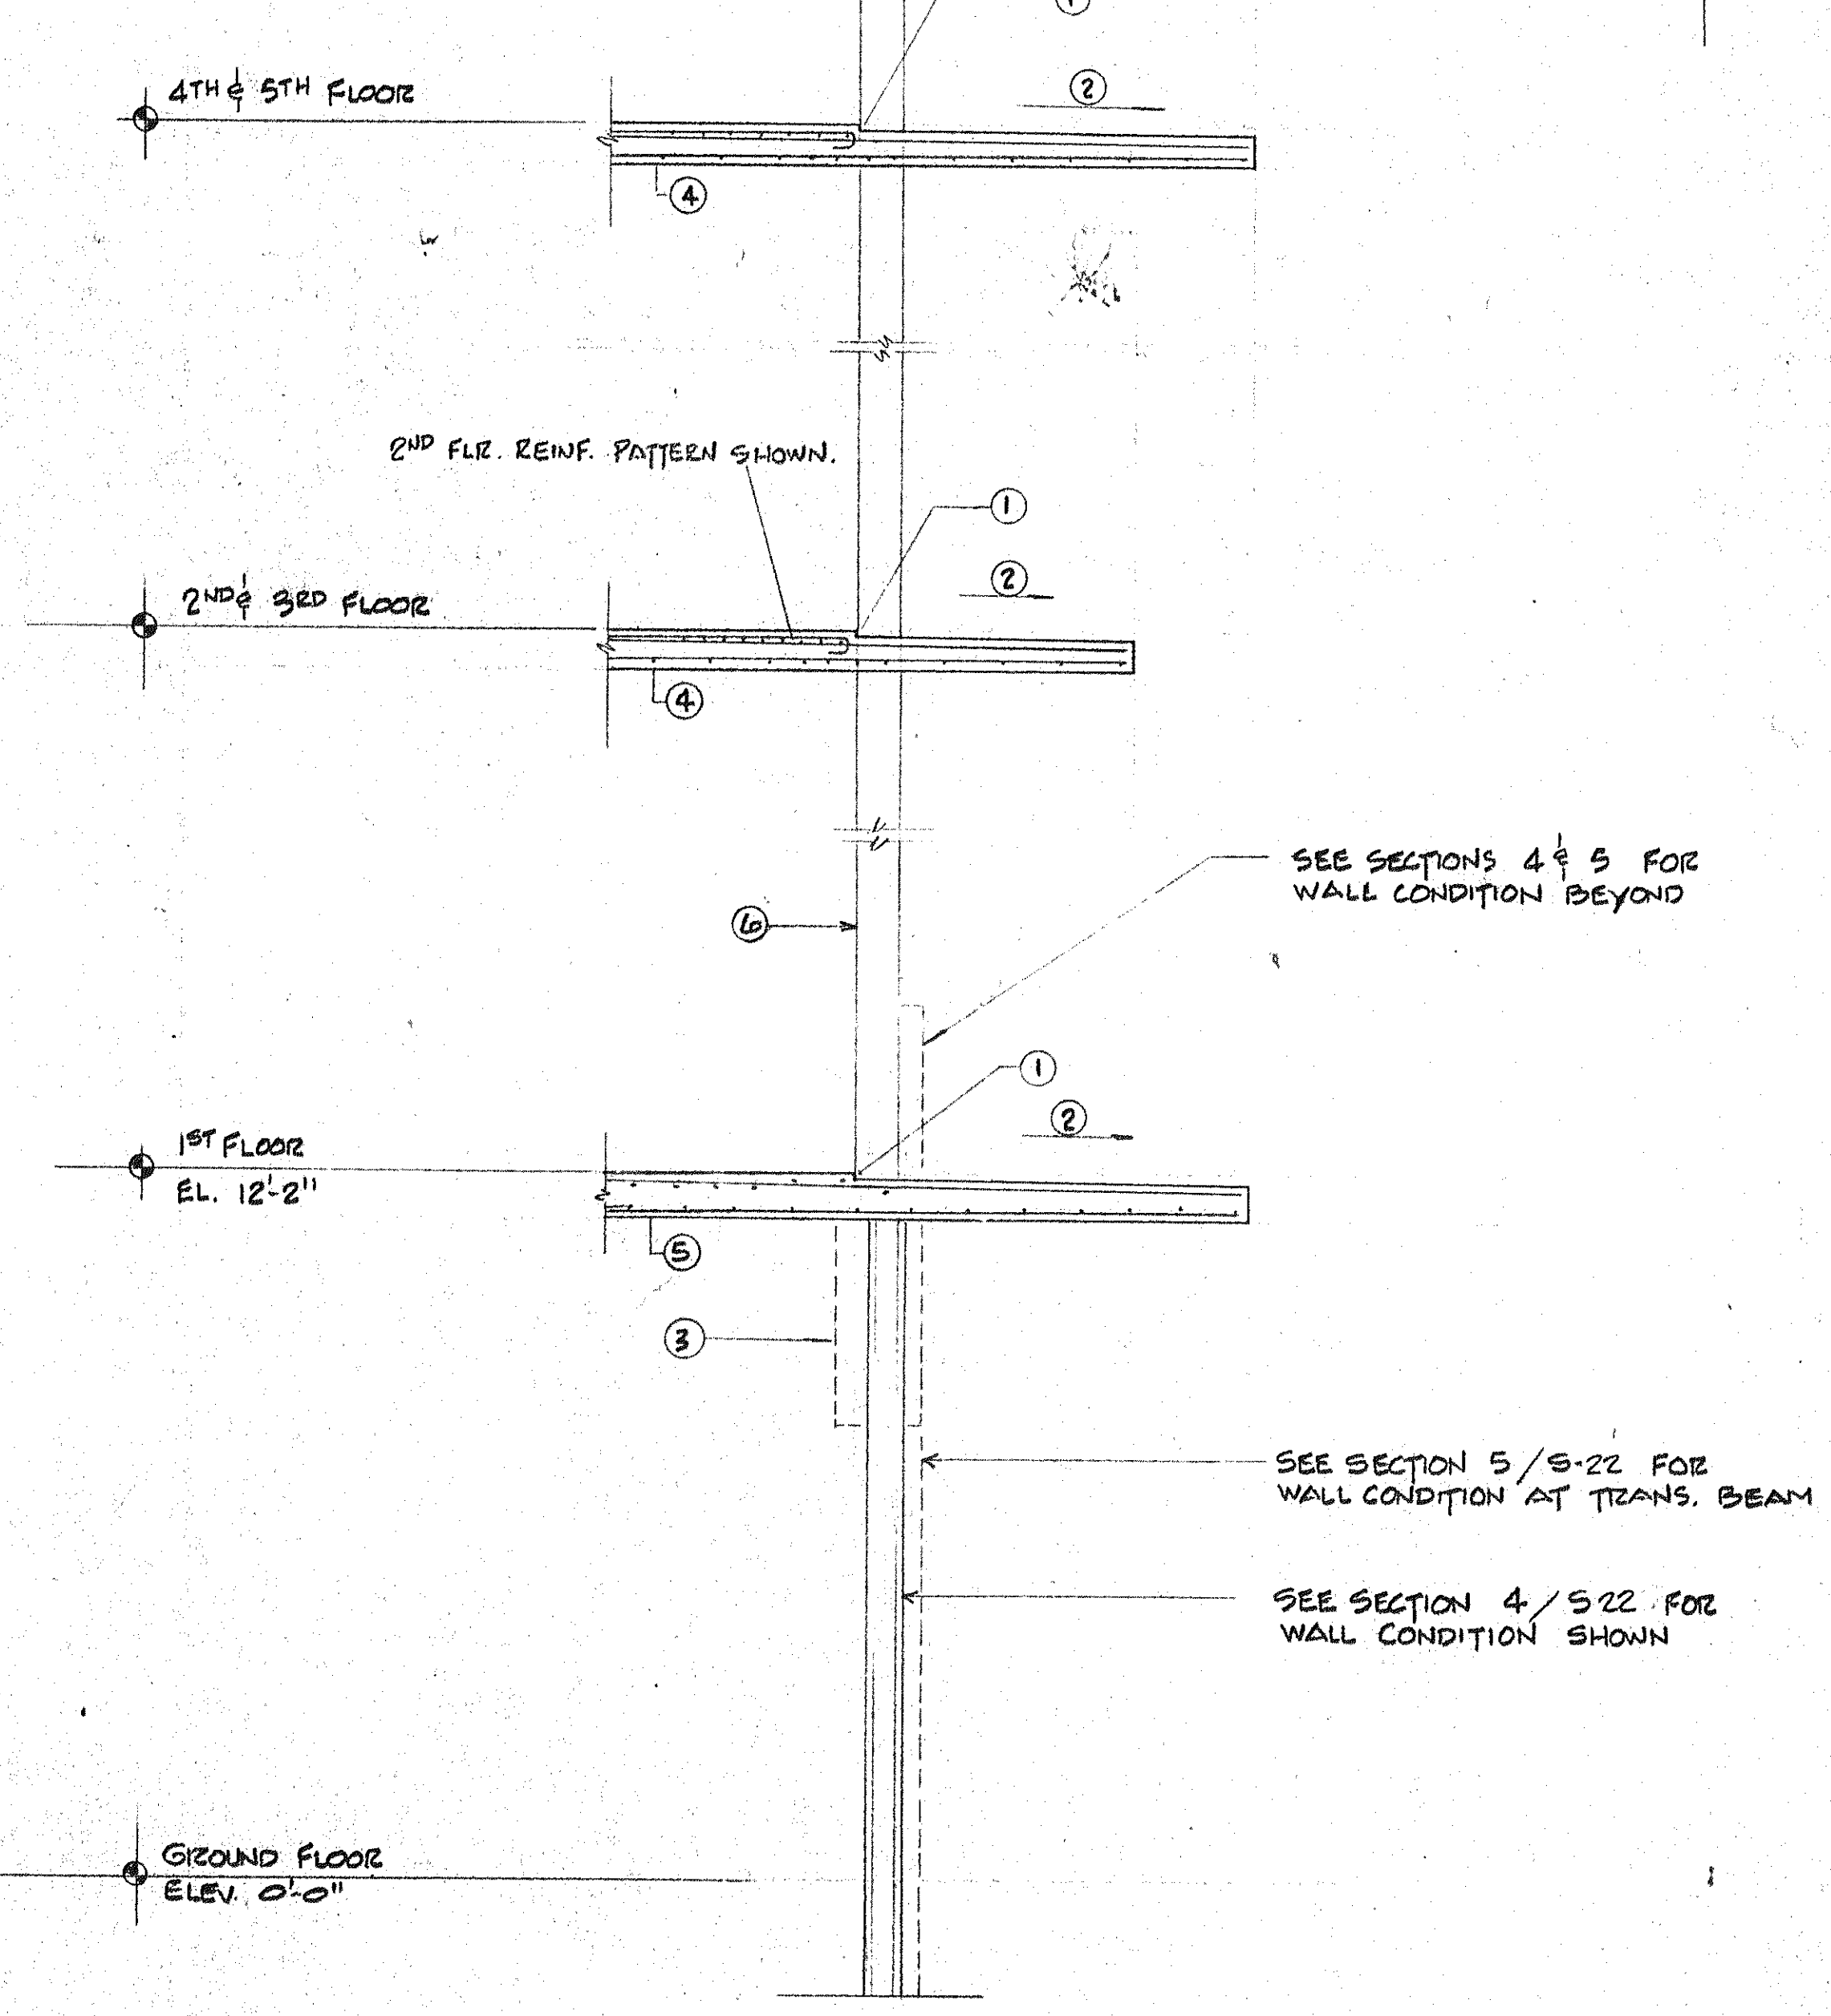


- LEGEND**
- ① 3/4" DAP (STEP) TO OCCUR BEHIND MASONRY WALLS & MULLIONS
 - ② SLOPE SLAB DOWN TO EXTERIOR FACE OF BLDG.
 - ③ TRANSFER BEAM SEE PLAN FOR LOCATION & SCHEDULE FOR REINF.
 - ④ 8" CONC. SLAB
 - ⑤ 8 3/4" CONC. SLAB
 - ⑥ MASONRY WALL BEYOND

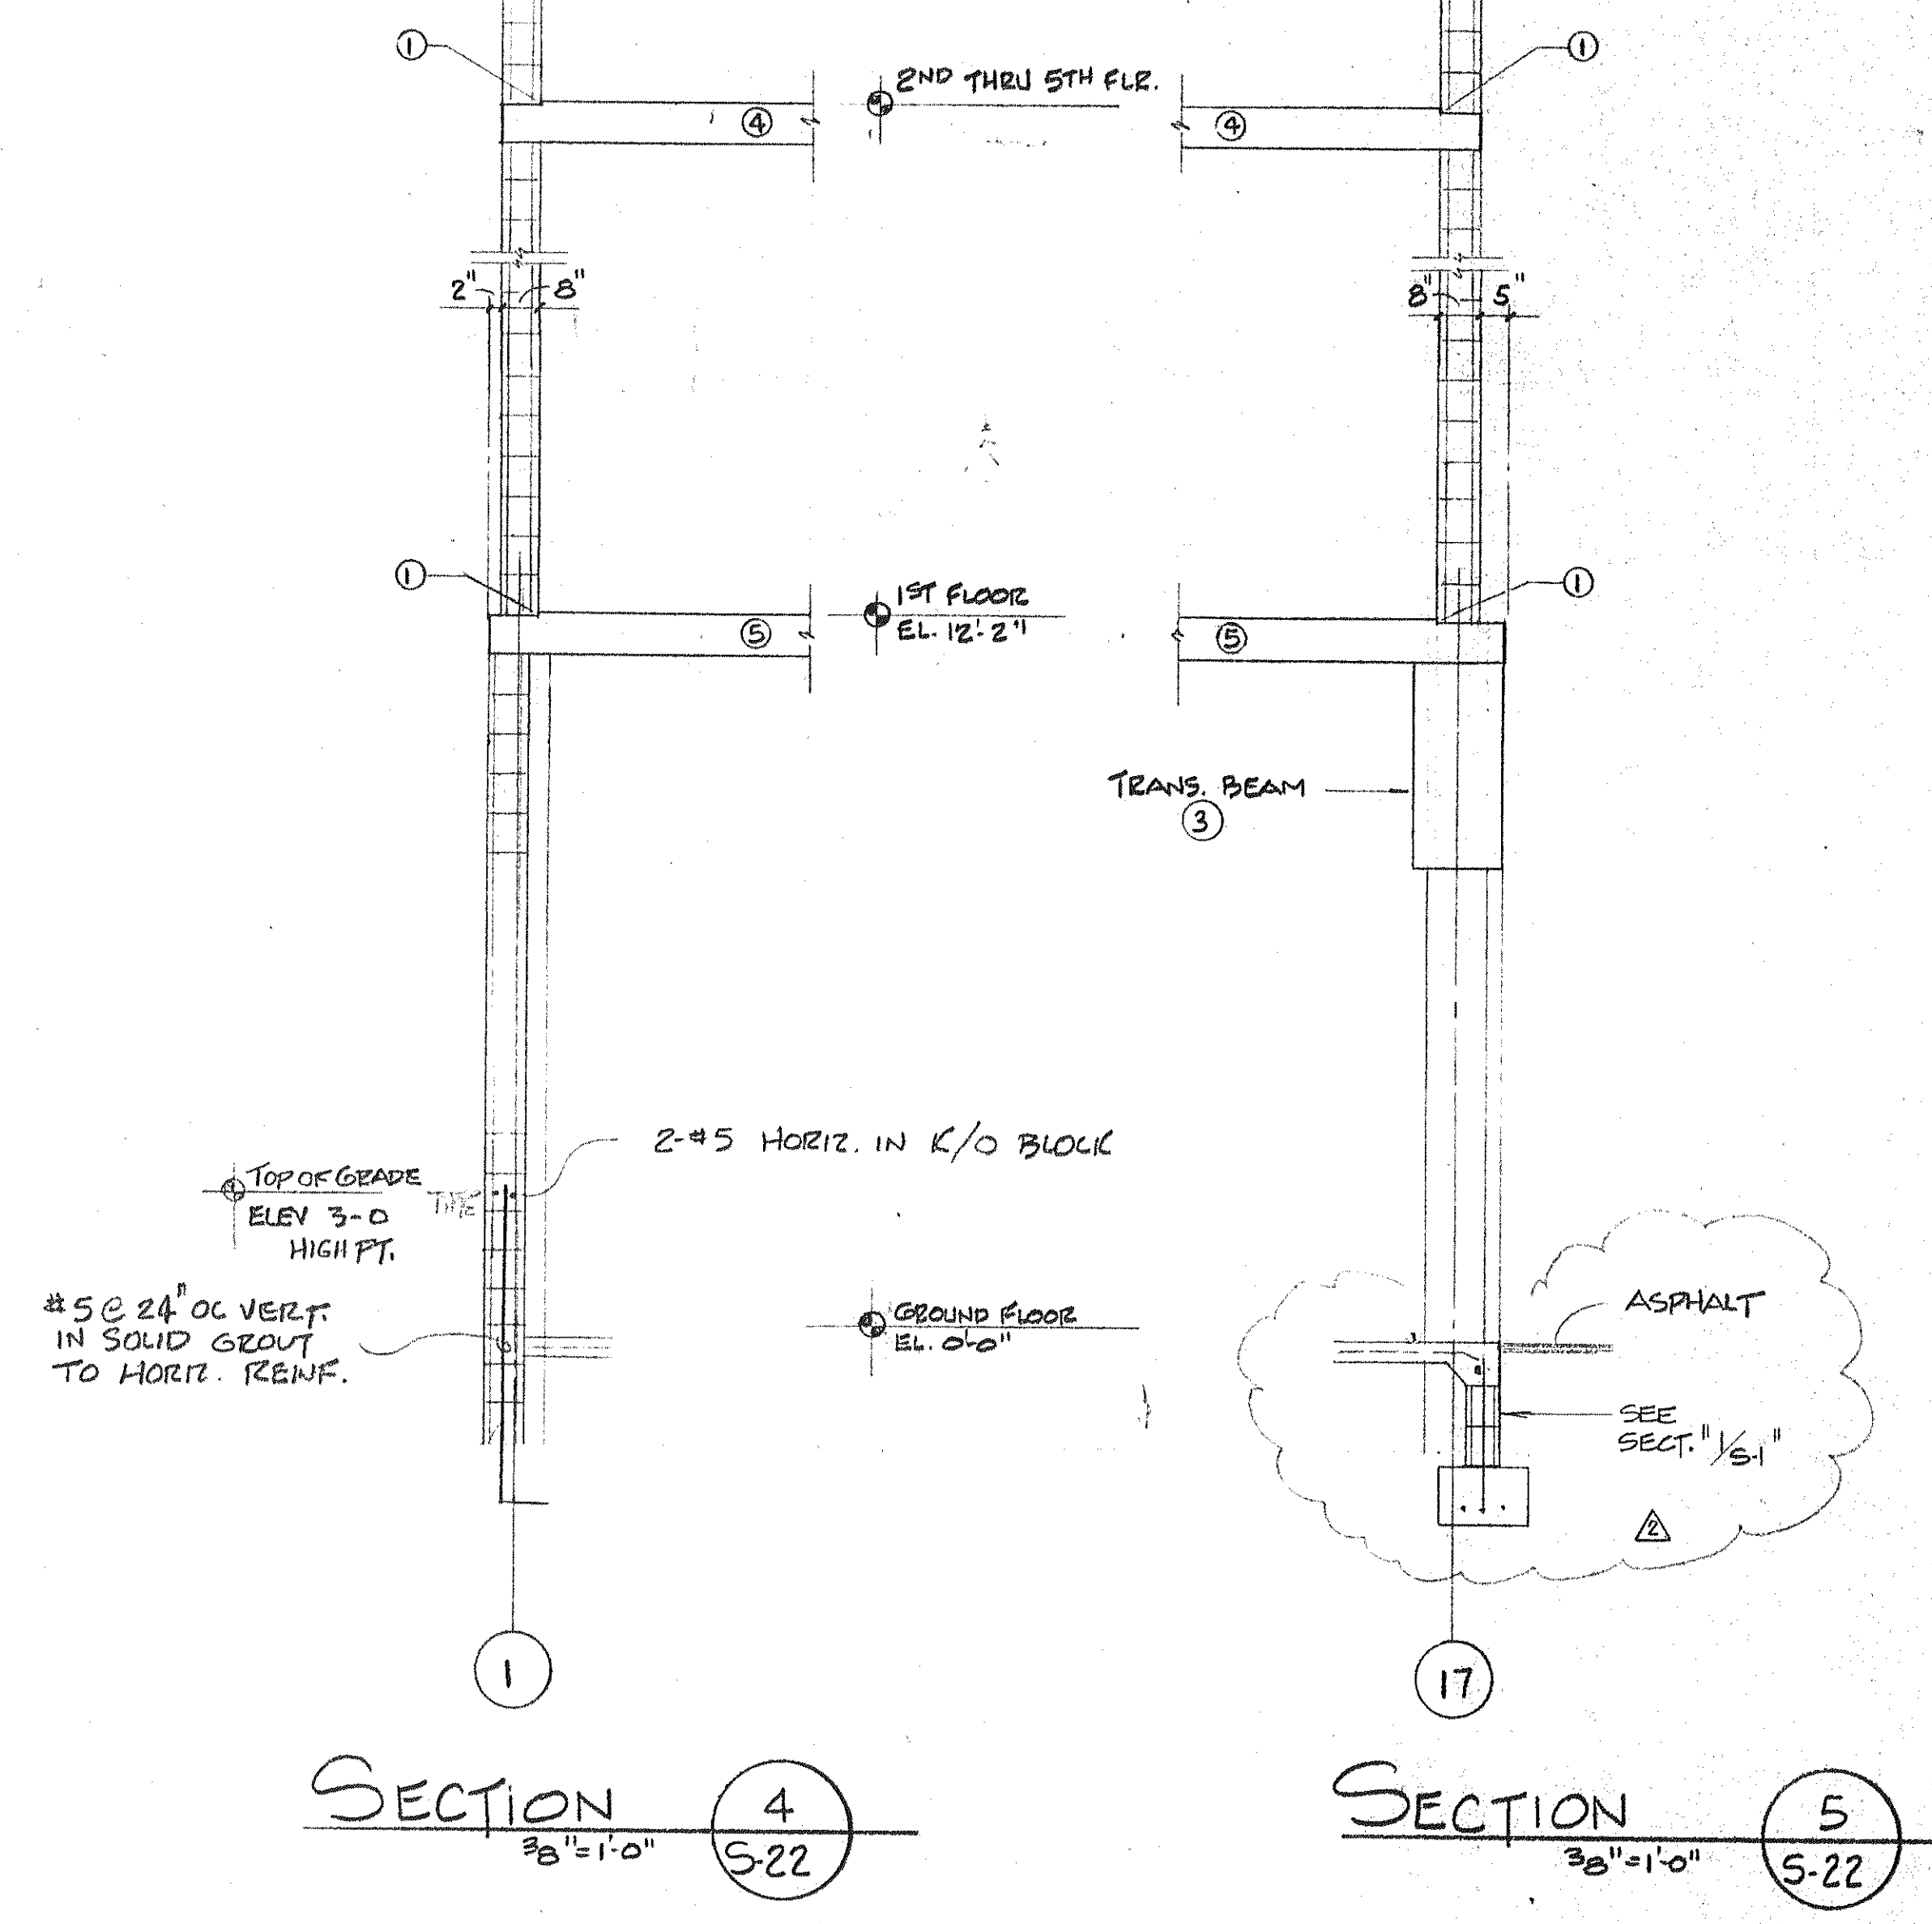

 #1 SECTIONS & DETAILS
 18'-11"-0"
 EDWARD SEELEY ARCHITECTS & PLANNERS INC. THE BAW GROUP
 CONSULTING ENGINEERS, CHRYSTIE & ASSOCIATES, STRUCTURAL