


UNIT 'A' LEFT - AIR CONDITIONING
SCALE 1/4" = 1'-0"

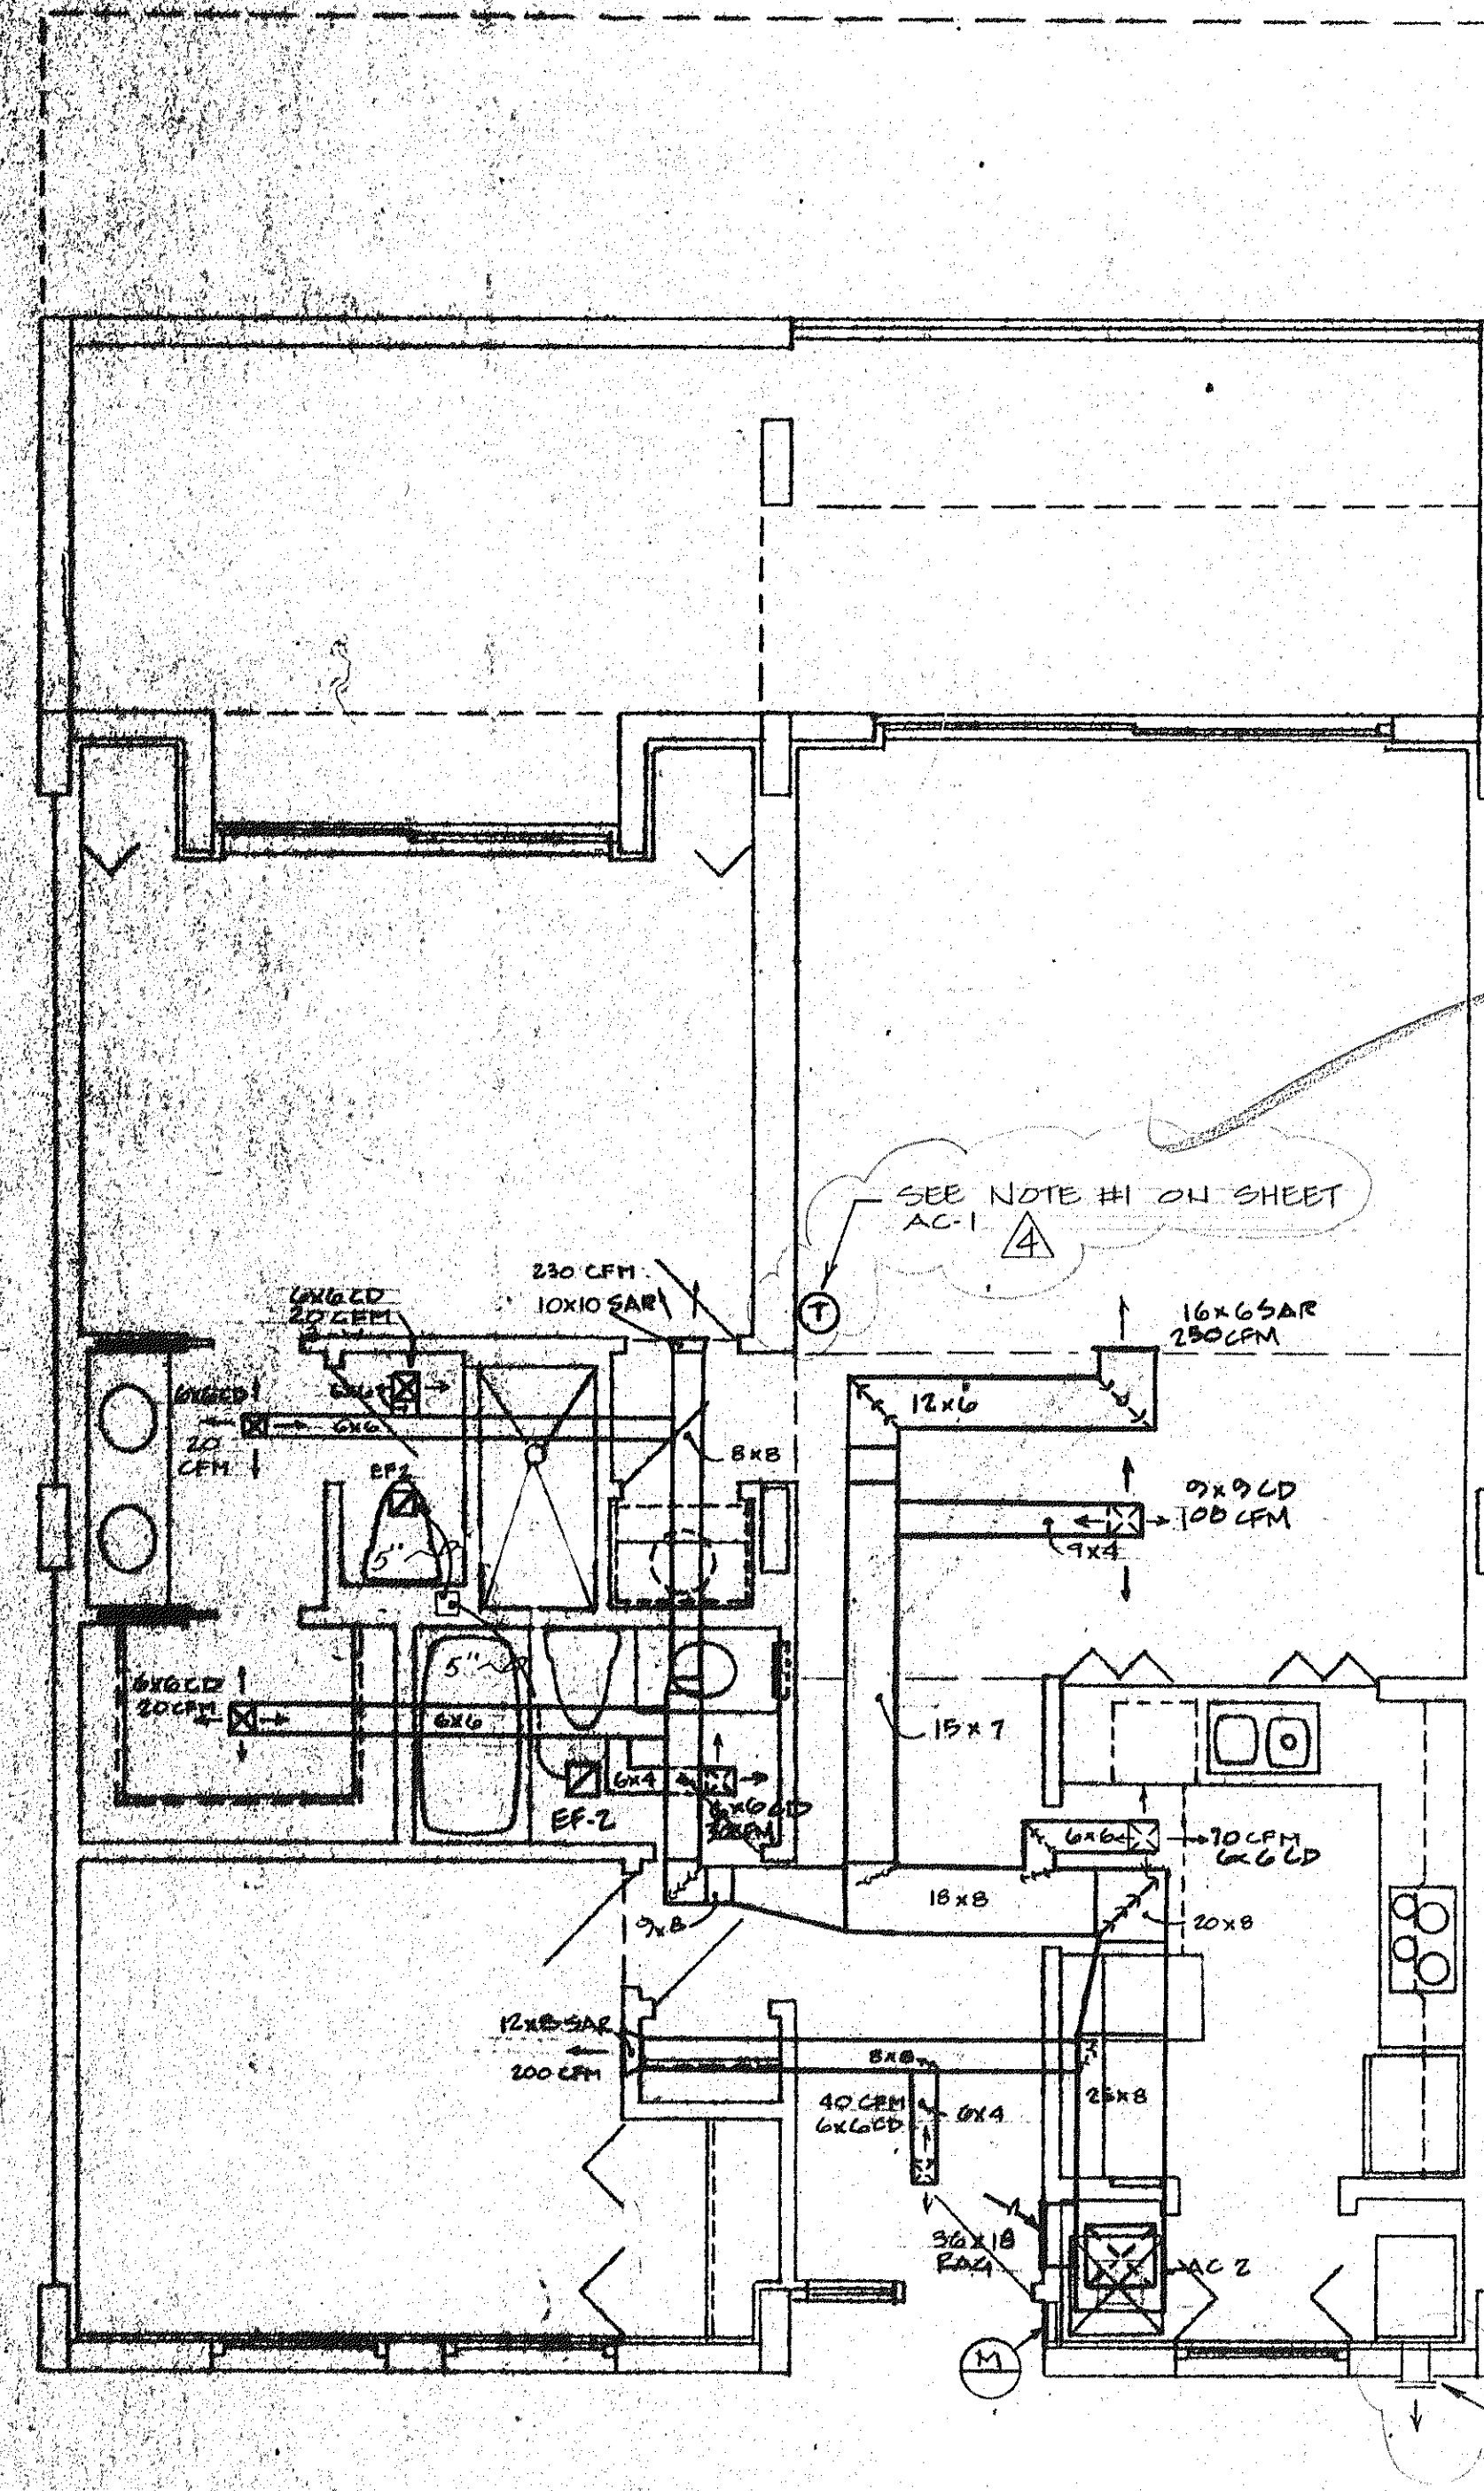

UNIT 'A' RIGHT - AIR CONDITIONING

ISSUED	2-17-85
REVISED	
DRYER VENT	7-22-85
AC-2	7-22-85
AC-1	7-22-85