


**UNIT 5 LEFT - AIR CONDITIONING**

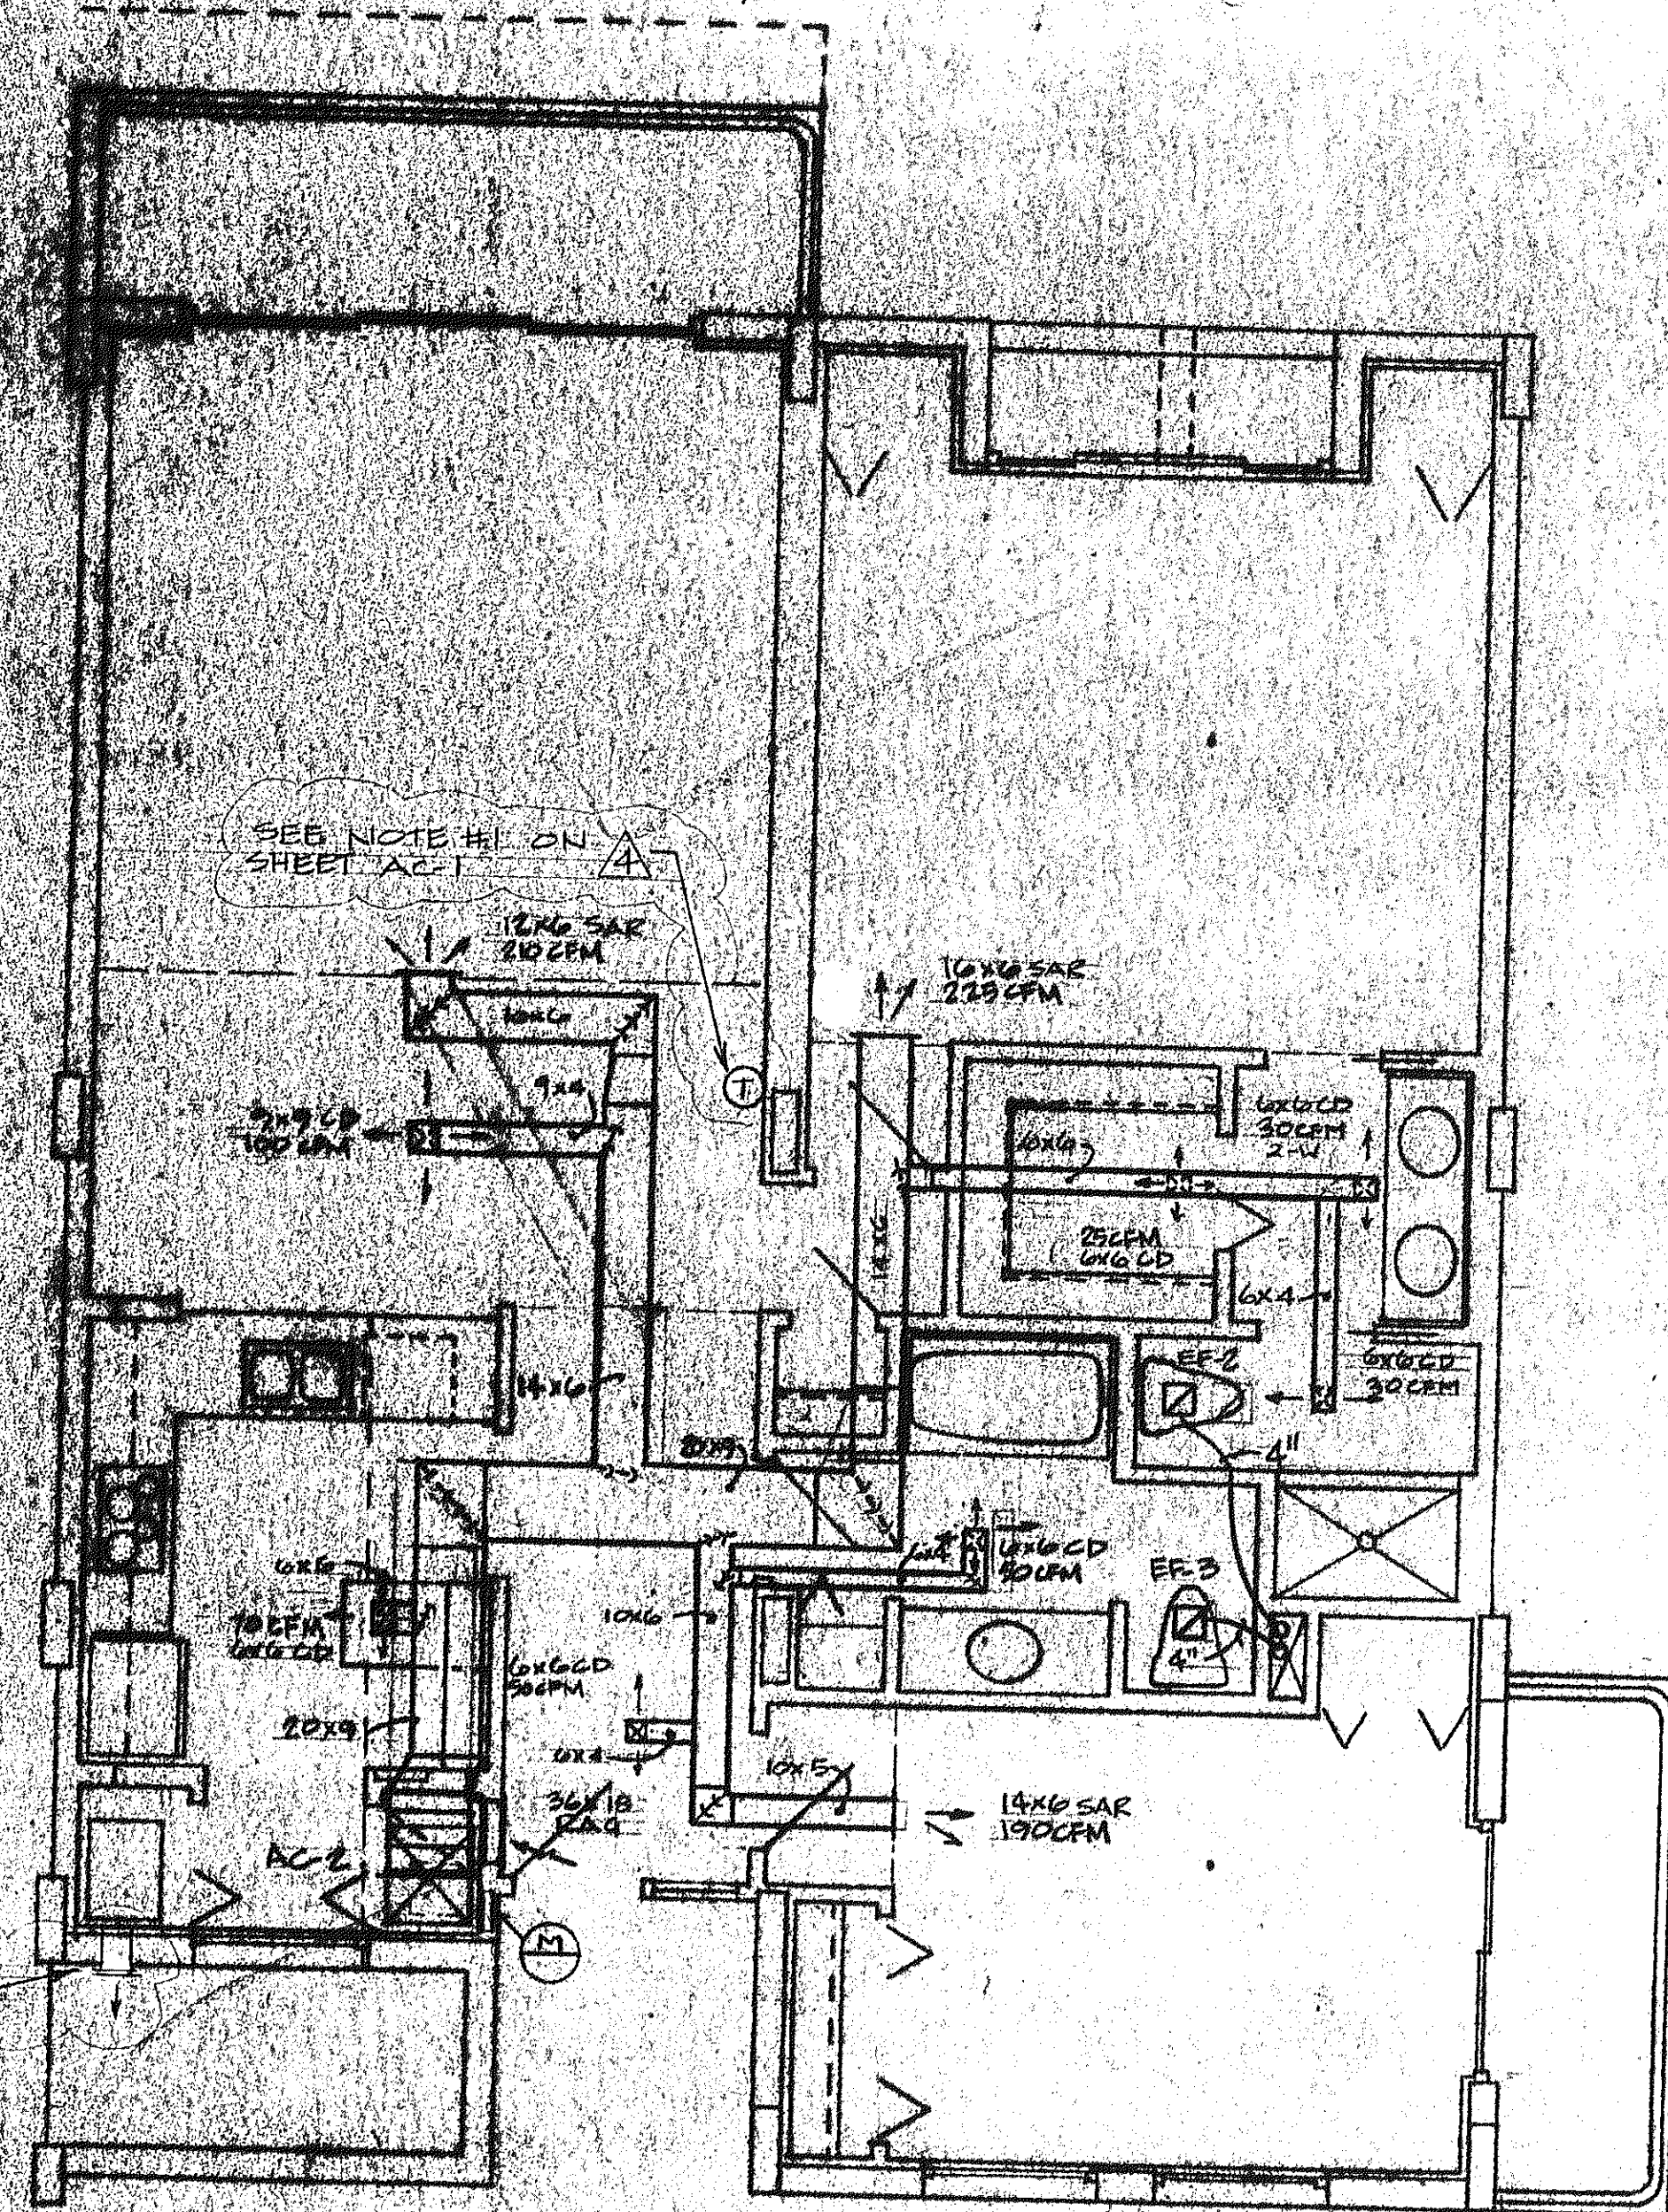

**UNIT 5 RIGHT - AIR CONDITIONING**

ISSUED	4/1/20
REVISED	
DATE	
BY	
REVISION	