


**UNIT B - LEFT - AIR CONDITIONING**

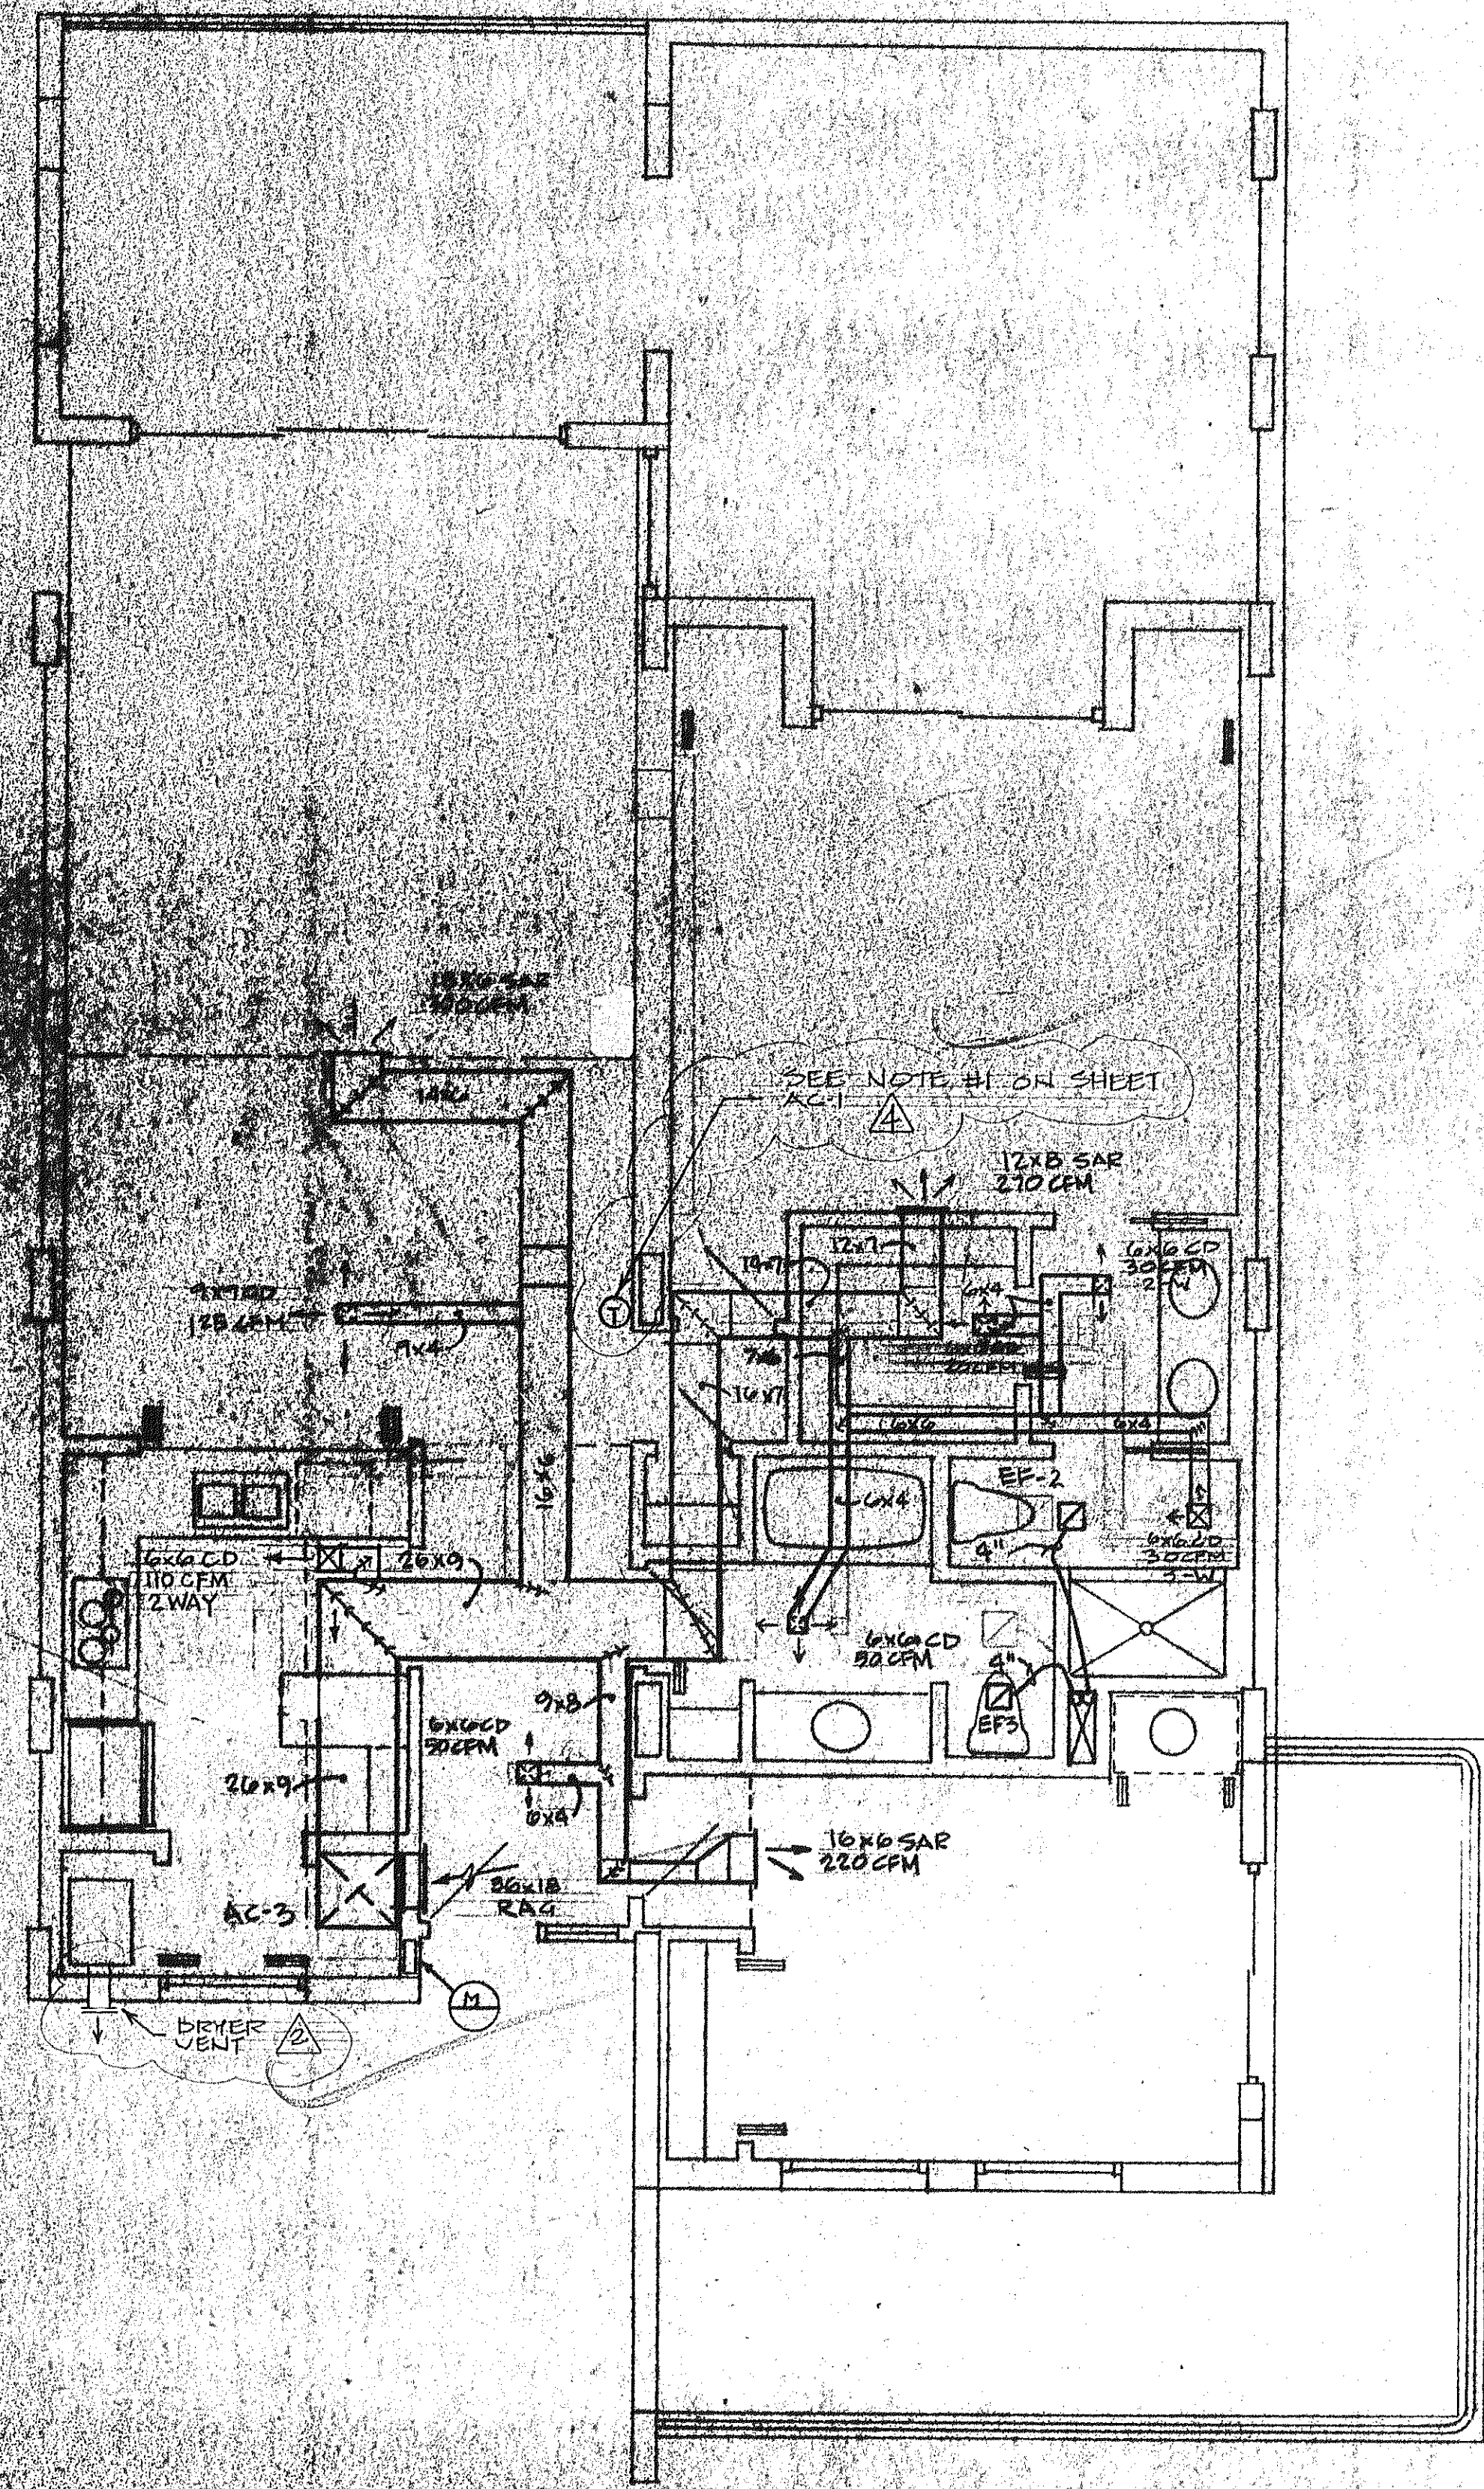

**UNIT C - RIGHT - AIR CONDITIONING**