


UNIT 'C' • LEFT- AIR CONDITIONING

scale: 1/4" = 1'-0"

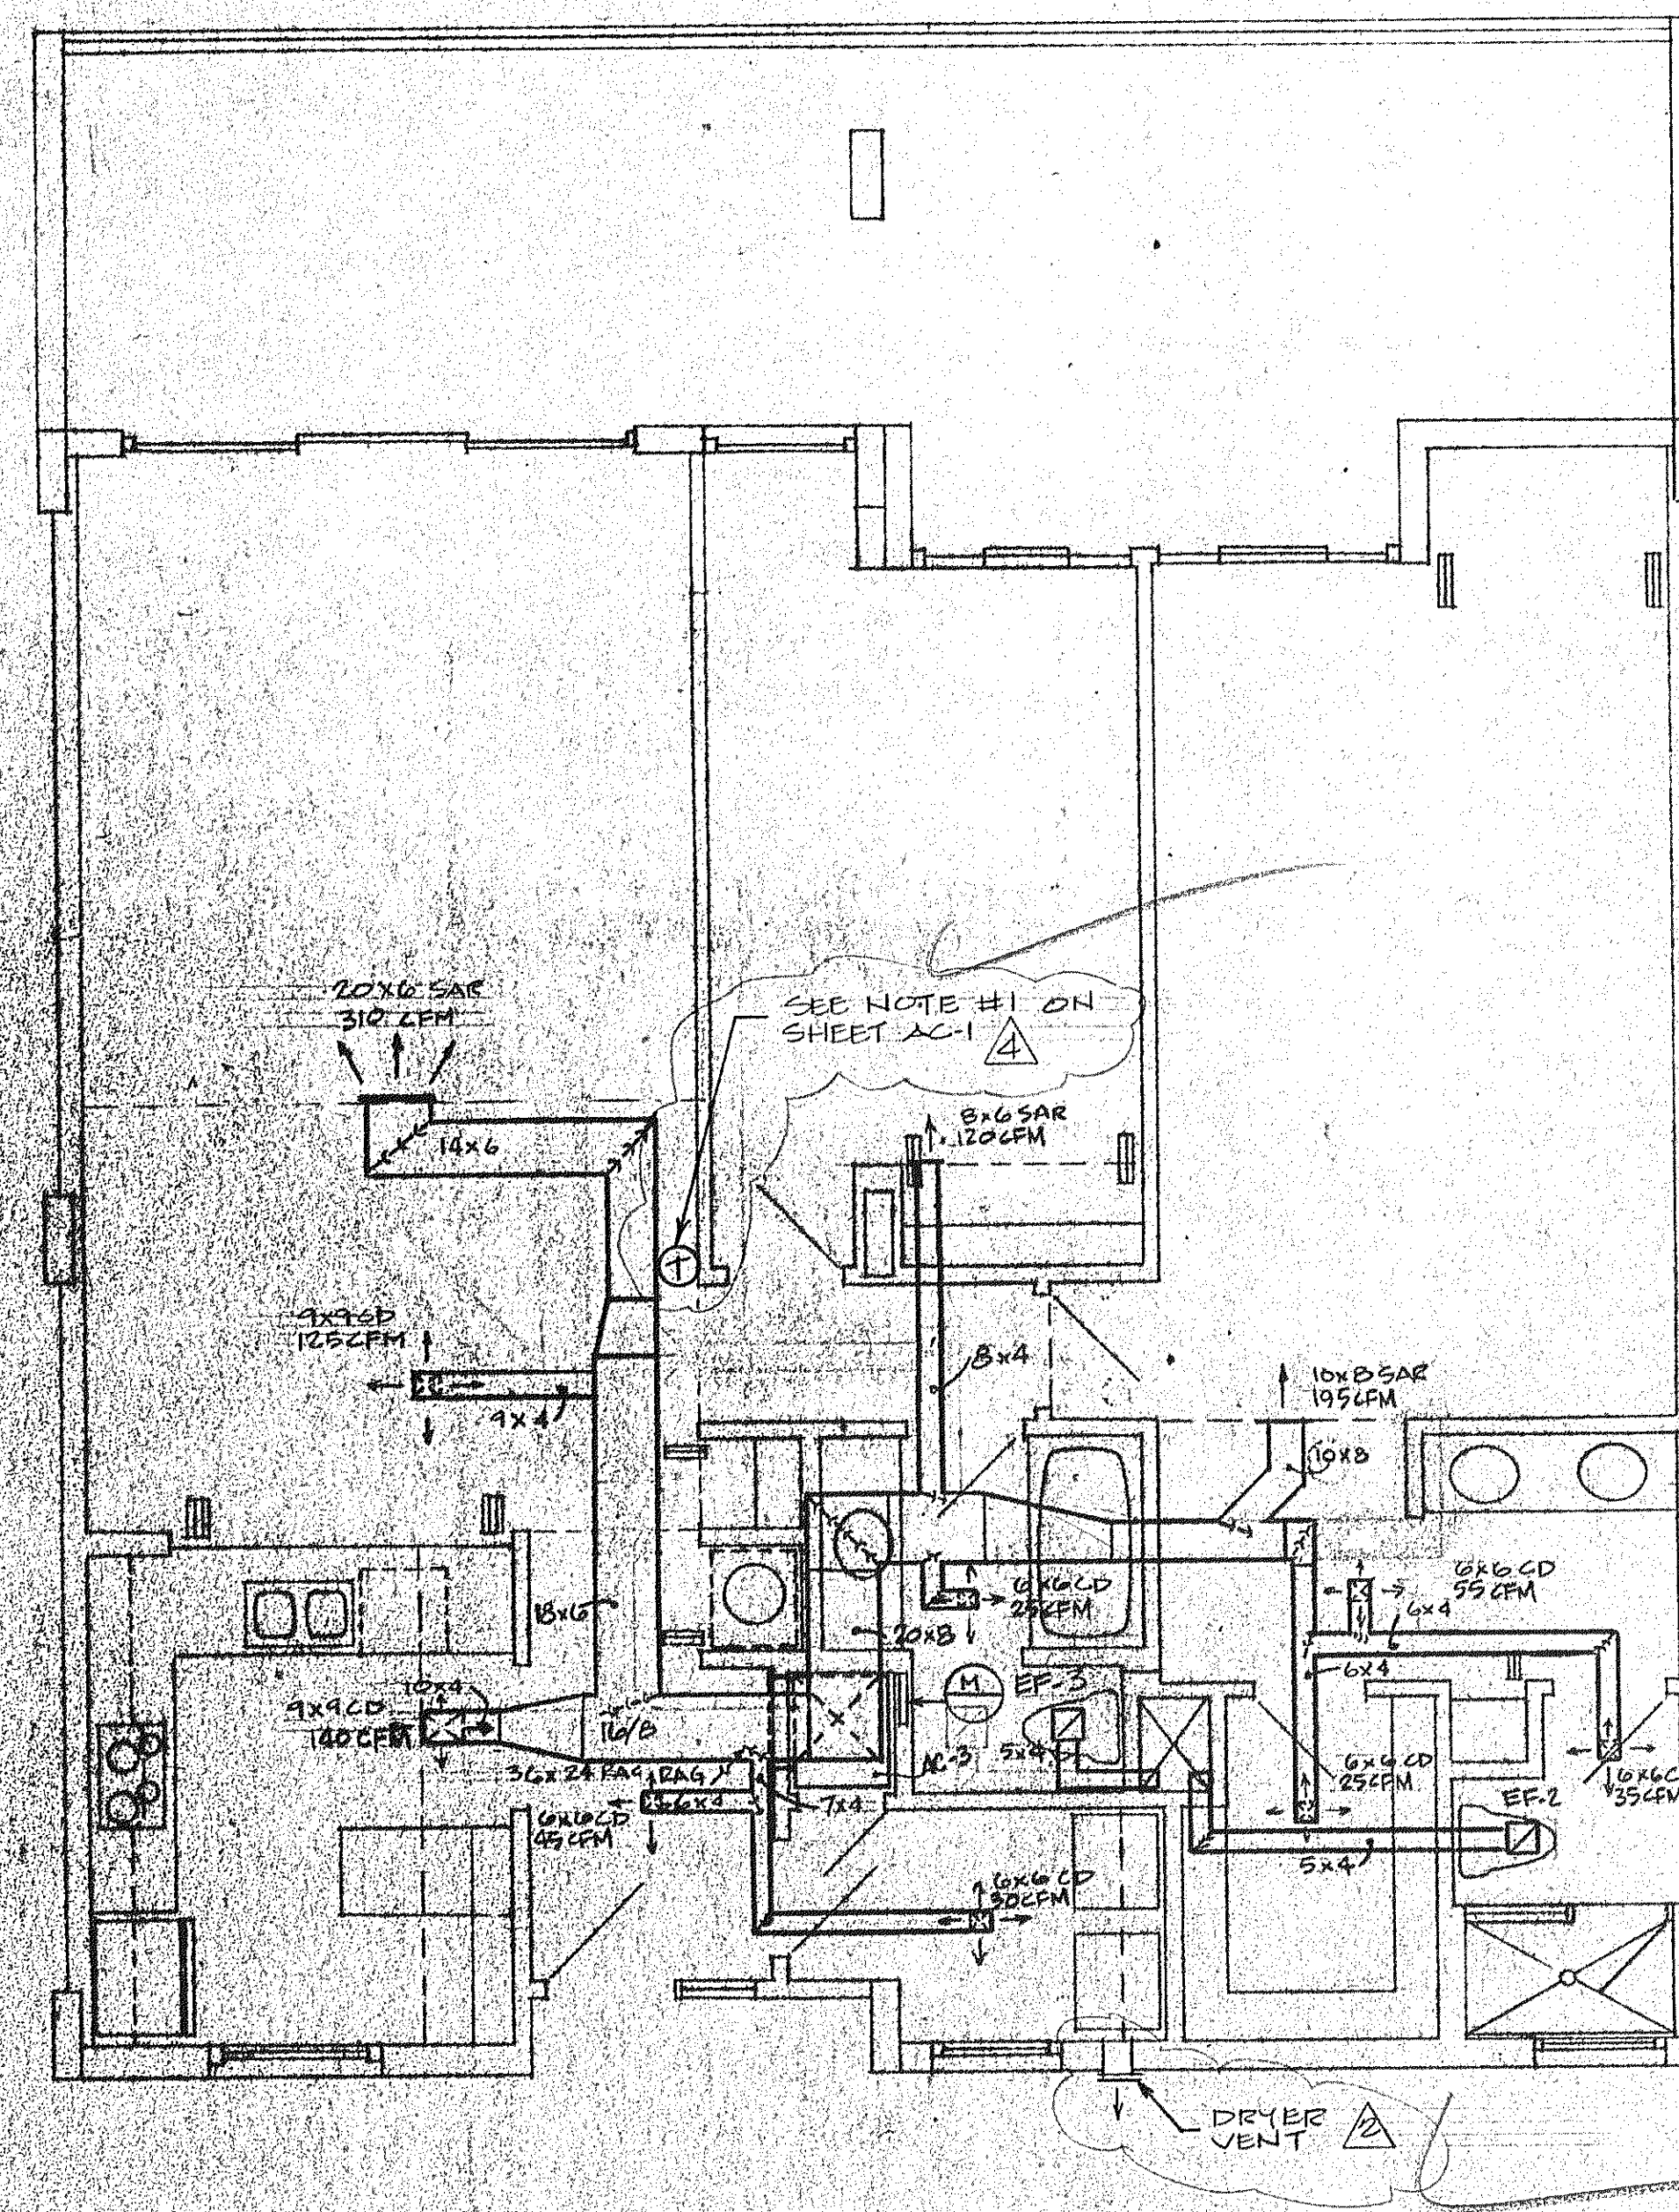

UNIT 'C' • RIGHT- AIR CONDITIONING

scale: 1/4" = 1'-0"

ISSUED	4-17
REVISED	
DRYER VENT	7-22-23
ACCESSIBILITY	ERTS 9-15-23