

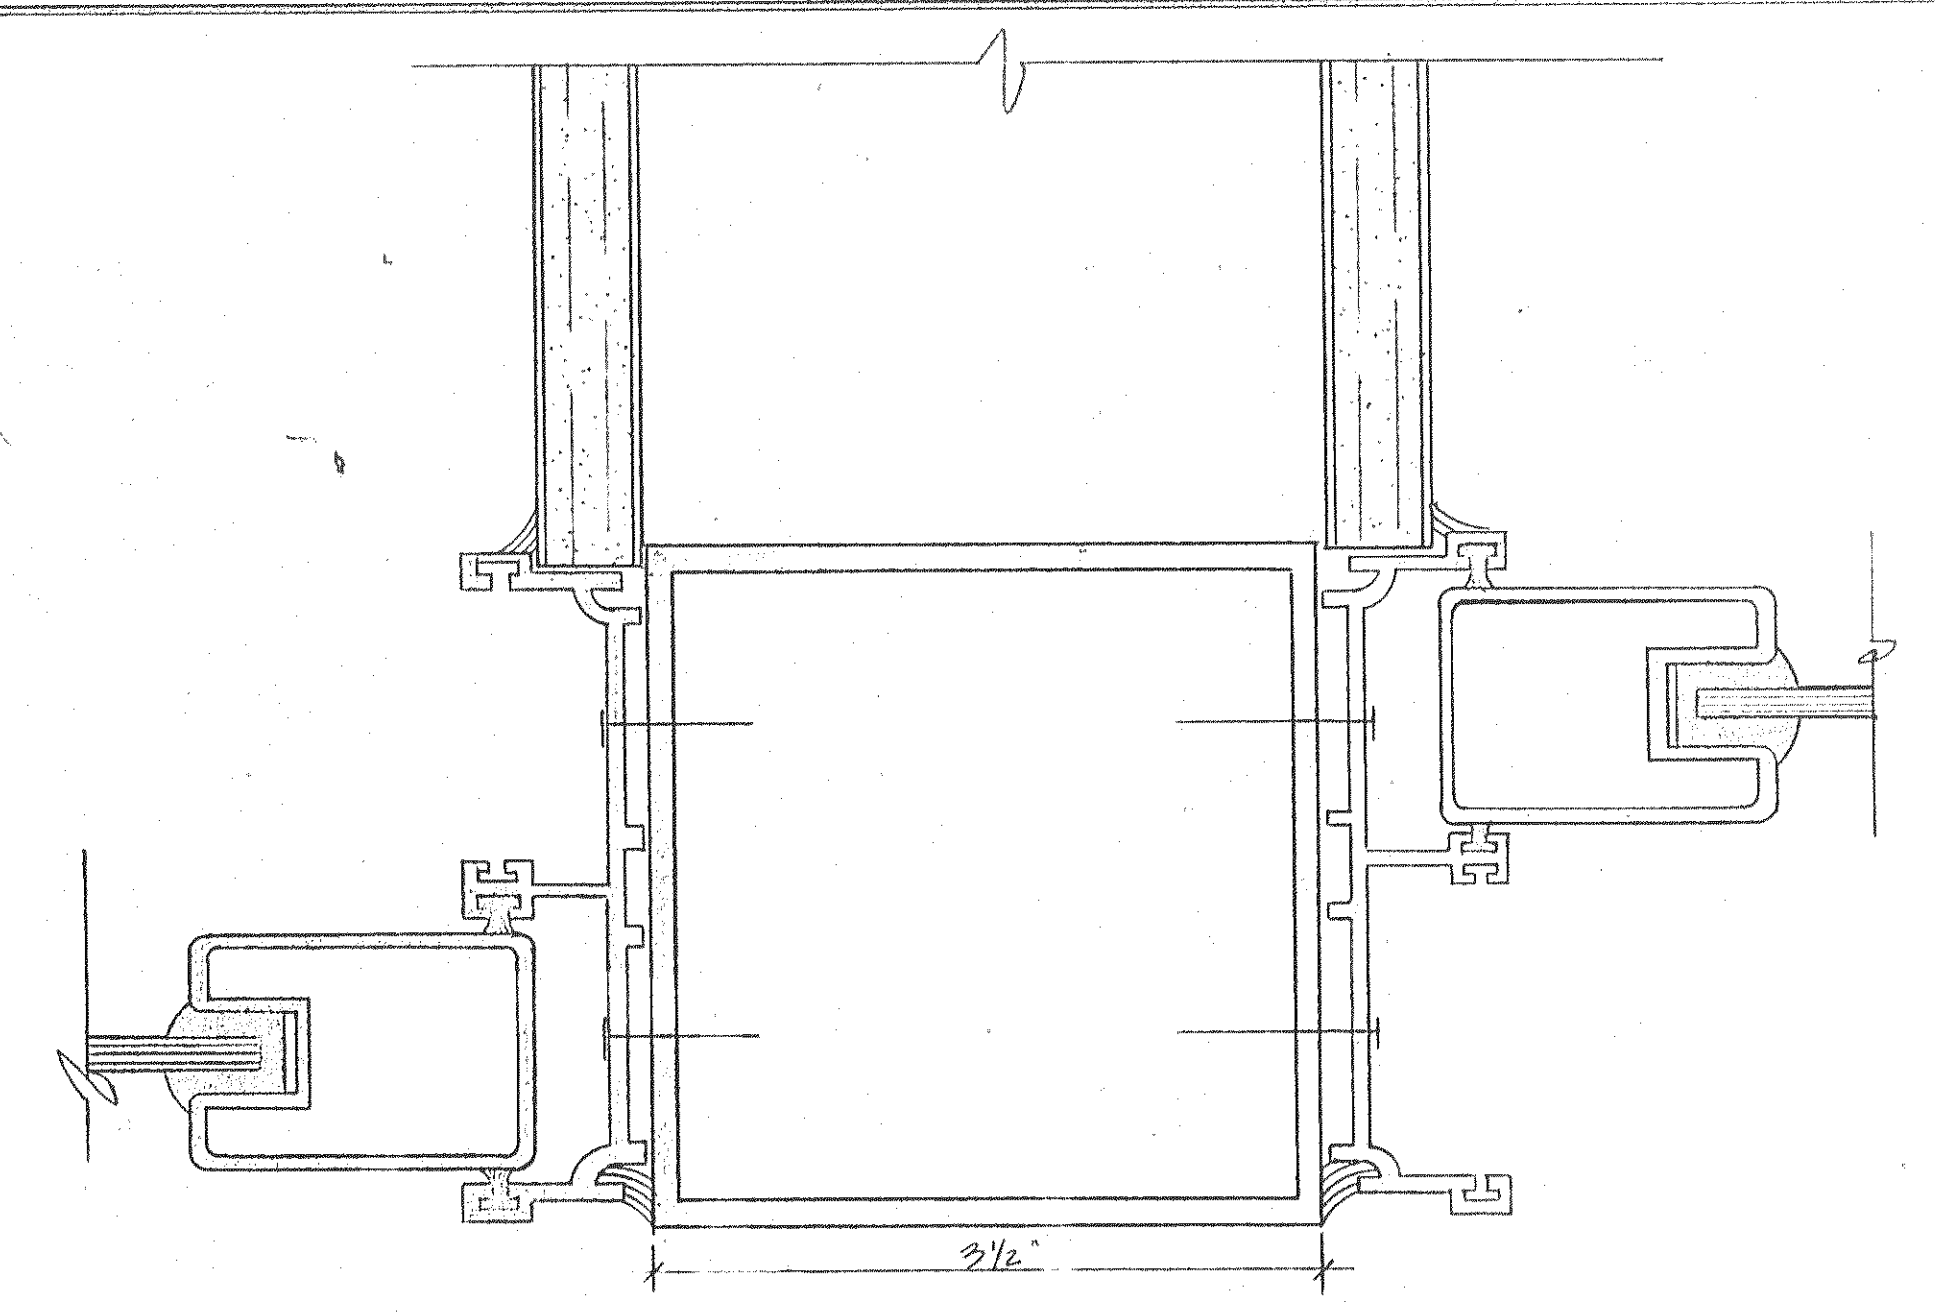
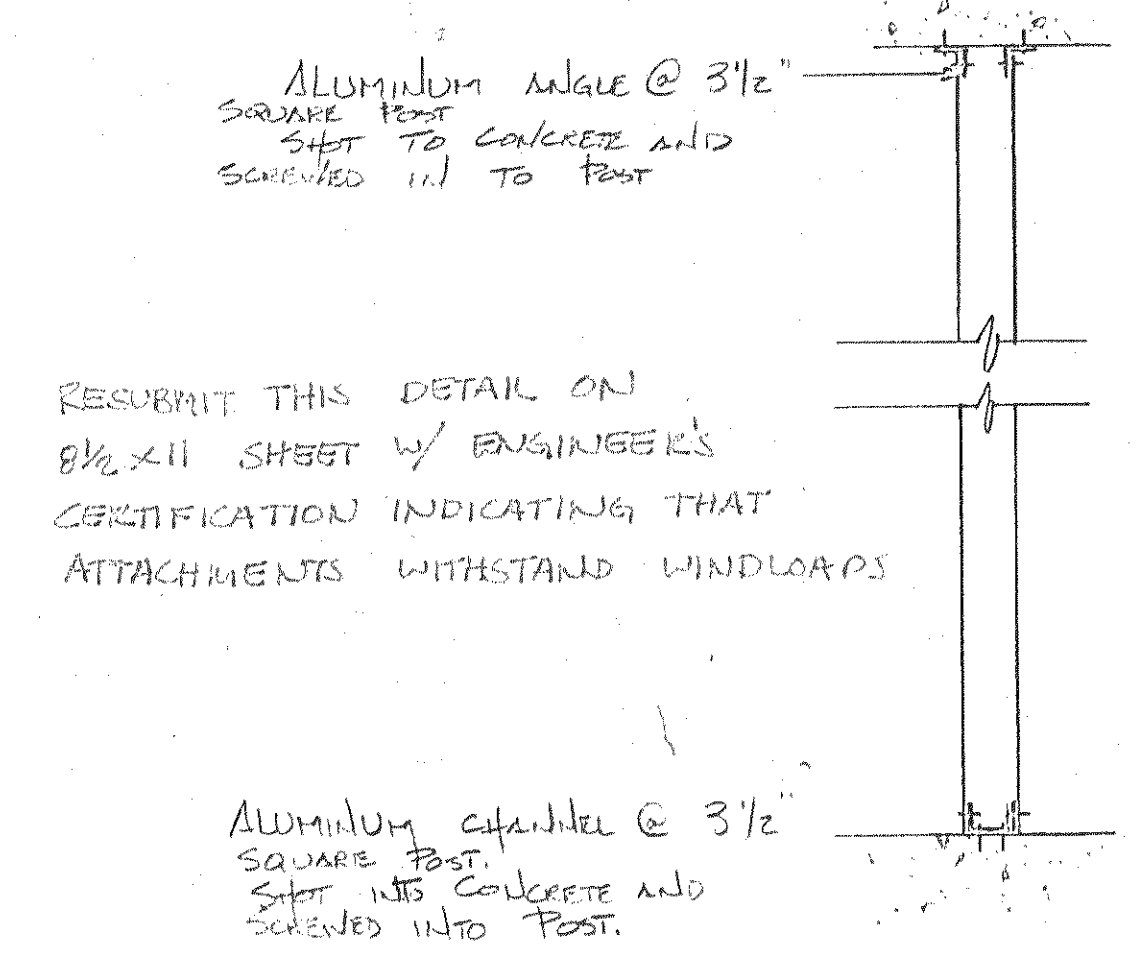


EXTERIOR

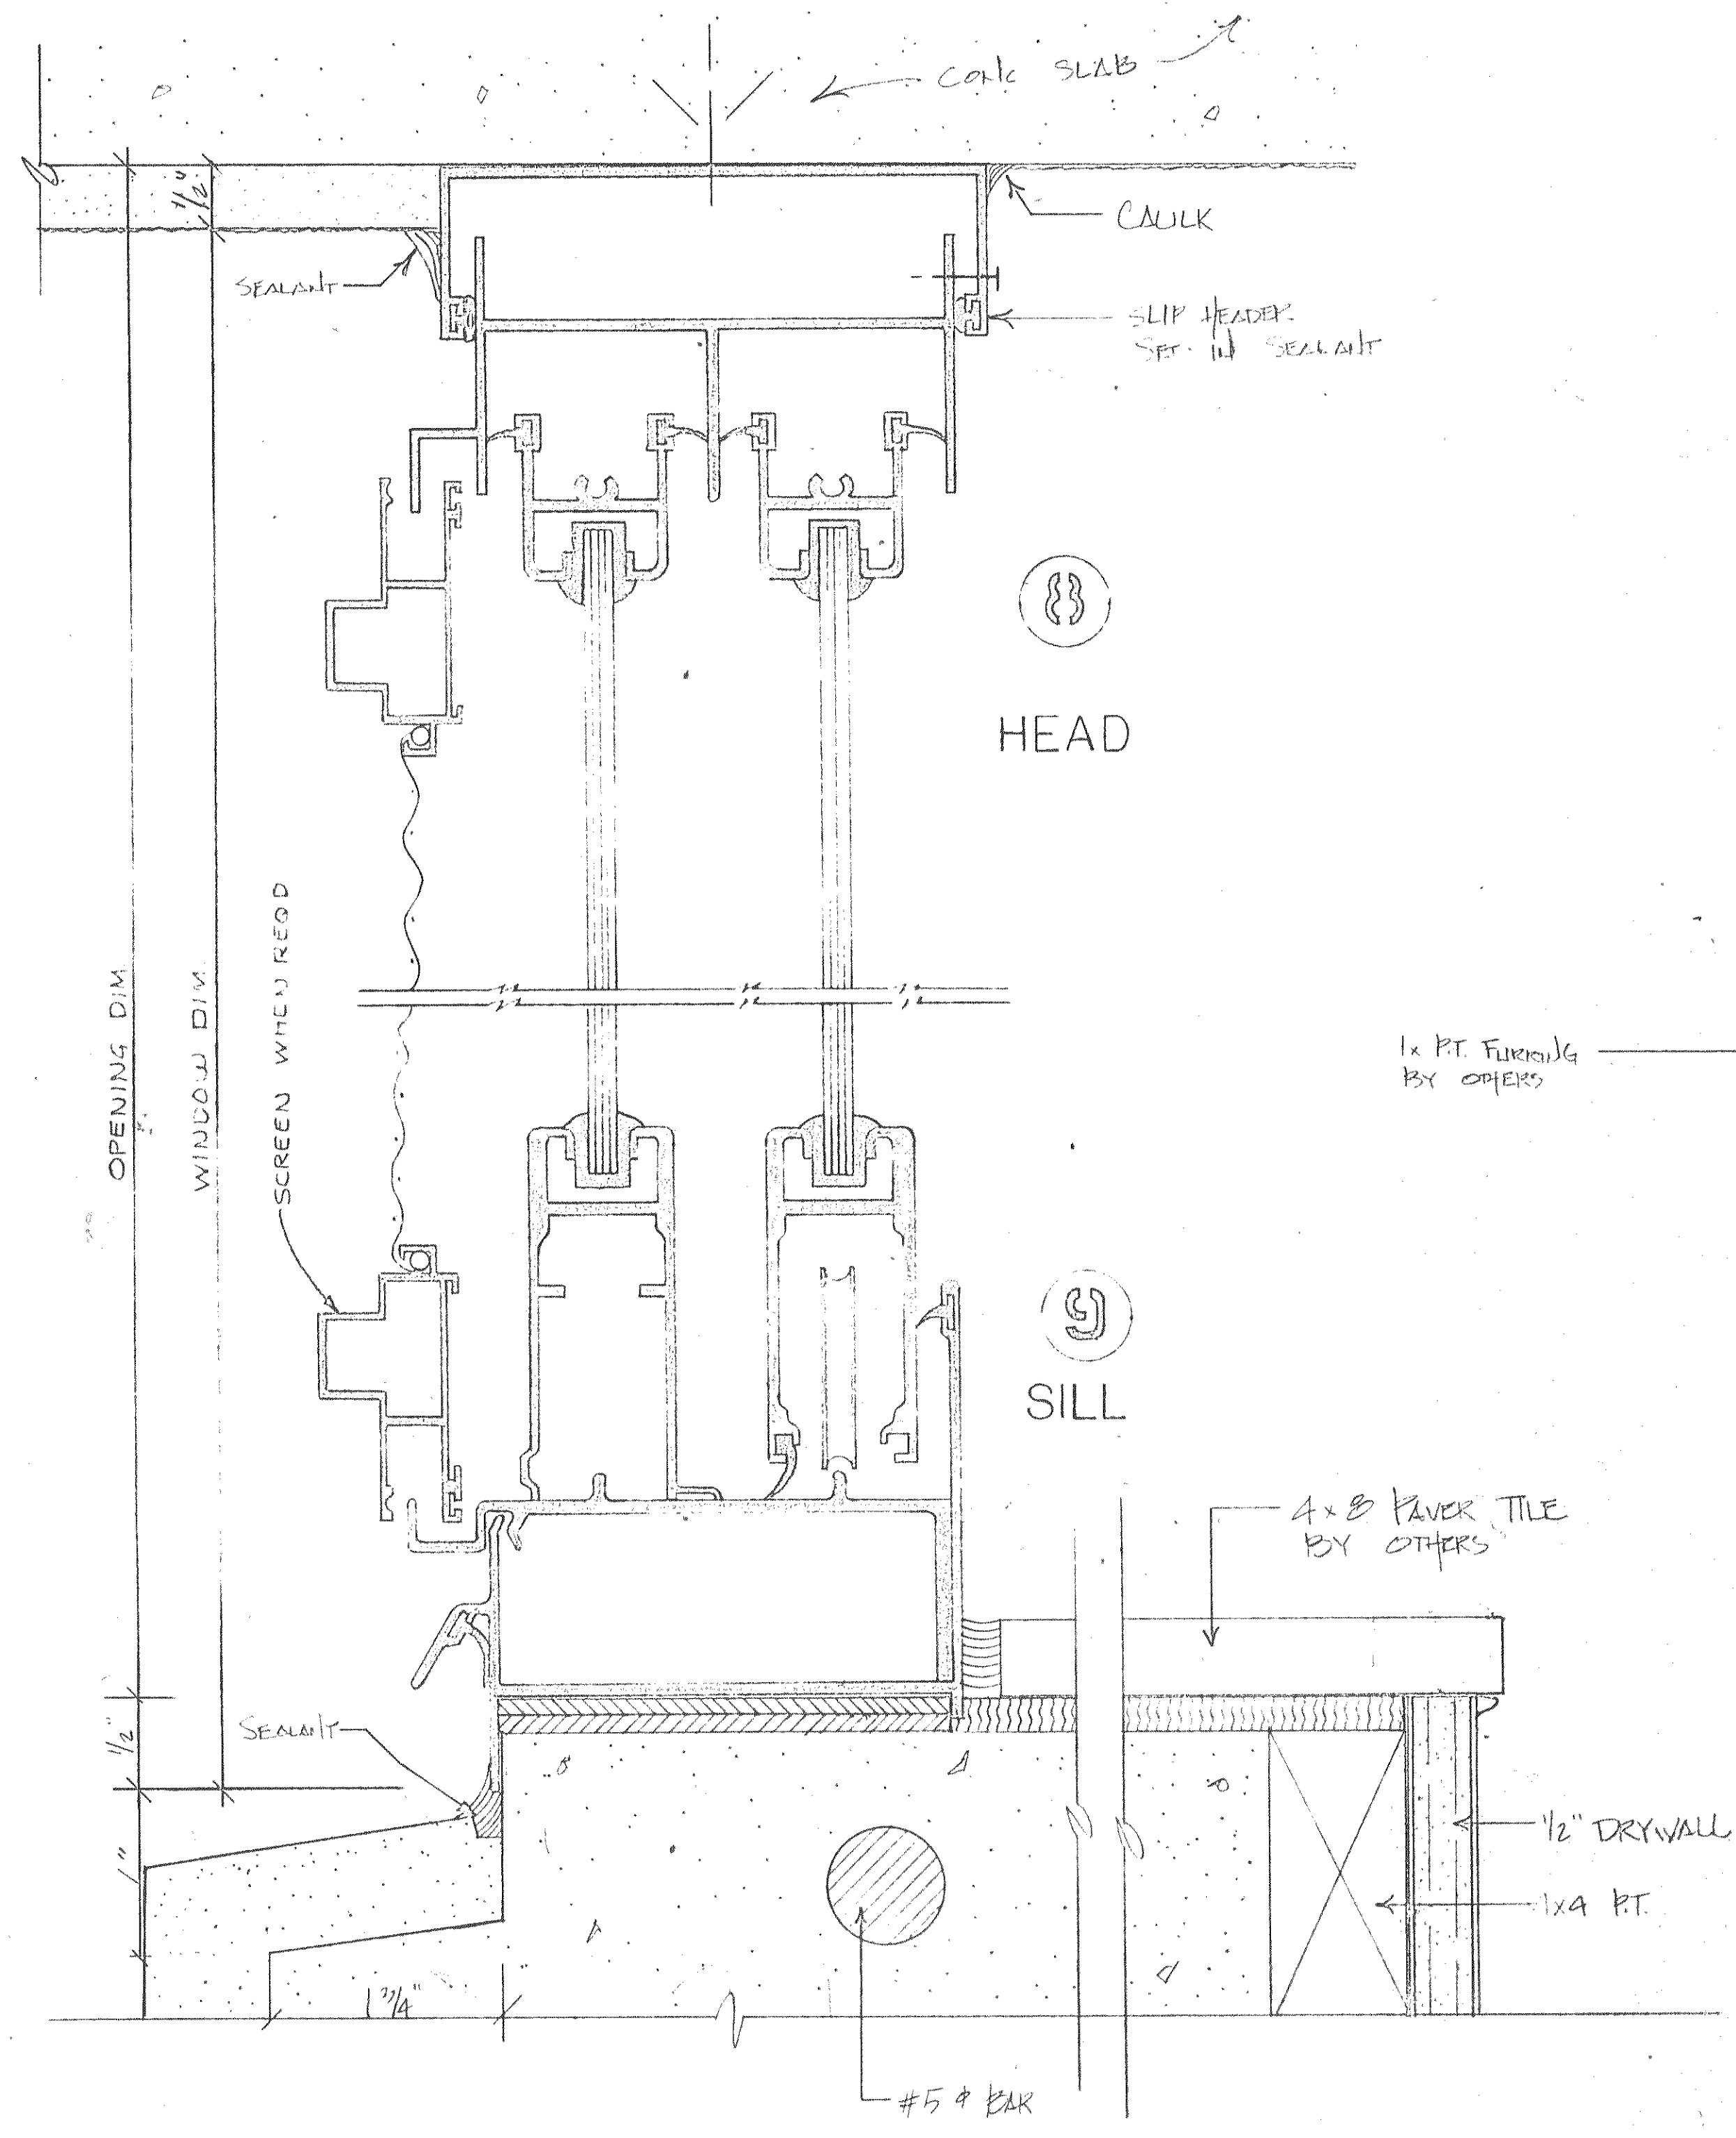

20

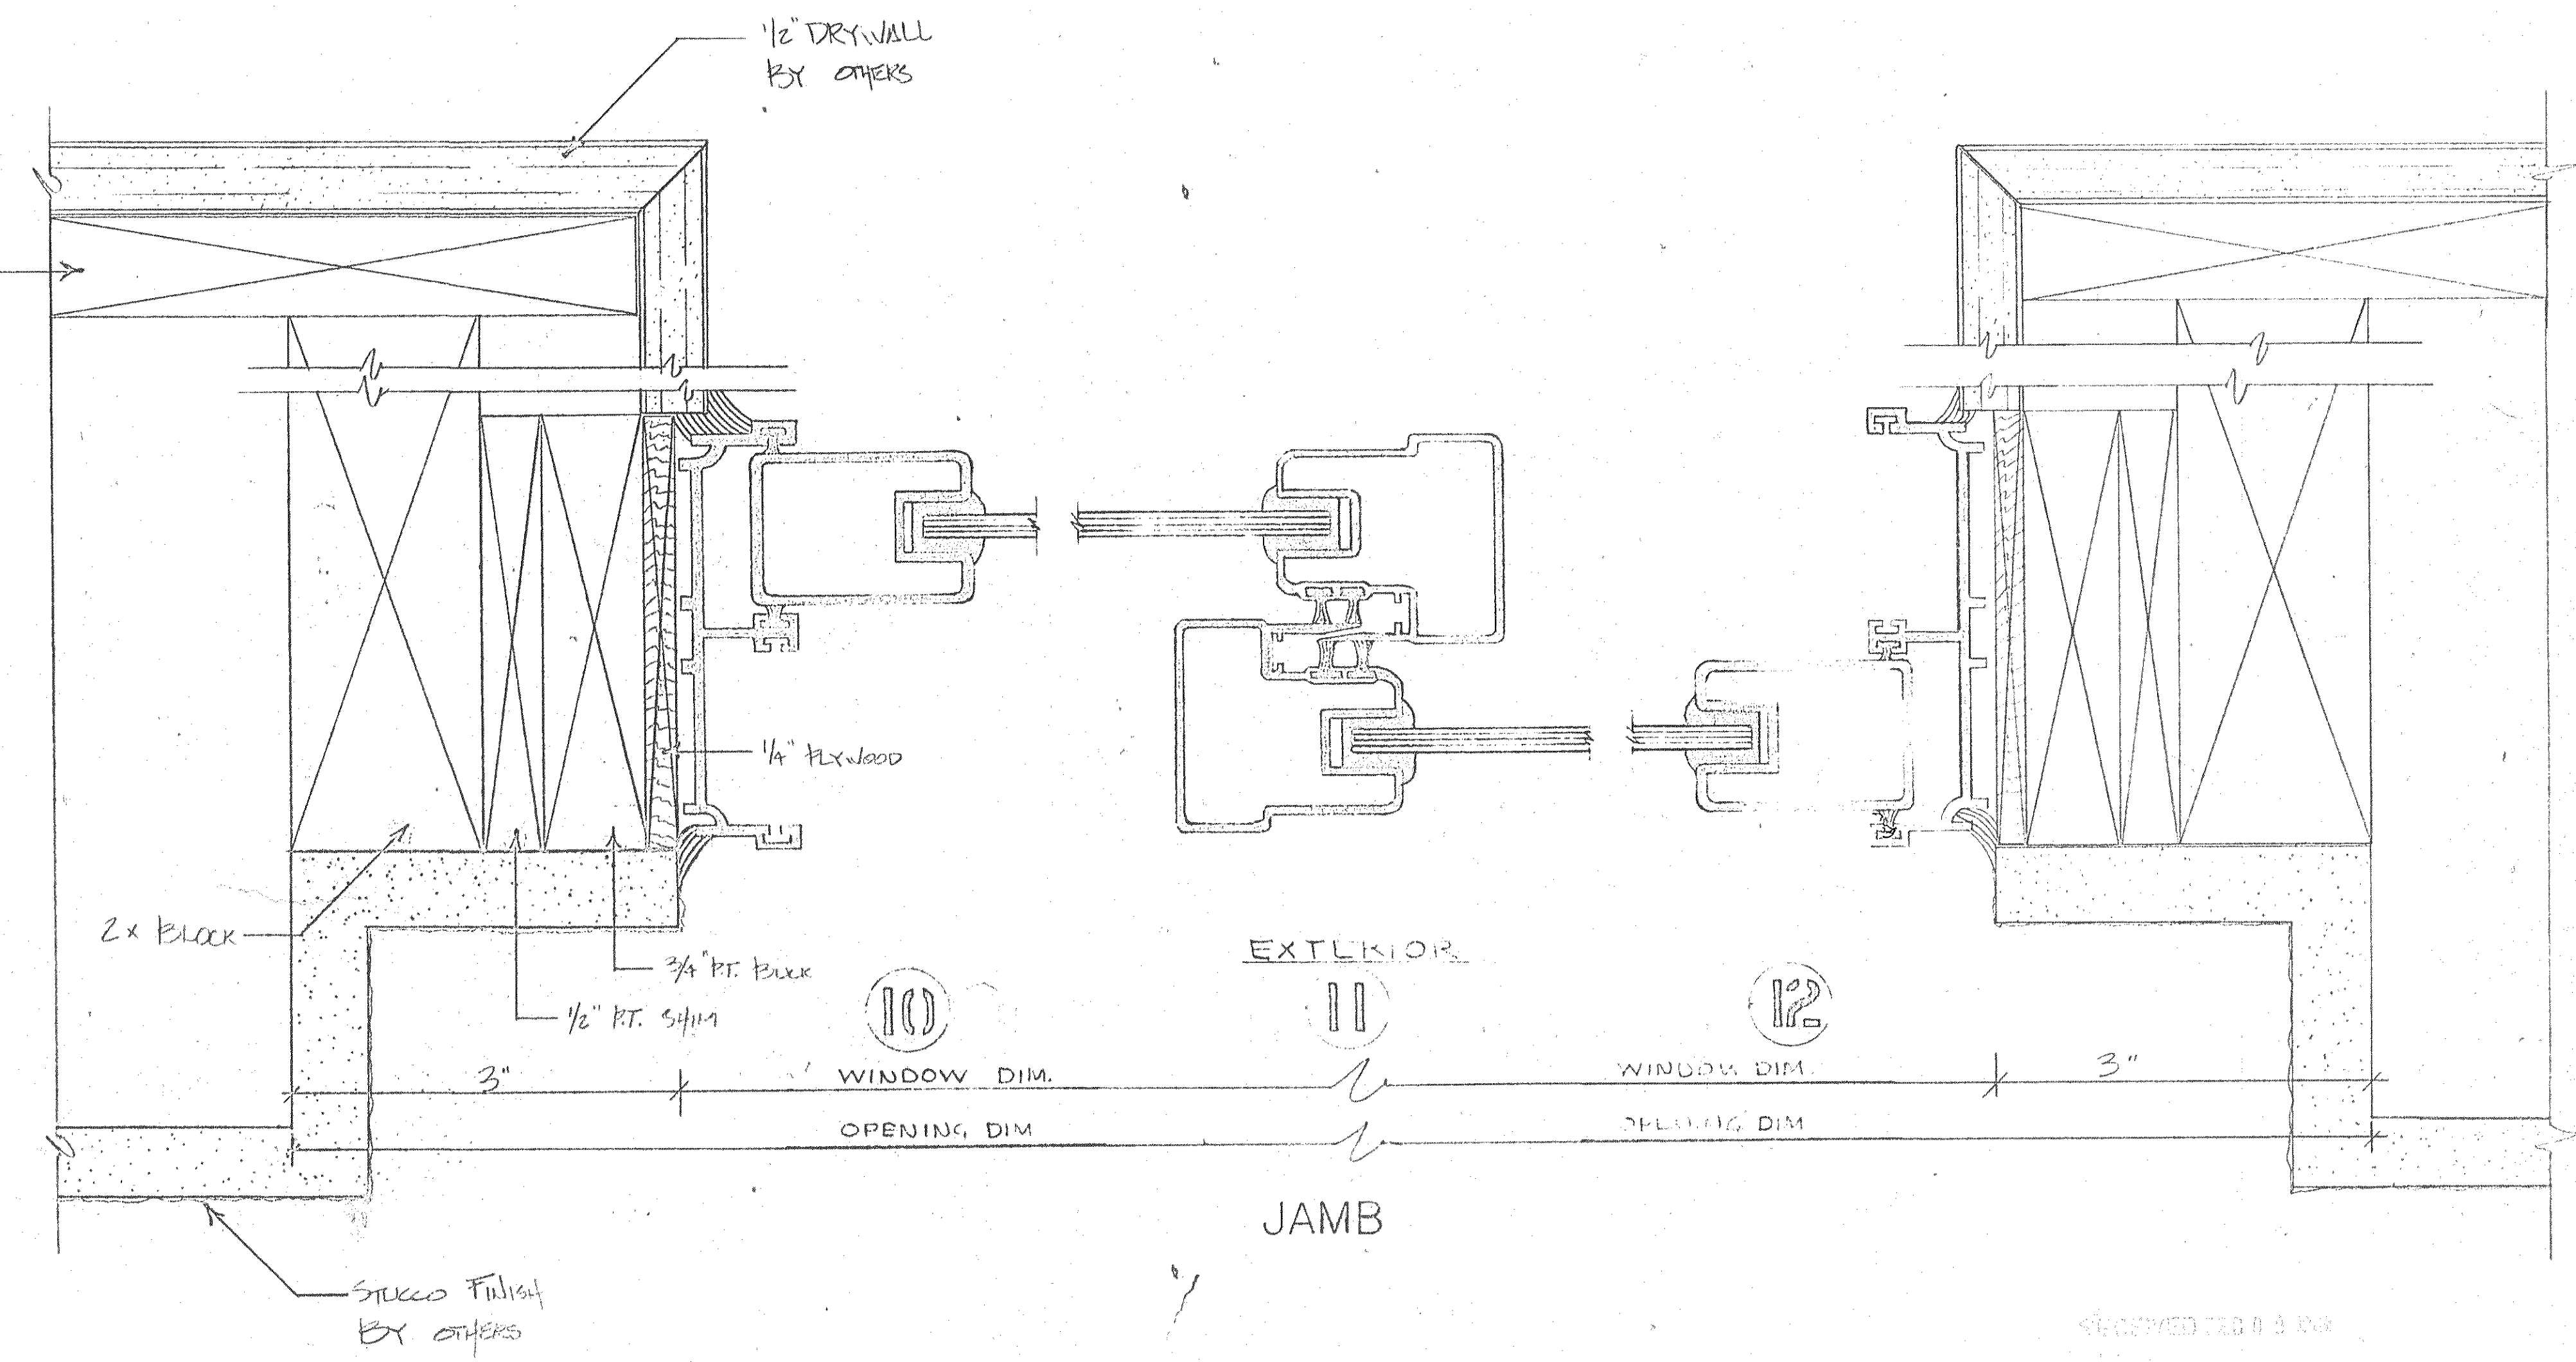

10

11

12

SUBMISSION		REVISION			
No.	Date	No.	Description	Date	By
		1	PER ARCHITECT COMMENTS	1/20/83	V.B.
		2	PER ARCHITECTS REVISIONS	1/20/83	V.B.

I.M. Products Co.
 621 N.W. 27th Ave. • Fort Lauderdale, Florida 33309
 COMPANY 305-561-4431 • FAX 305-561-1128 • PALM BEACH, FL 33408

Project Title: **SUNSET BEACH**
 LONG BOAT KEY, FLORIDA

Contractor: _____ Project No.: _____

Drawing Title: **SLIDING WINDOW DETAILS**

Scale: FULL SIZE | Drawn By: I.V.B. | Date: 12-2-83 | Chkd. By: _____ | Date: _____ | Sheet No.: 13 of 14