


SLAB NOTES  
SLAB THICKNESS = 8" (EXCEPT WHERE NOTED ON TOP STEEL SHT.)  
CONCRETE STRENGTH = 4000 P.S.I.  
REINFORCING STEEL GRADE = A615-60  
PLACEMENT NOTES & DETAILS = SHT. # 5-14  
(+) BARS ARE ADD BARS & ARE IN ADDITION TO GRID REINF. SHOWN ON PLAN

REFERENCE NOTES  
COLUMN SCHEDULE = SHT. # 5-15  
SHEARWALL SCHEDULE = SHT. # 5-16  
BEAM SCHEDULE = SHT. # 5-17

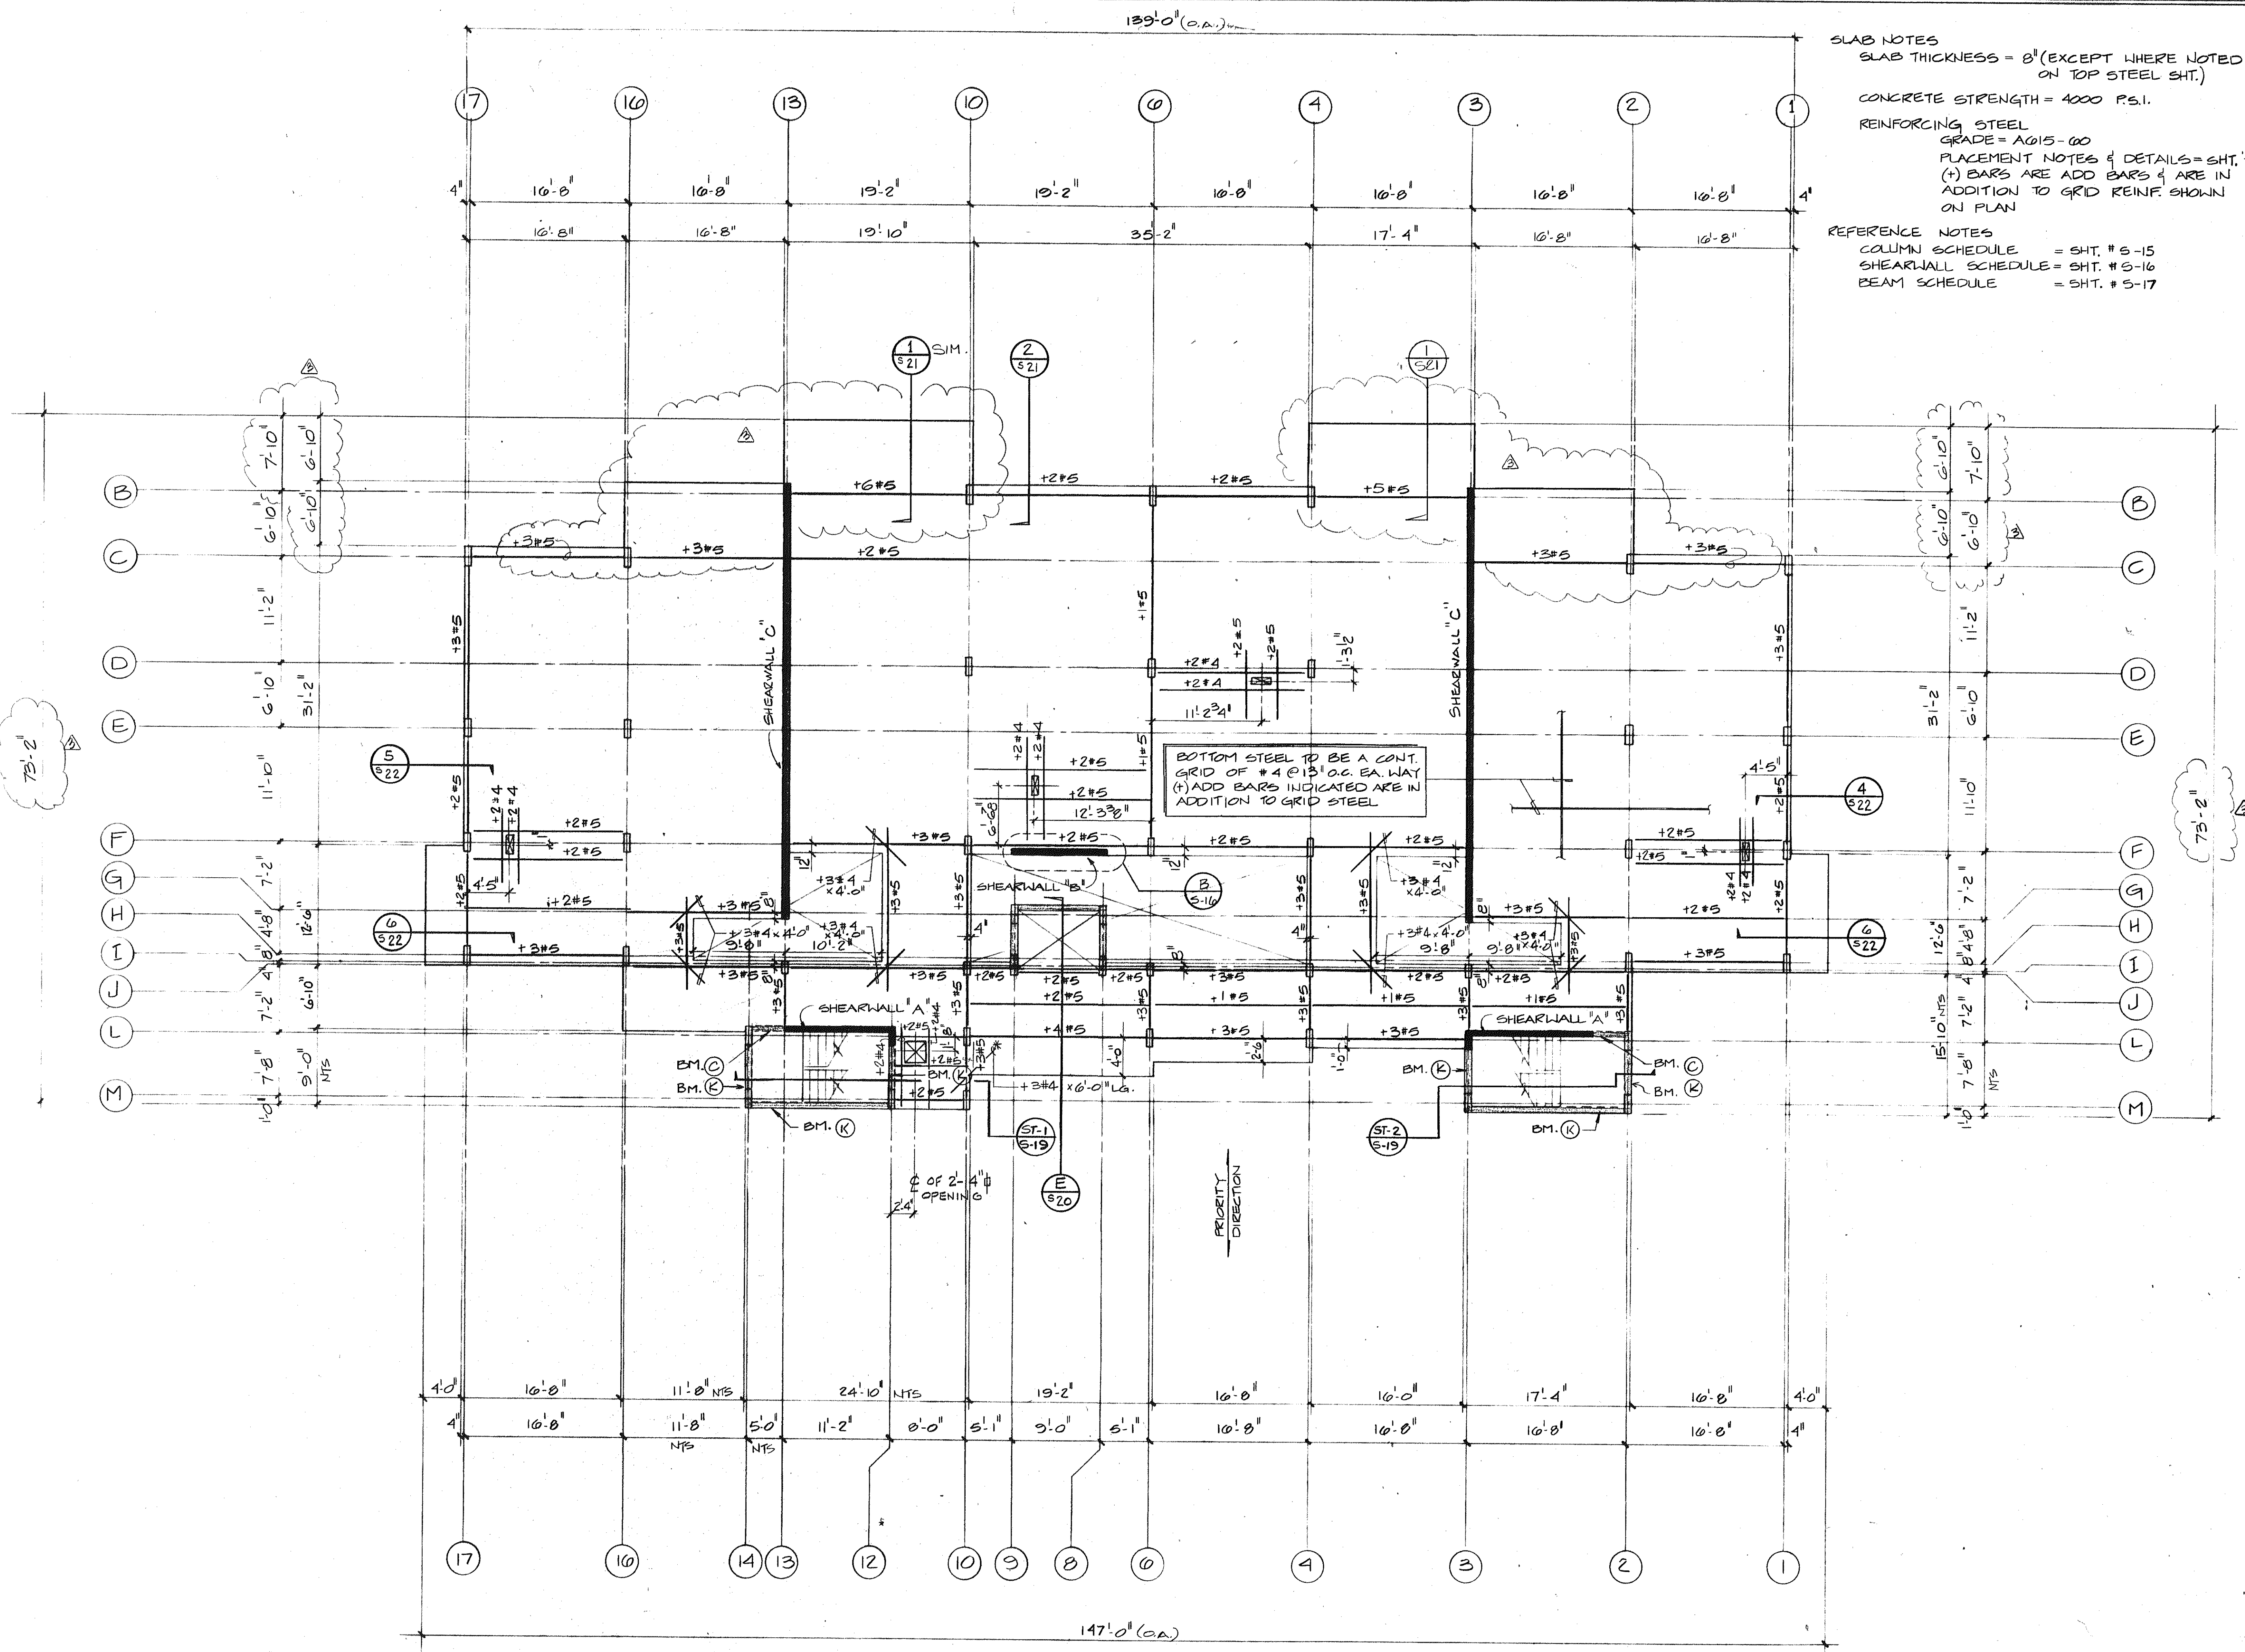

ARVIDA CORPORATION, EDWARD J. SEIBERT, ARCHITECT & PLANNER, P.A., THE SVA GROUP, BRABHAM, KUHNS, DEBAY CONSULTING ENGINEERS, OLSEN, WHITE & ASSOCIATES, STRUCTURAL ENGINEERS, BENNETT & BISHOP, INC. CONSULTING ENGINEERS & SURVEYORS