



OVERLAYS
 25-00 COMPOSITE
 04-64
 05-65

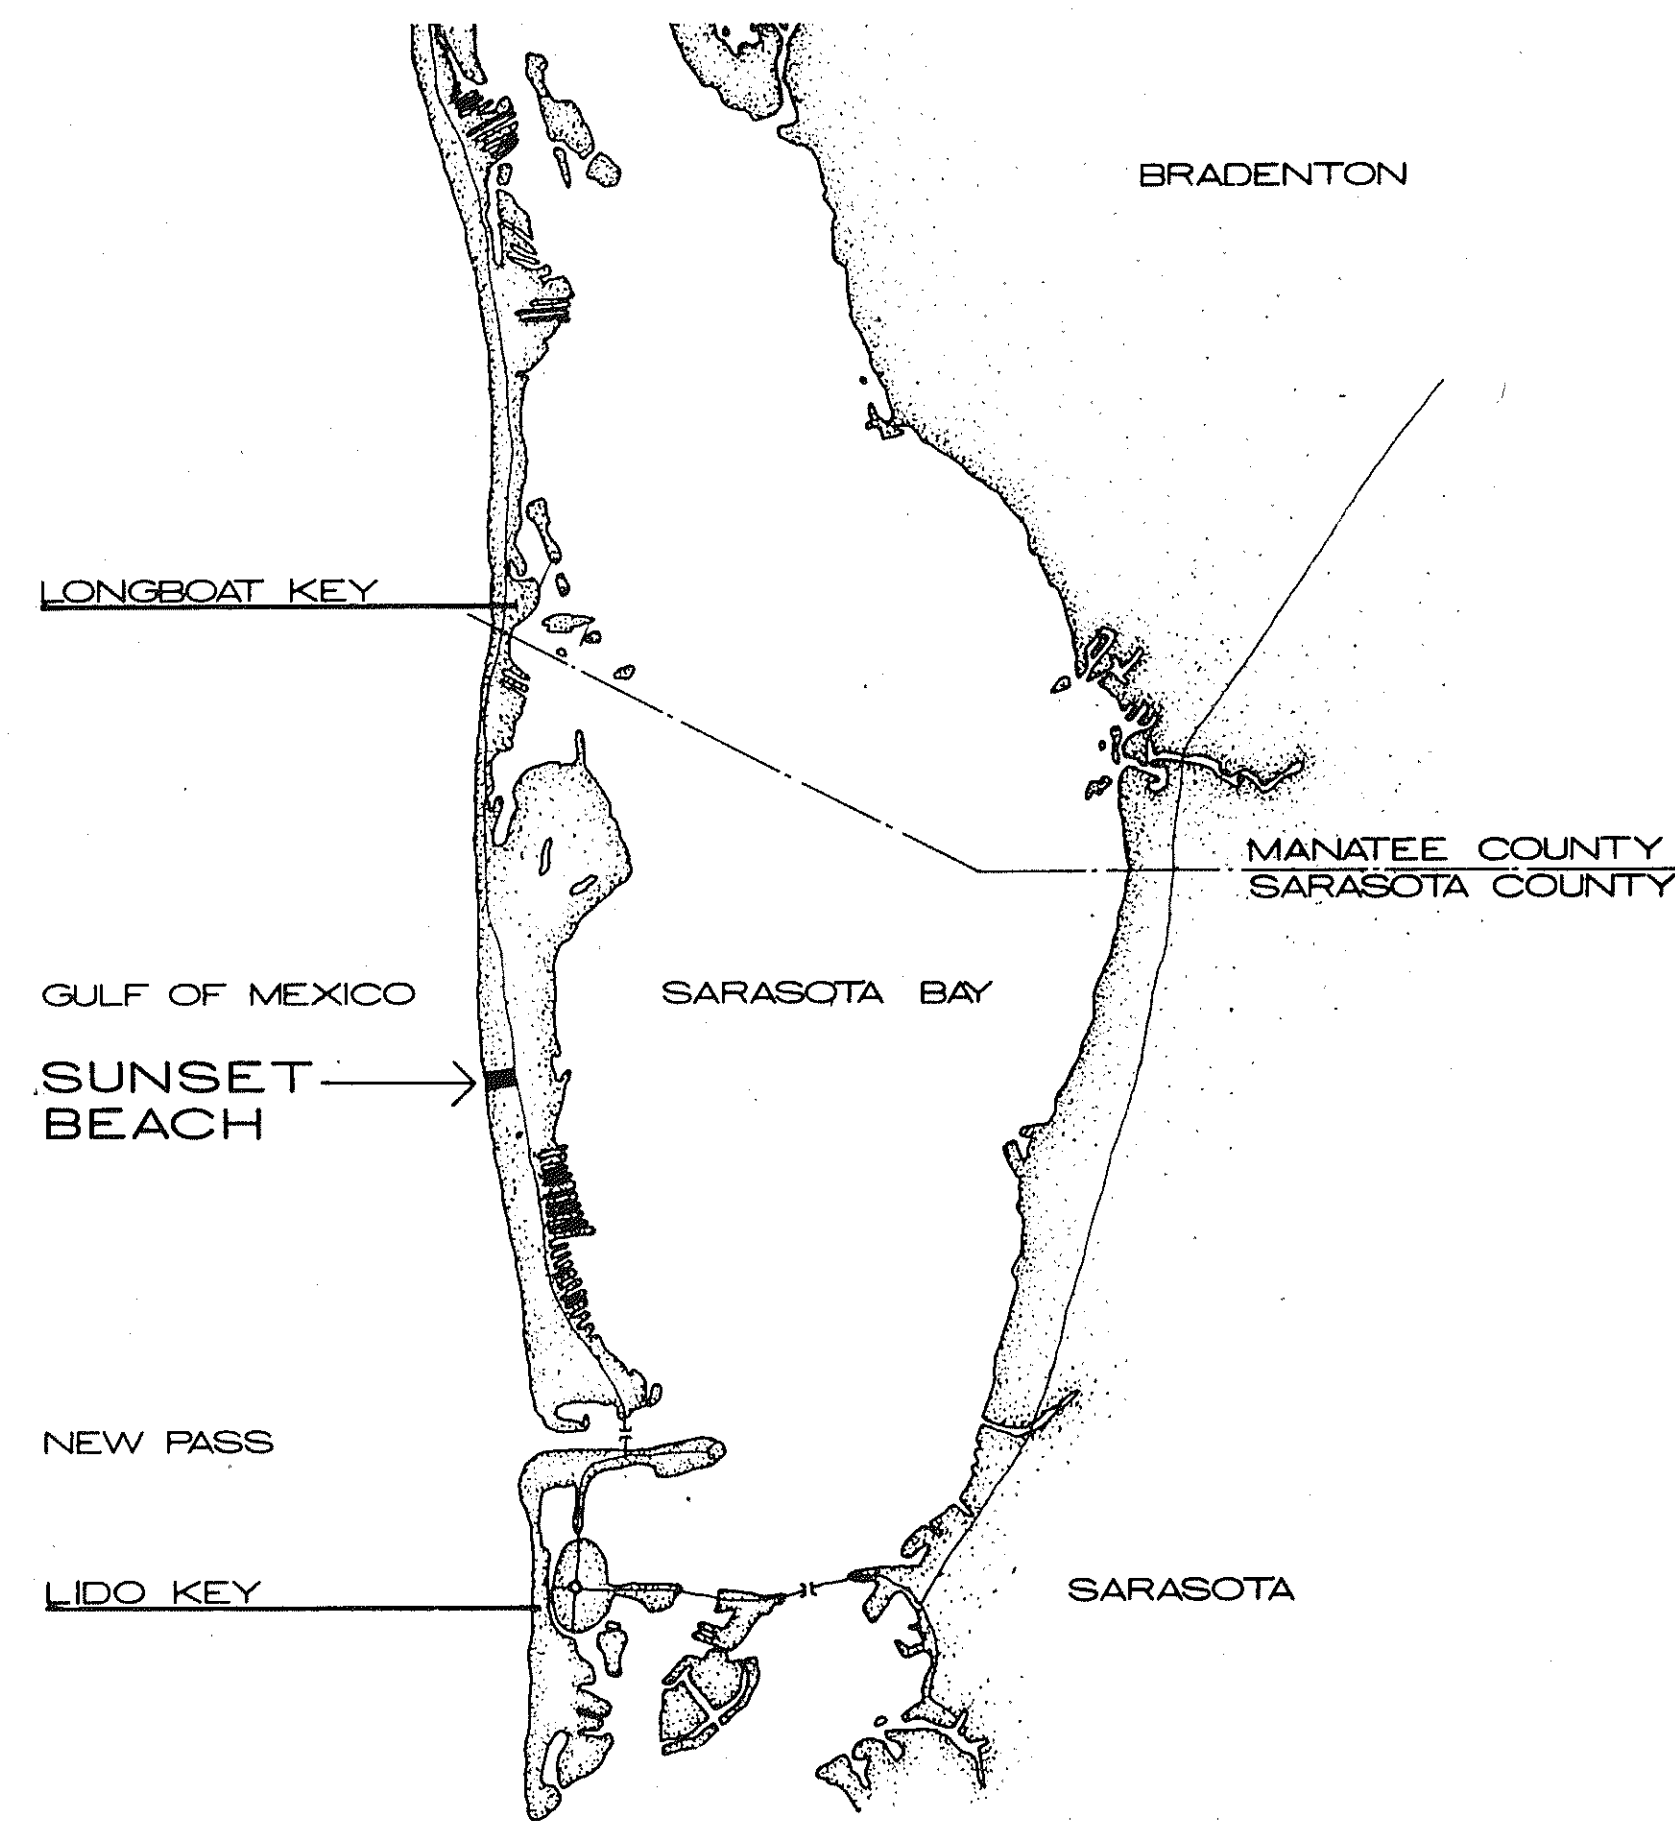


LOCATION MAP

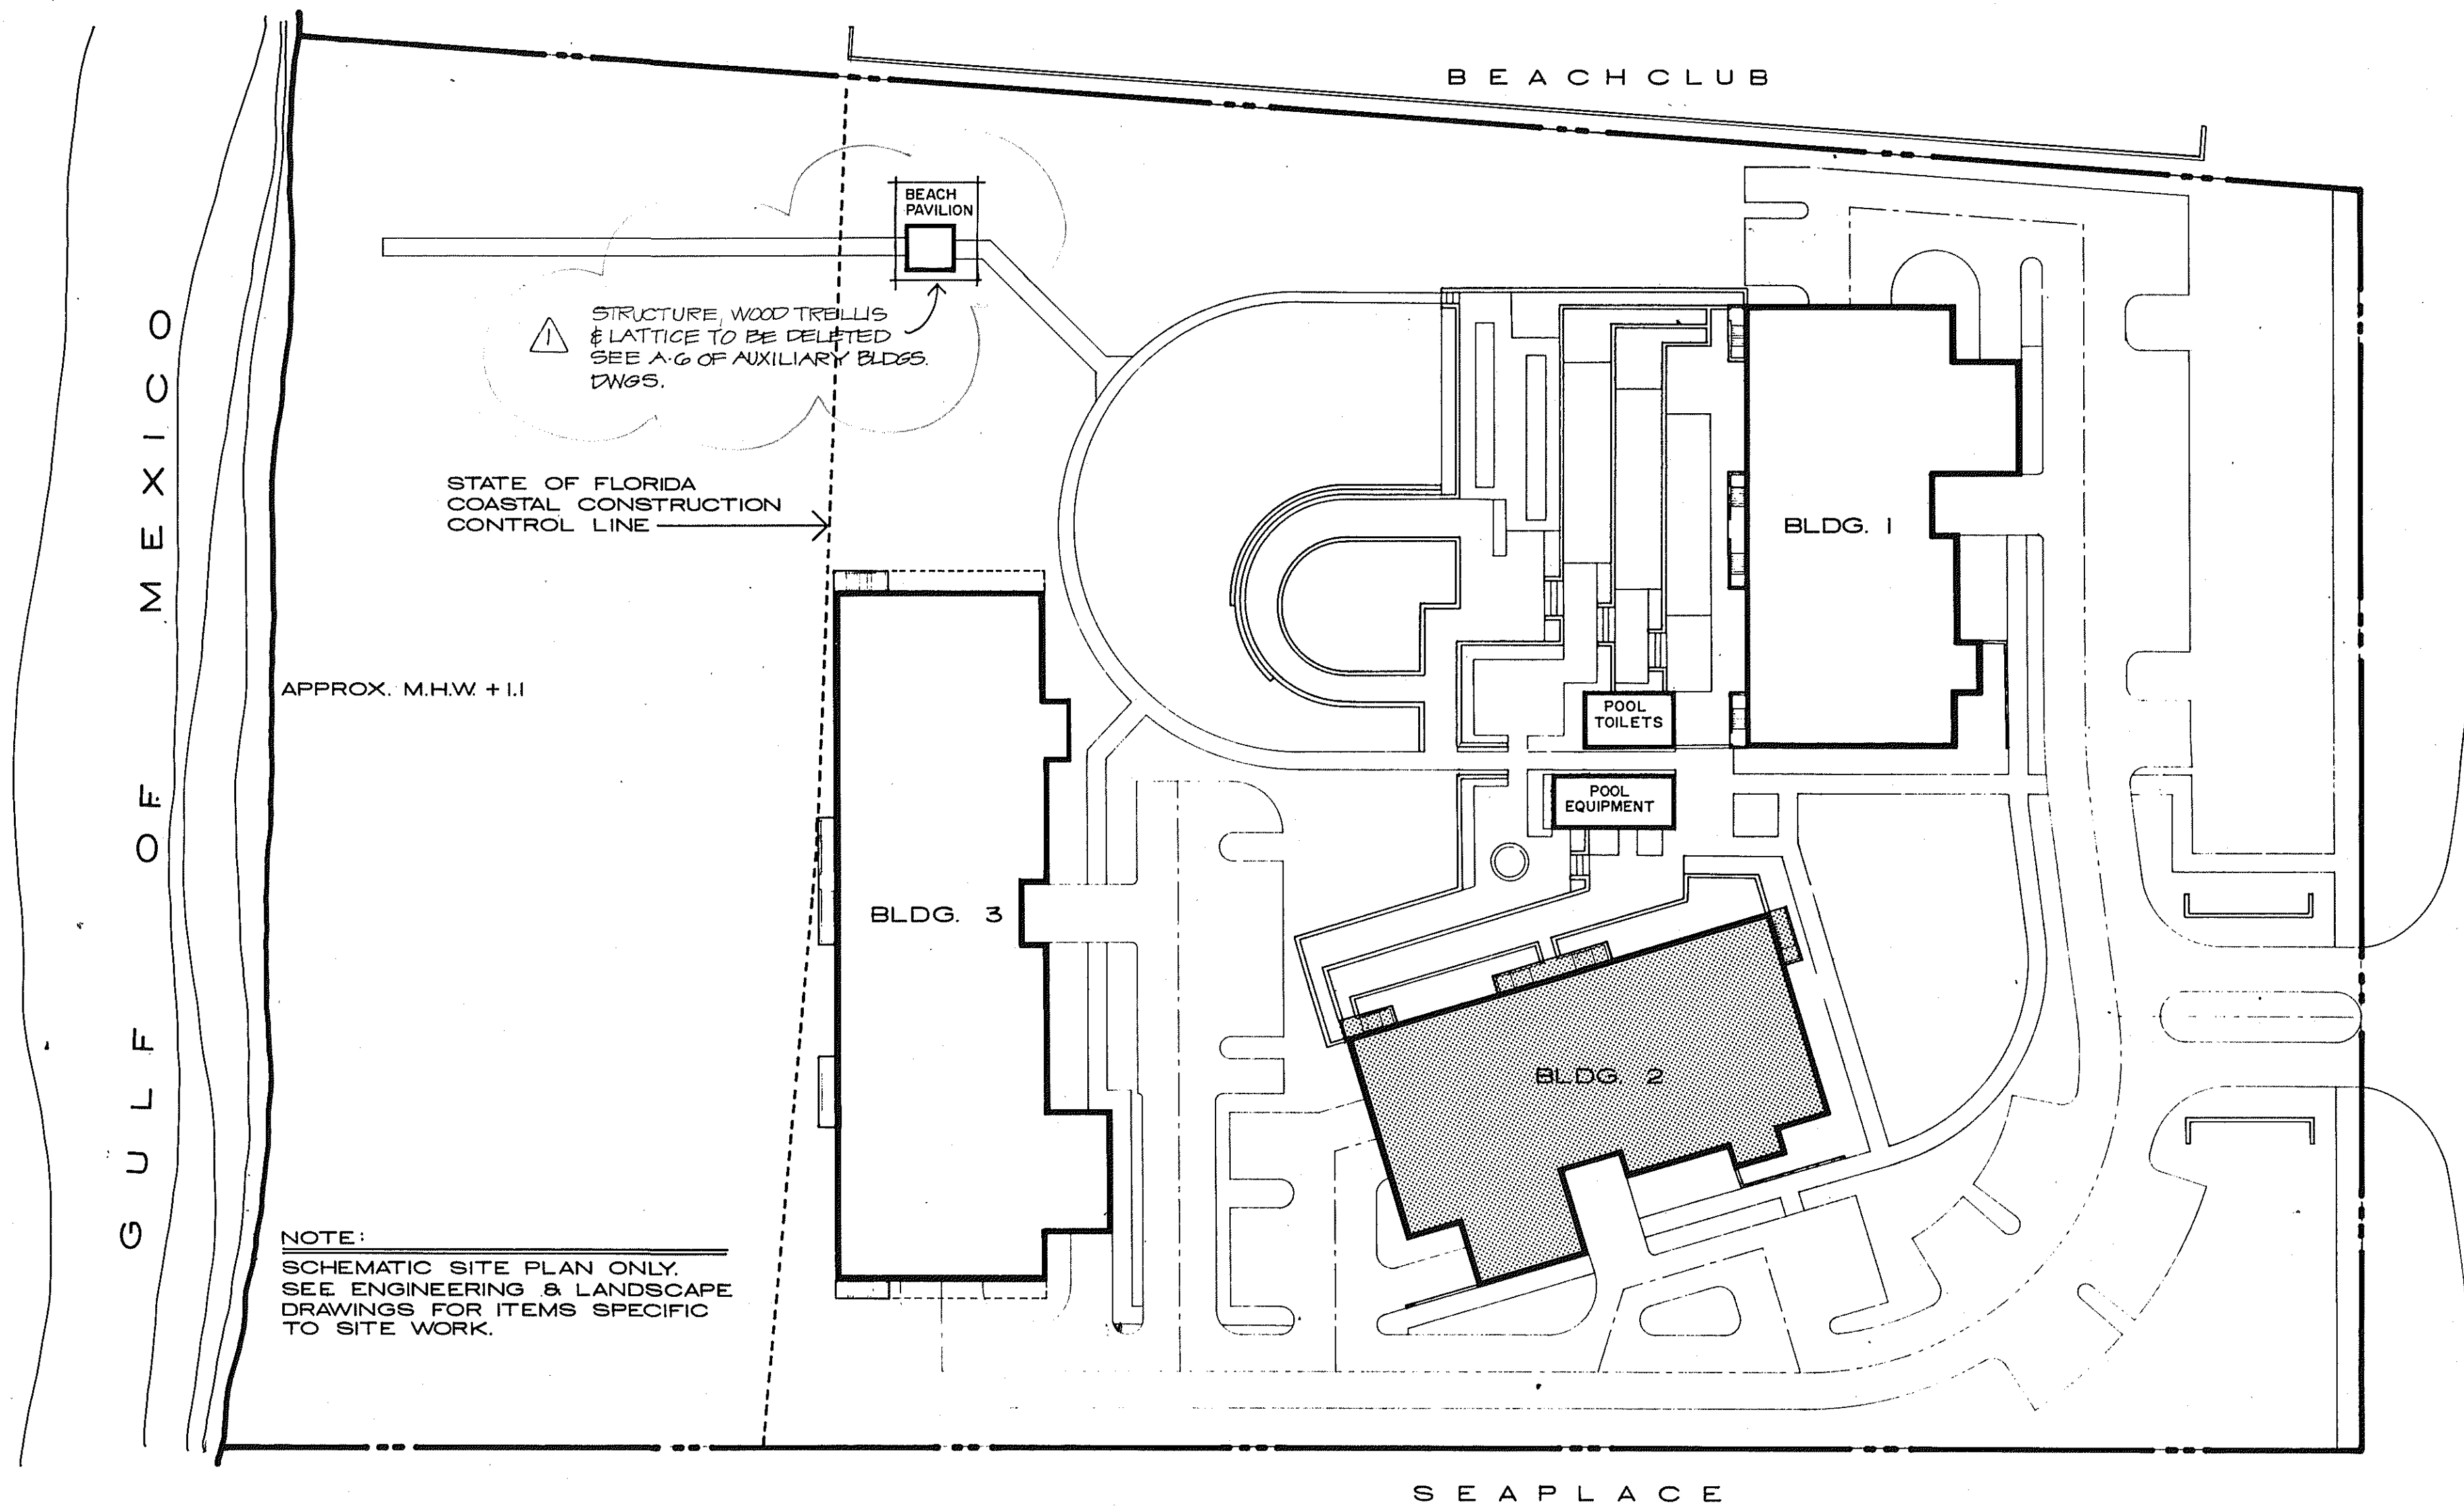

SITE PLAN

1" = 40'

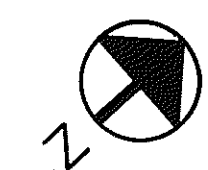

SUNSET BEACH
 OF LONGBOAT KEY
 ENGINEERS · BENNETT & BISHOP INC CONSULTING ENGINEERS & SURVEYORS

BUILDING 2 LOCATION MAP & SITE PLAN 1" = 40'
 ARVIDA CORPORATION · EDWARD J SEIBERT AIA ARCHITECT & PLANNER PA · THE SWA GROUP
 BRABHAM KUHN DEBAY CONSULTING ENGINEERS · OLSEN WHITE & ASSOCIATES' STRUCTURAL ENGINEERS

ISSUED	10 DEC. 82
REVISED	4-1-83
SHEET	A-1
	OF 27