


OVERLAYS	1	2	4	5	6
COMPOSITE	1	2	4	5	6

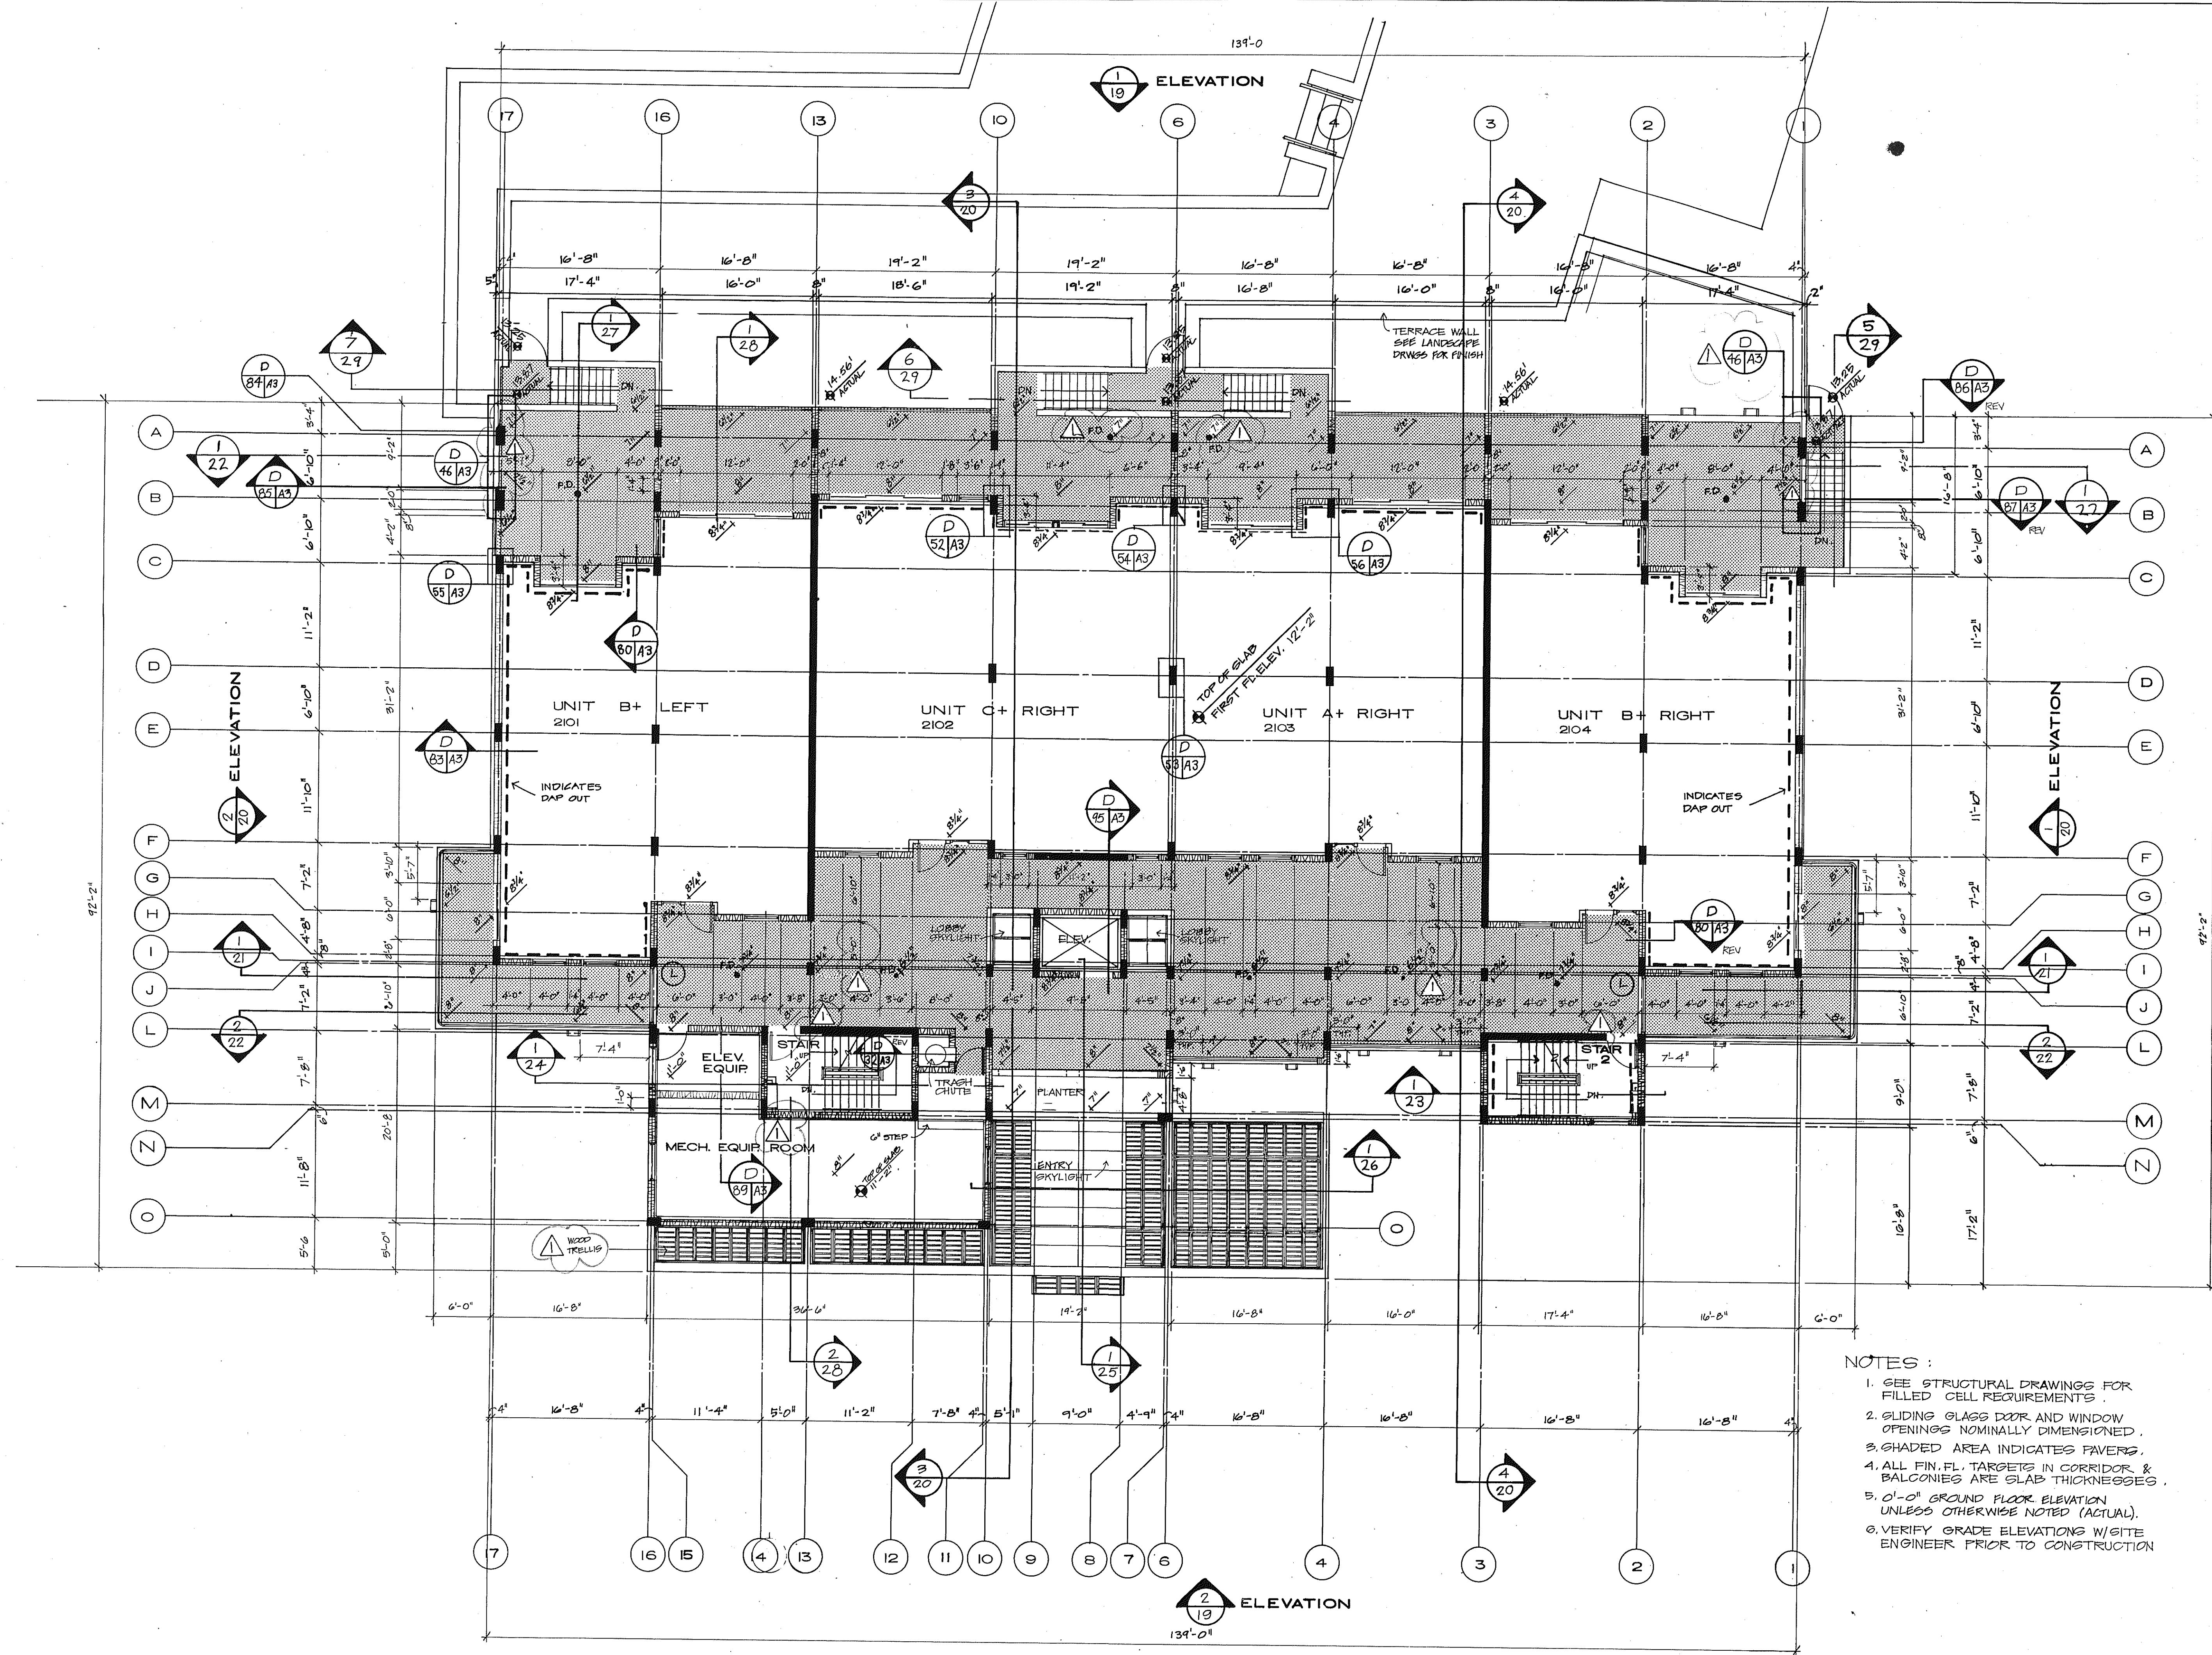

- NOTES:
1. SEE STRUCTURAL DRAWINGS FOR FILLED CELL REQUIREMENTS.
  2. SLIDING GLASS DOOR AND WINDOW OPENINGS NOMINALLY DIMENSIONED.
  3. SHADED AREA INDICATES PAVERS.
  4. ALL FIN. FL. TARGETS IN CORRIDOR & BALCONIES ARE SLAB THICKNESSES.
  5. 0'-0" GROUND FLOOR ELEVATION UNLESS OTHERWISE NOTED (ACTUAL).
  6. VERIFY GRADE ELEVATIONS W/ SITE ENGINEER PRIOR TO CONSTRUCTION.