


OVERLAYS	1	2	4	7	8
COMPOSITE	1	2	4	7	8

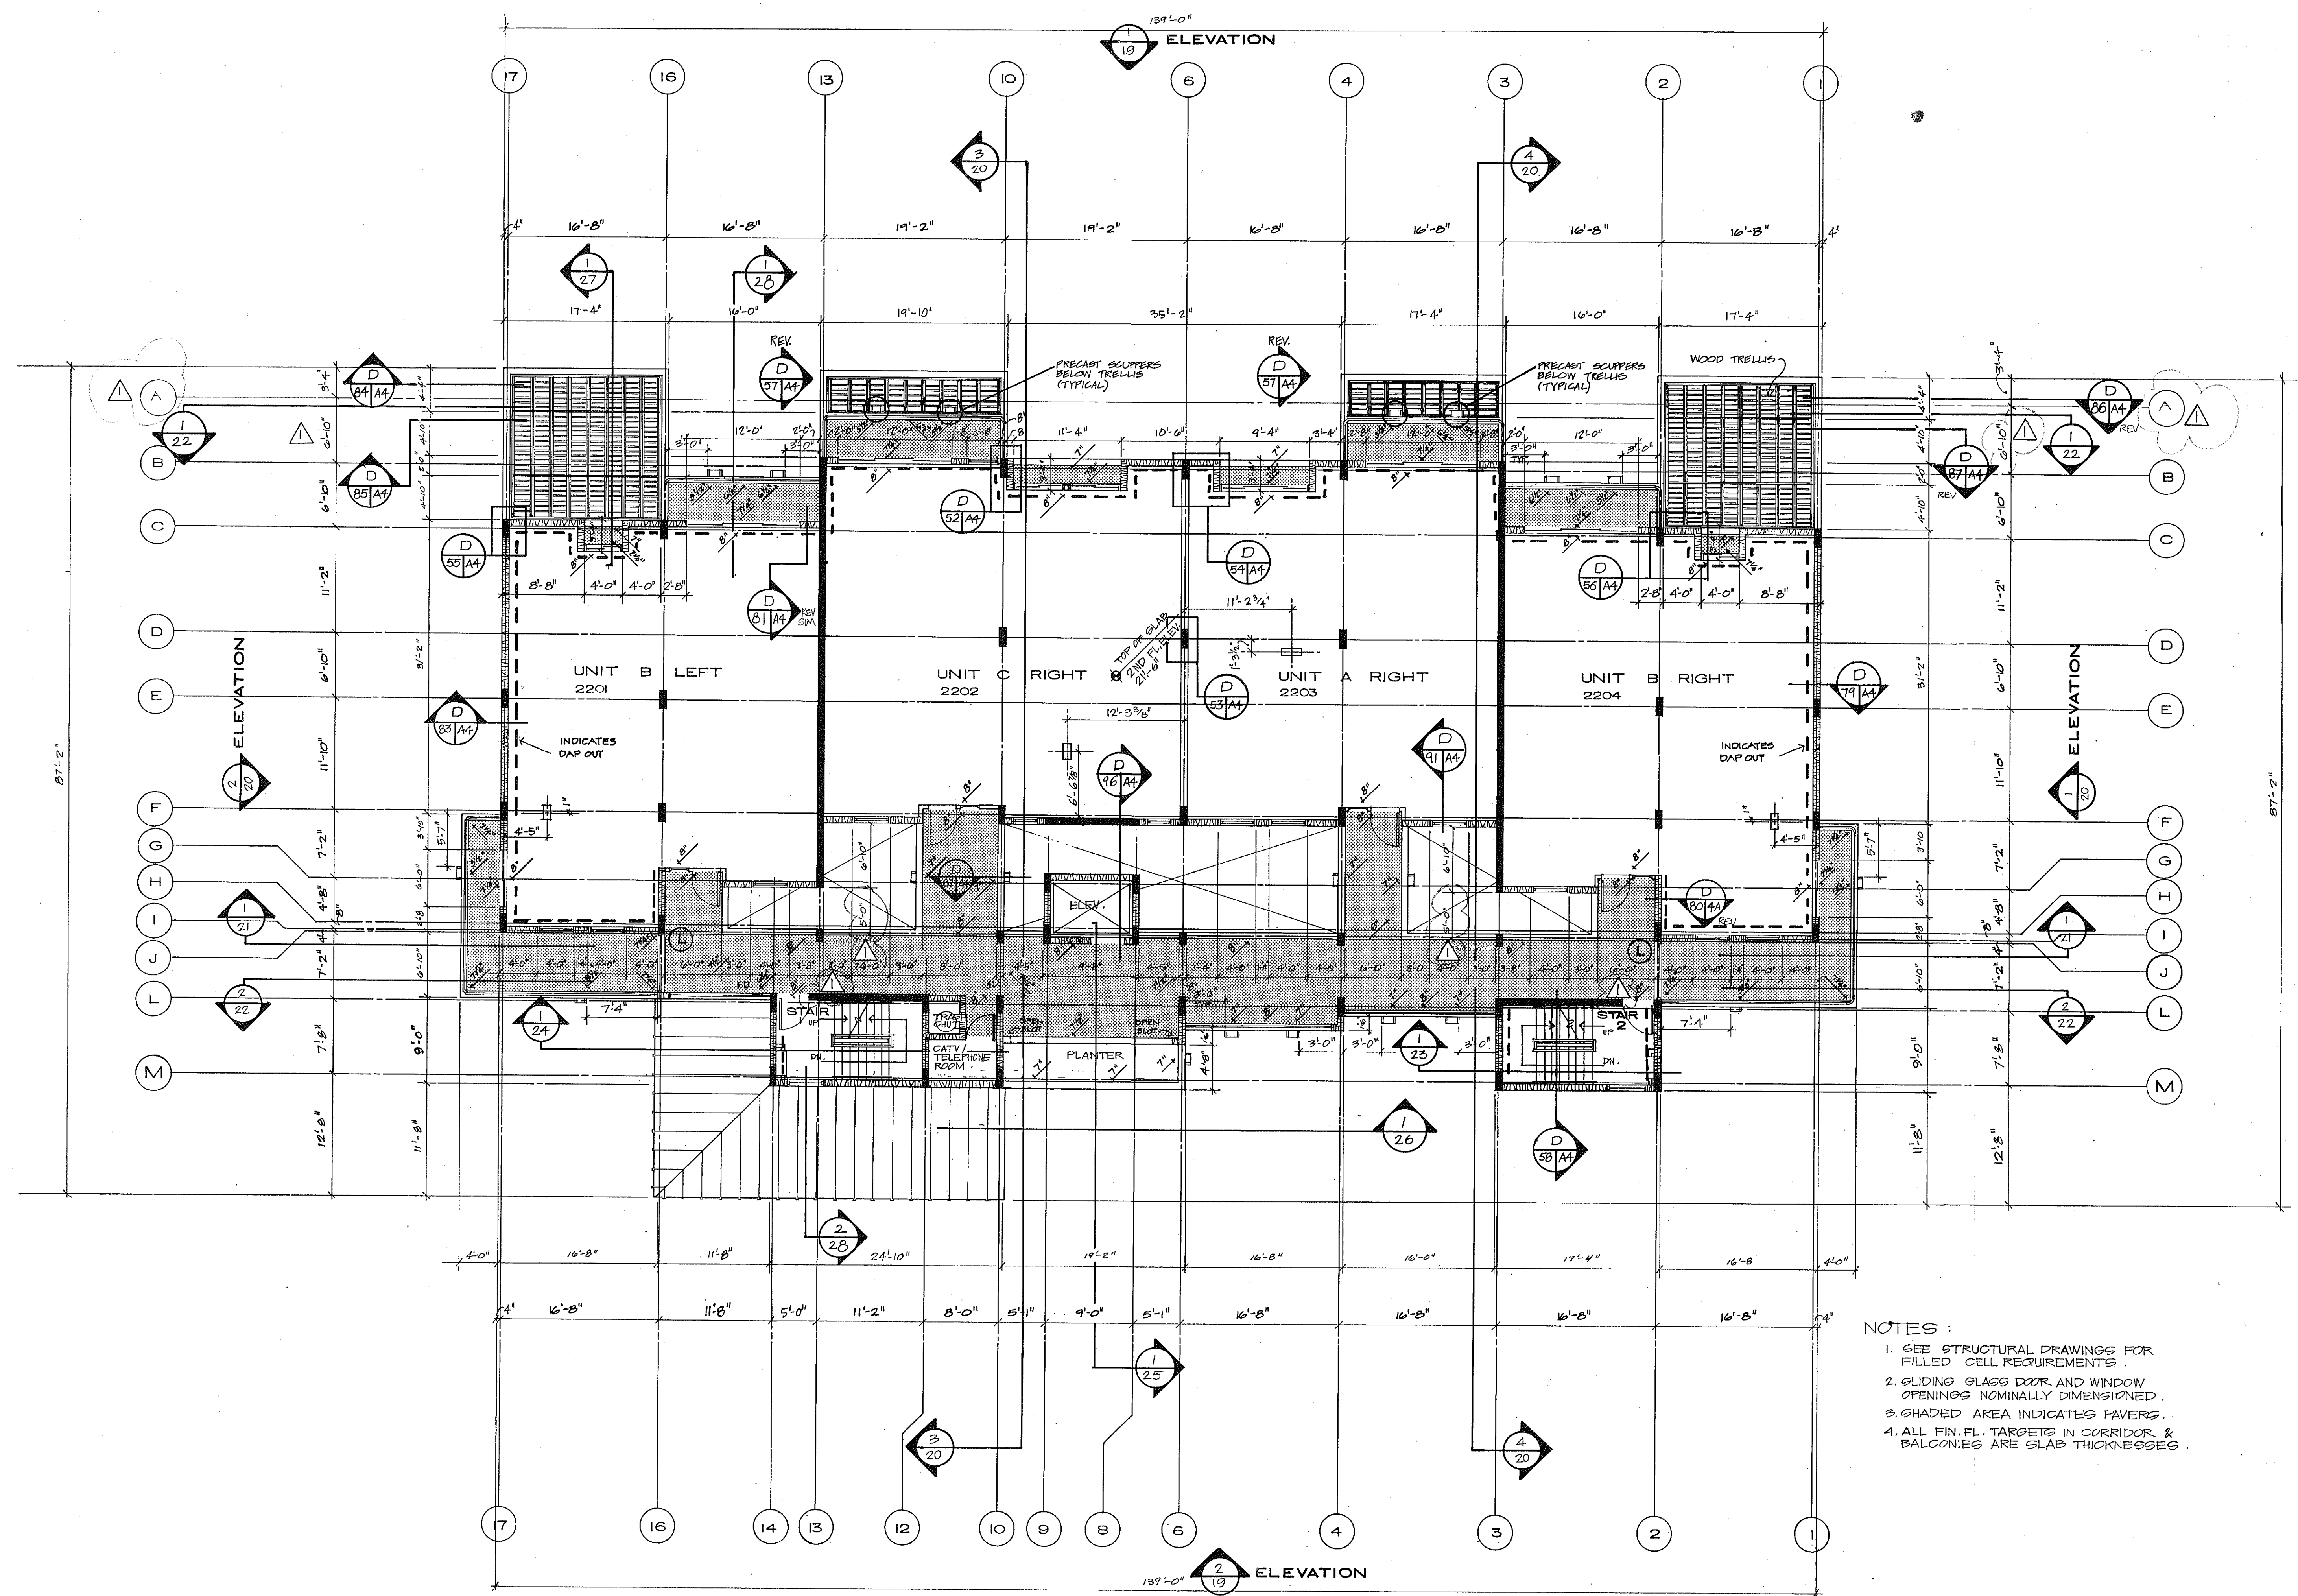

- NOTES:
1. SEE STRUCTURAL DRAWINGS FOR FILLED CELL REQUIREMENTS.
 2. SLIDING GLASS DOOR AND WINDOW OPENINGS NOMINALLY DIMENSIONED.
 3. SHADED AREA INDICATES FAVERS.
 4. ALL FIN. FL. TARGETS IN CORRIDOR & BALCONIES ARE SLAB THICKNESSES.