


OVERLAYS	
1	1
2	2
4	4
9	9
10	10

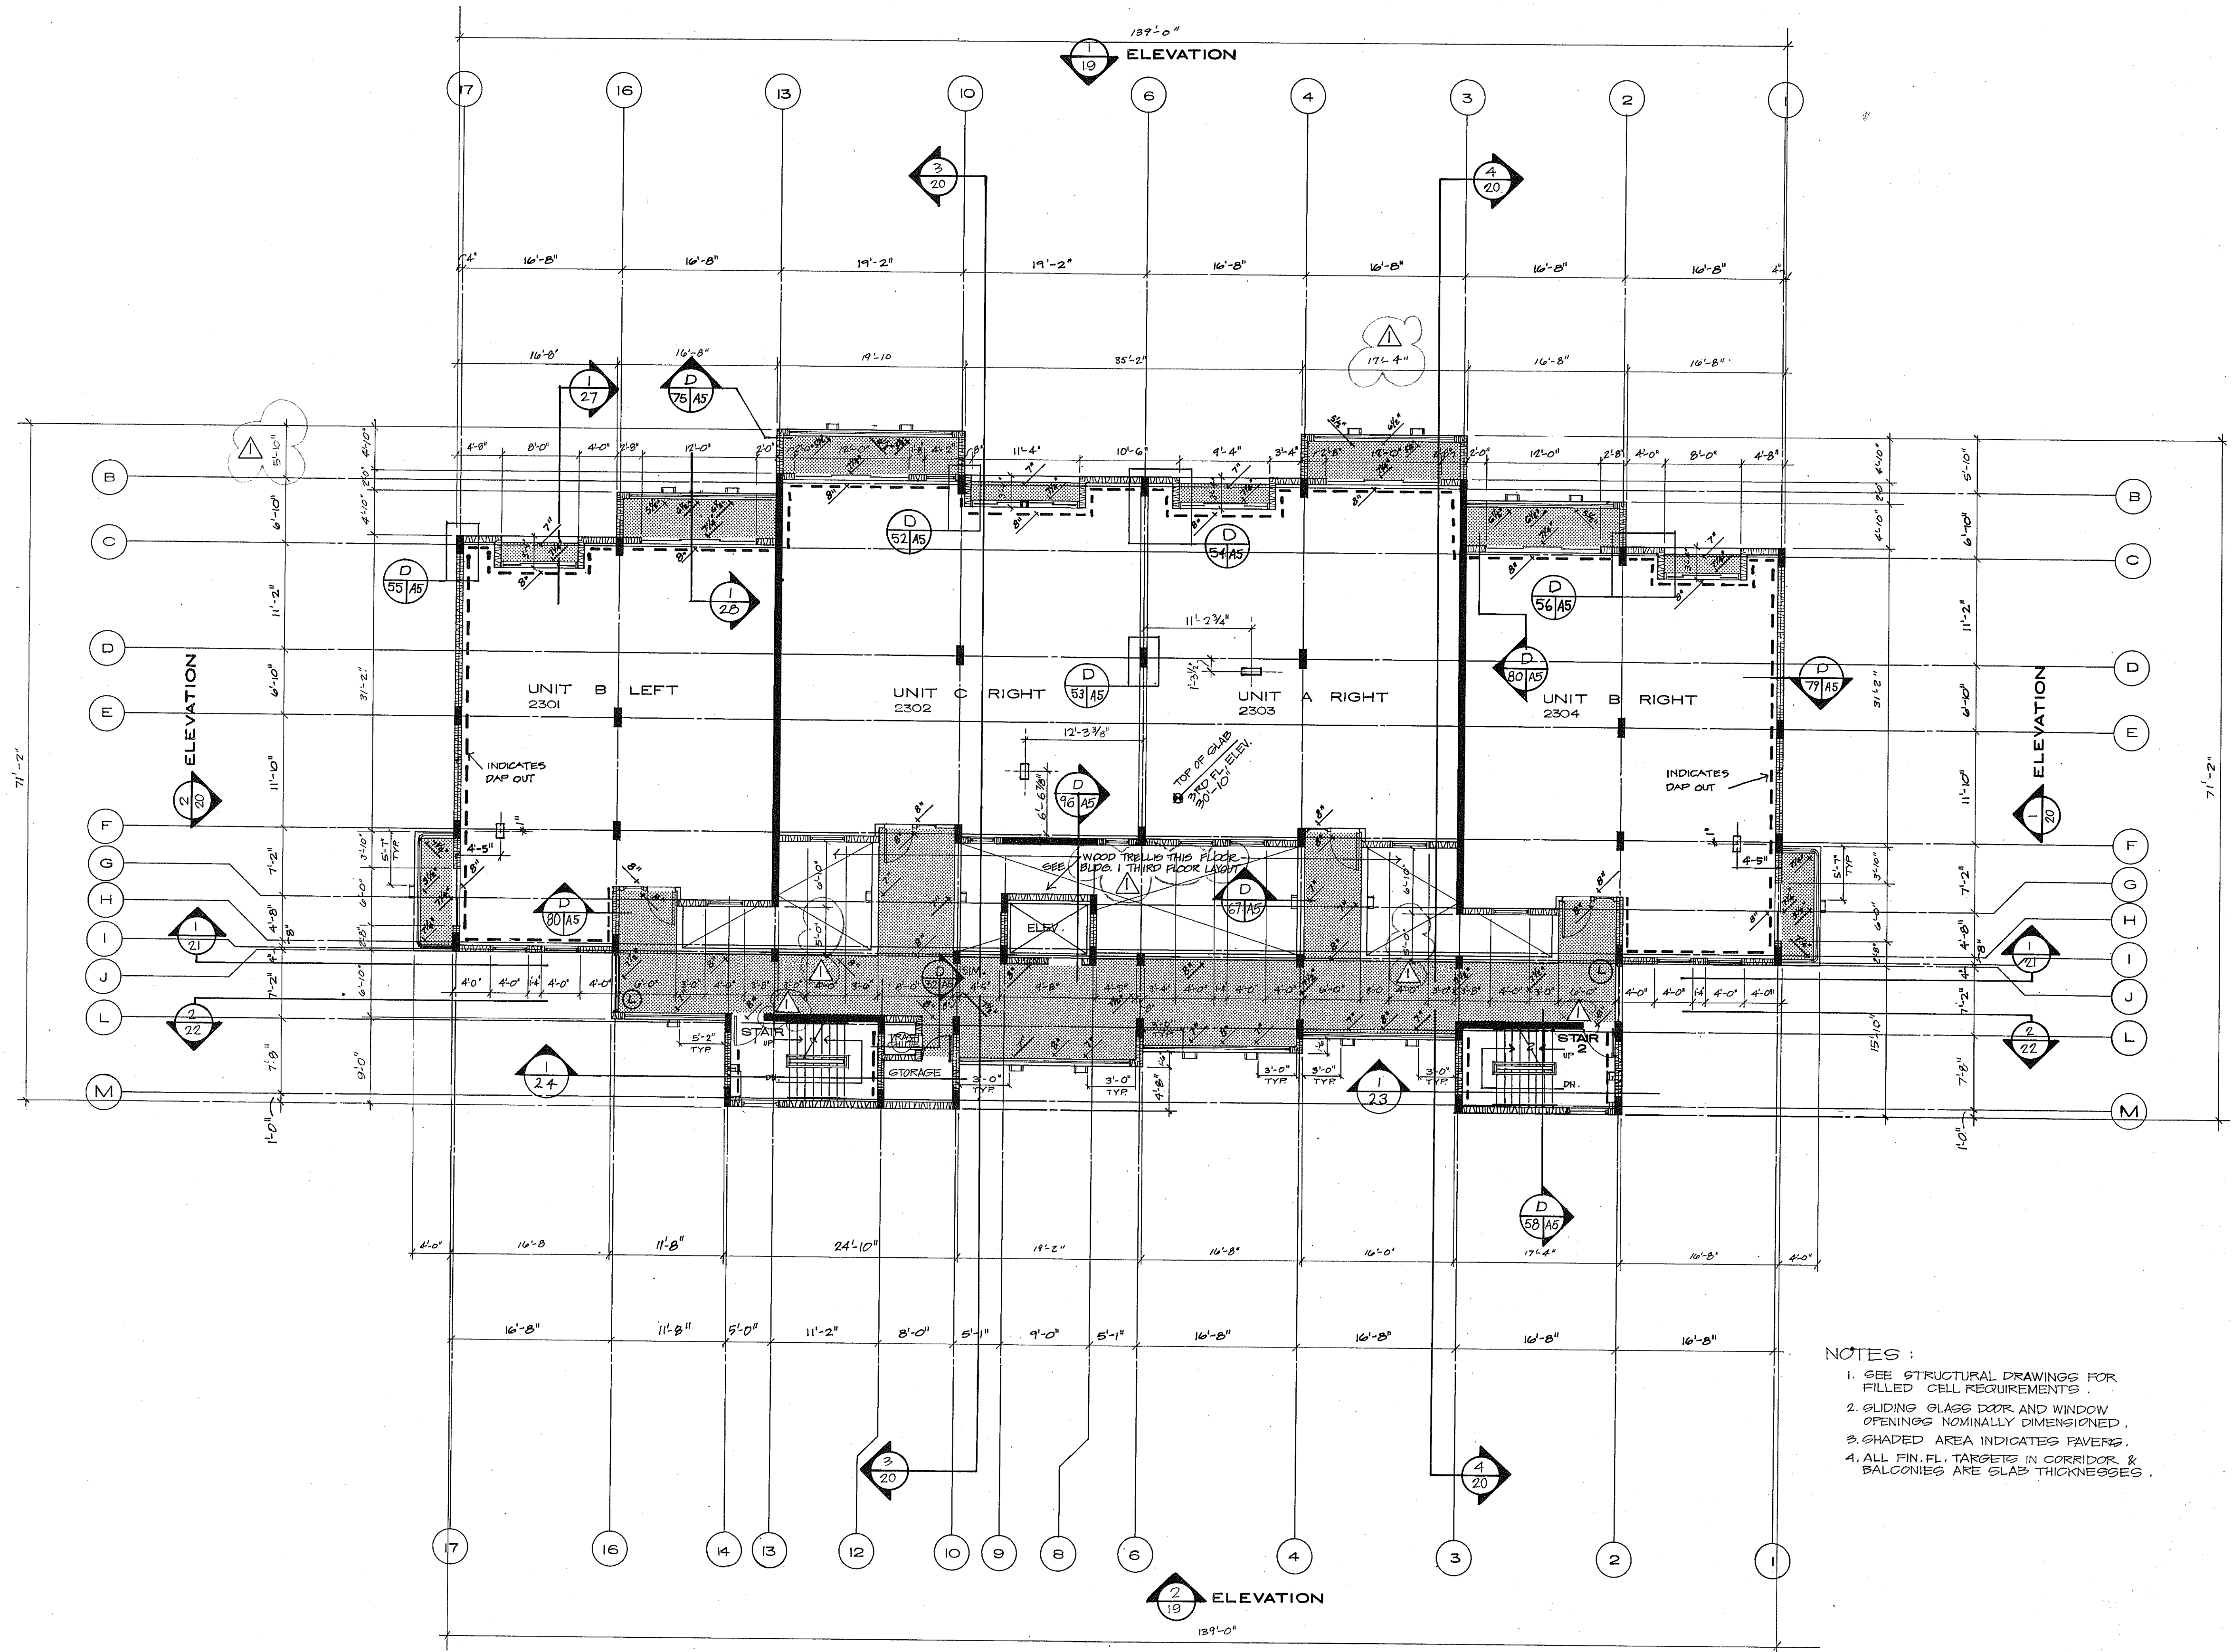

- NOTES:
1. SEE STRUCTURAL DRAWINGS FOR FILLED CELL REQUIREMENTS.
 2. SLIDING GLASS DOOR AND WINDOW OPENINGS NOMINALLY DIMENSIONED.
 3. SHADED AREA INDICATES FAVERS.
 4. ALL FIN.FL. TARGETS IN CORRIDOR & BALCONIES ARE GLAB THICKNESSES.

ISSUED	10 DEC. 82
REVISED	4-1-83
SHEET	A-5
OF 37	