


OVERLAYS	1	1
	2	2
	4	4
	11	11
	12	12

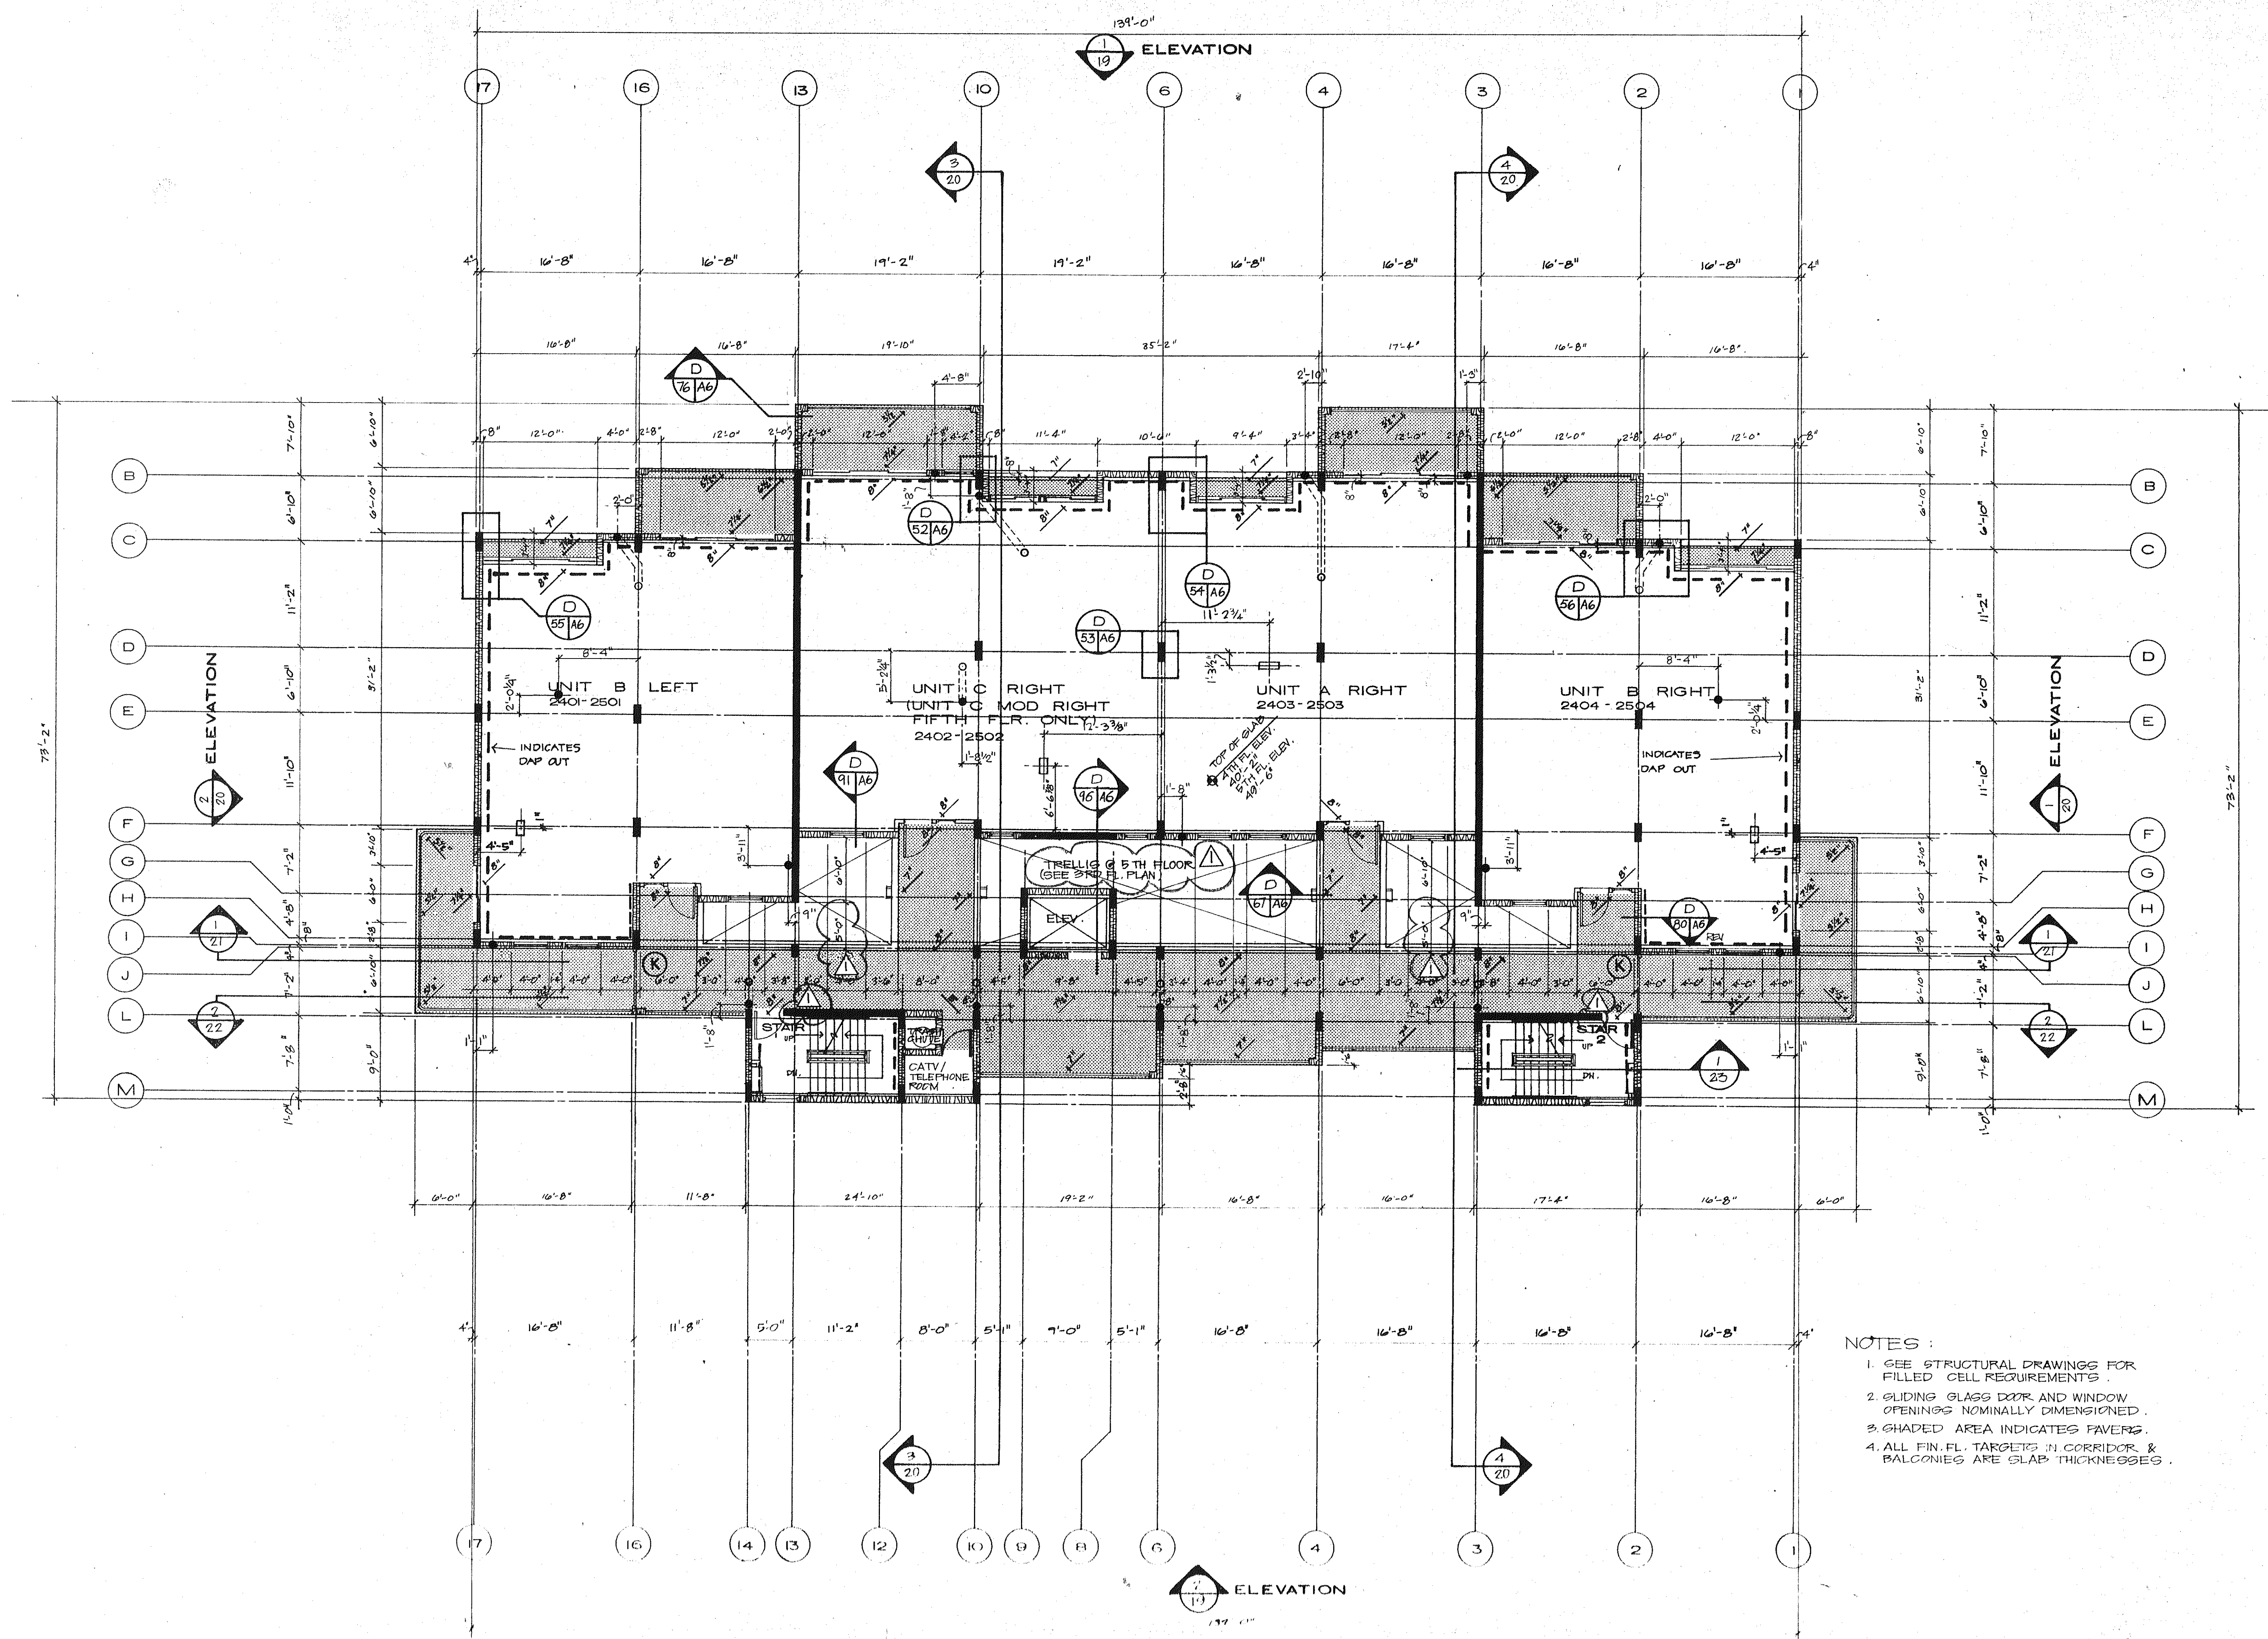

- NOTES:
1. SEE STRUCTURAL DRAWINGS FOR FILLED CELL REQUIREMENTS.
 2. SLIDING GLASS DOOR AND WINDOW OPENINGS NOMINALLY DIMENSIONED.
 3. SHADED AREA INDICATES PAVERS.
 4. ALL FIN. FL. TARGETS IN CORRIDOR & BALCONIES ARE SLAB THICKNESSES.

SUNSET BEACH
 SOF LONG BOAT KEY
 BENNETT & BISHOP, INC. CONSULTING ENGINEERS & SURVEYORS

BUILDING 2 FOURTH & FIFTH FLOOR PLAN 1/8" = 1'-0"
 ARVDA CORPORATION · EDWARD J. SEBERT, AIA, ARCHITECT & PLANNER, P.A., THE SWA GROUP
 BRABHAM, KUHN, DEBAY, CONSULTING ENGINEERS · OLSEN, WHITE & ASSOCIATES, STRUCTURAL ENGINEERS

ISSUED	10 DEC. 82
REVISED	4-1-83
	2-1-84
SHEET	
A-6	
OF 37	