


OVERLAYS  
COMPOSITE

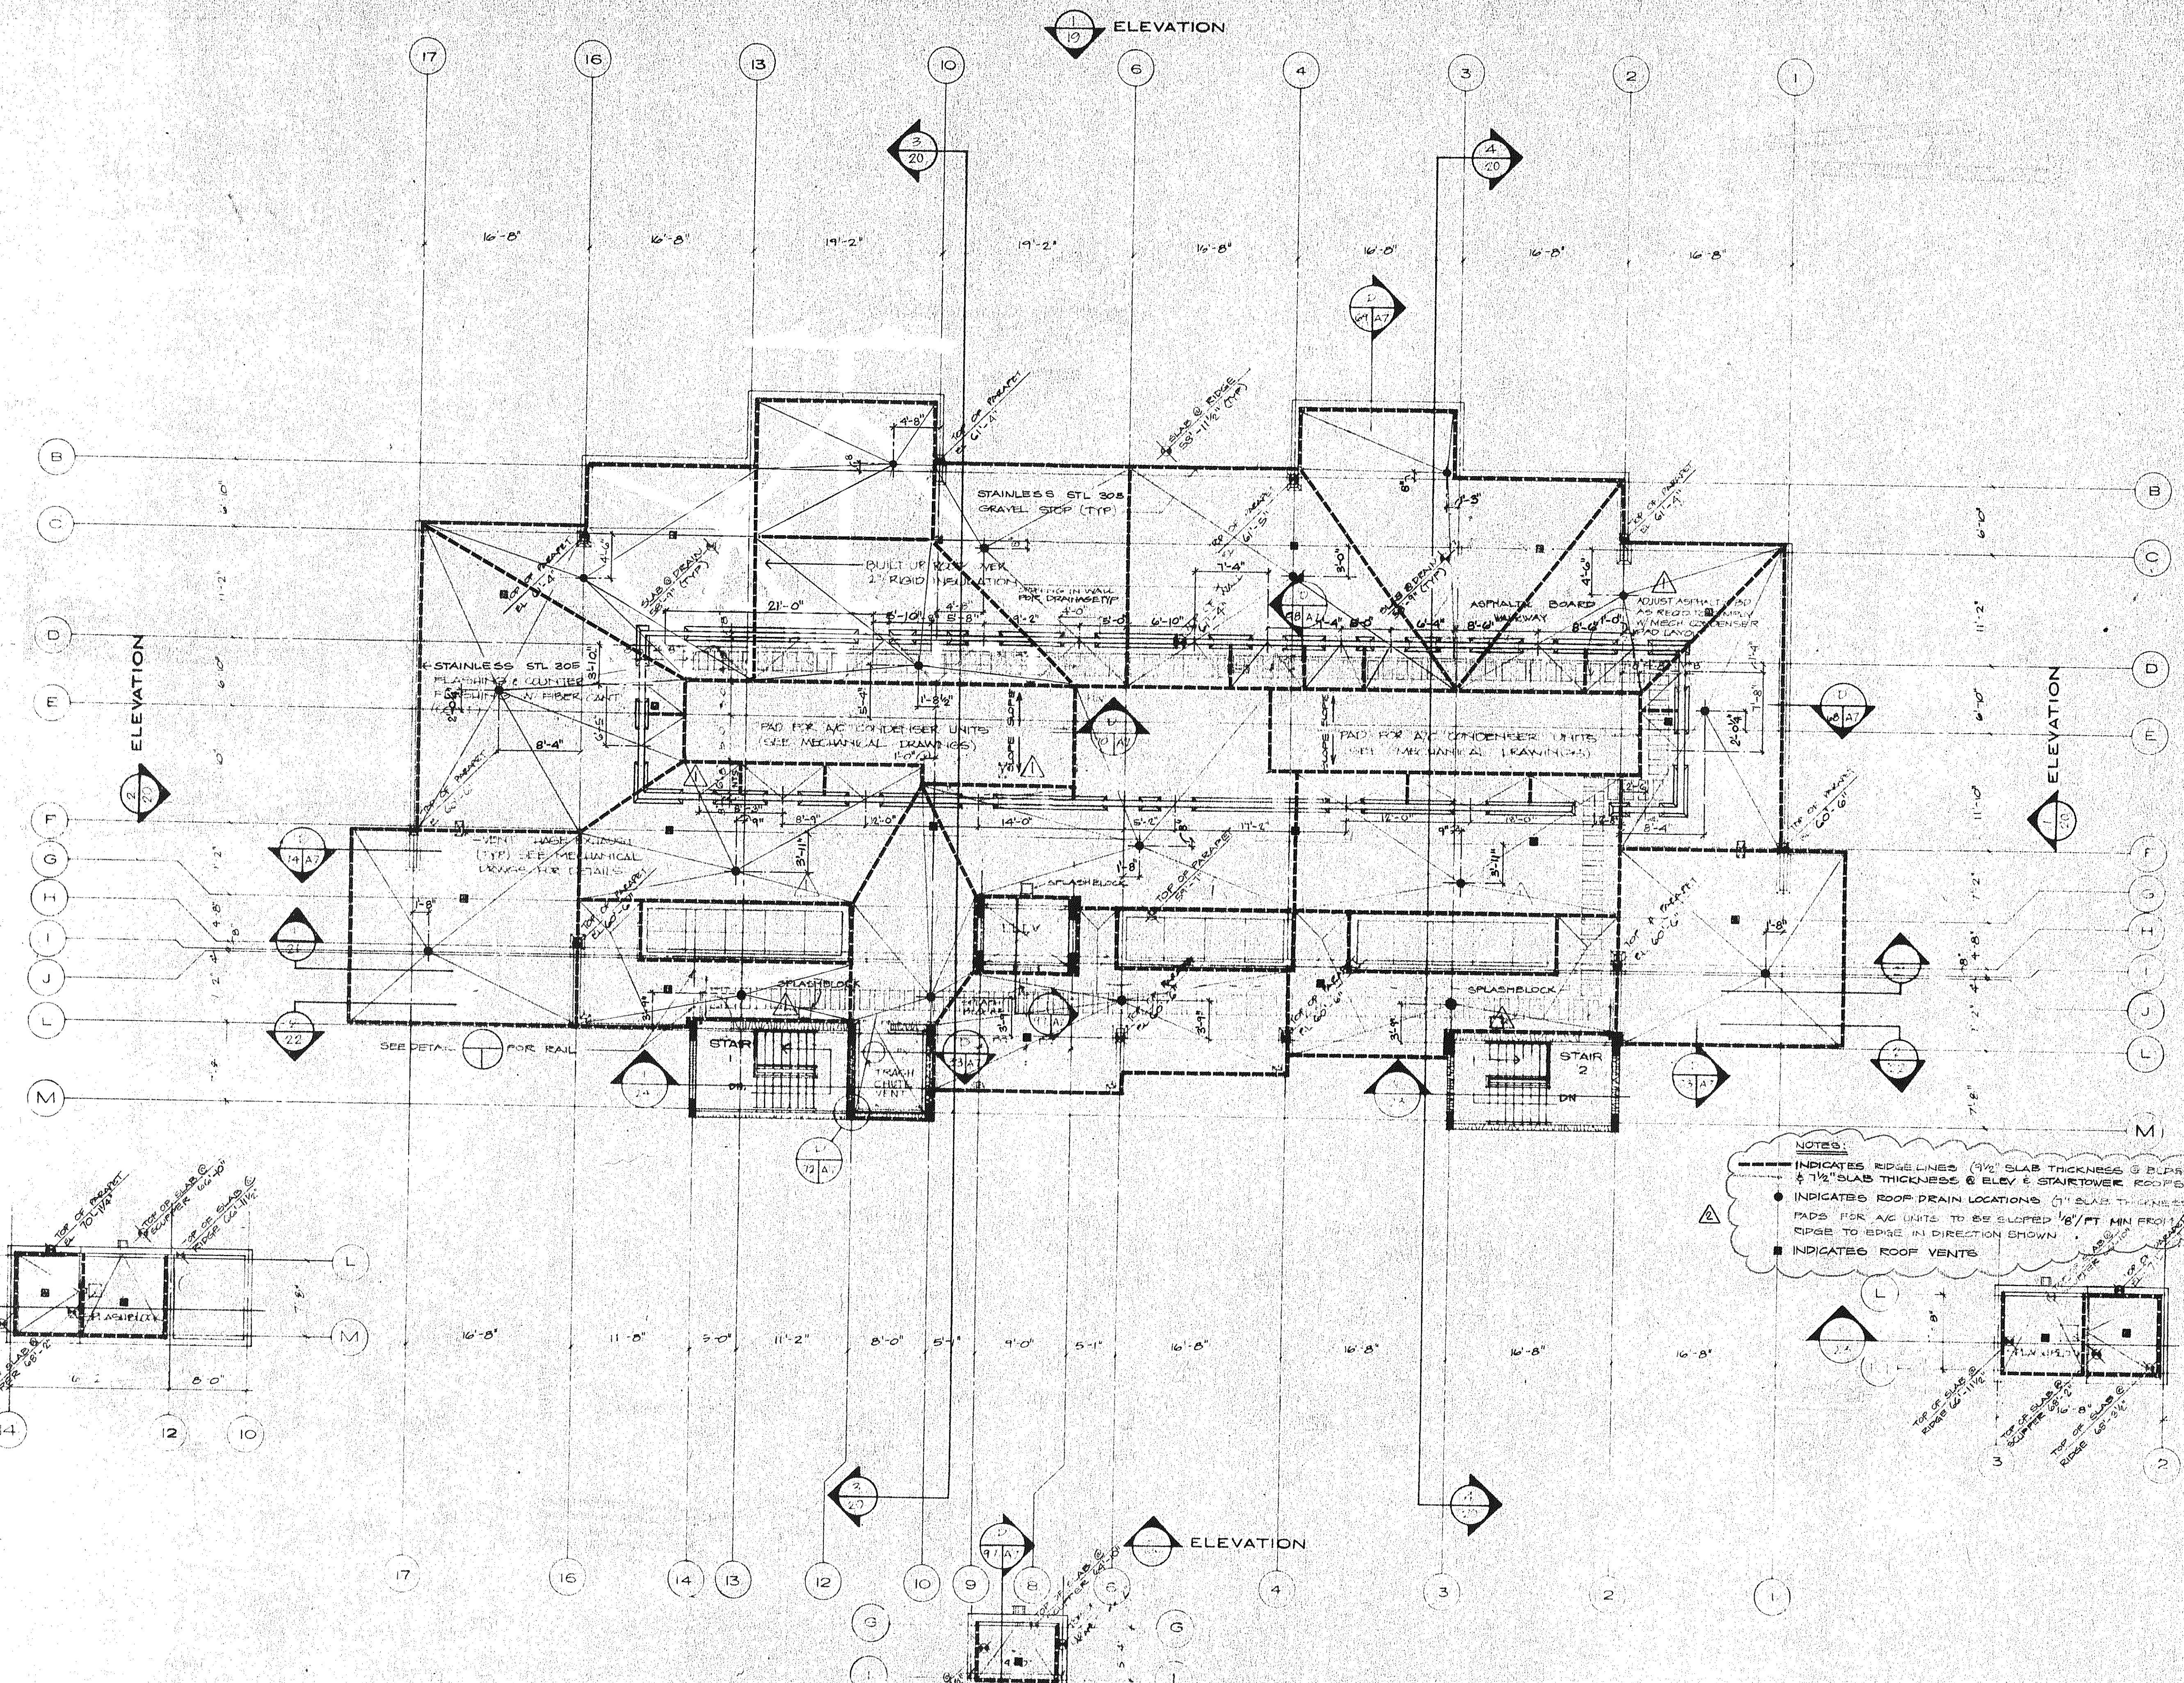

**NOTES:**

- PADS FOR AC UNITS TO BE SLOPED 1/8" FT MIN FROM RIDGE TO EDGE IN DIRECTION SHOWN
- INDICATES ROOF VENTS

SUNSET BEACH  
OF BOAT KEY

BUILDING 2 ROOF PLAN 1/8" = 1'-0"  
ARVITA CORPORATION, EDWARD J. SEBERT, AIA, ARCHITECT & PLANNER FOR THE SWA GROUP  
BRABHAM KUHNS, DEBAY CONSULTING ENGINEERS  
CUSEN WHITE & ASSOCIATES, STRUCTURAL ENGINEERS  
BUNNETT & BISHOP, INC. CONSULTING ENGINEERS & SURVEYORS

ISSUED	10 DEC 82
REVISED	4-1-83
	8-1-84
	3-12-84
SHEET	A-7