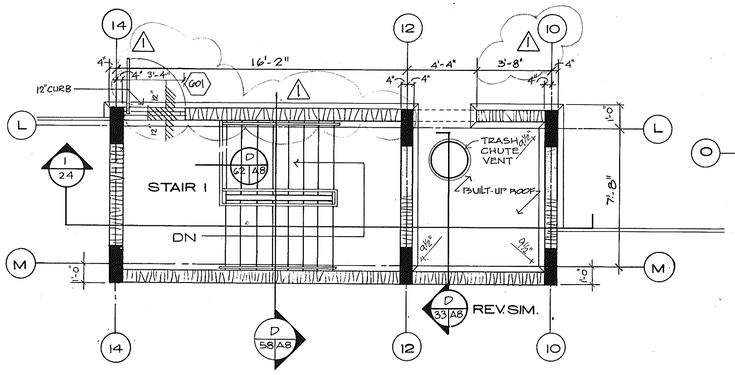

ROOF FLOOR PLAN

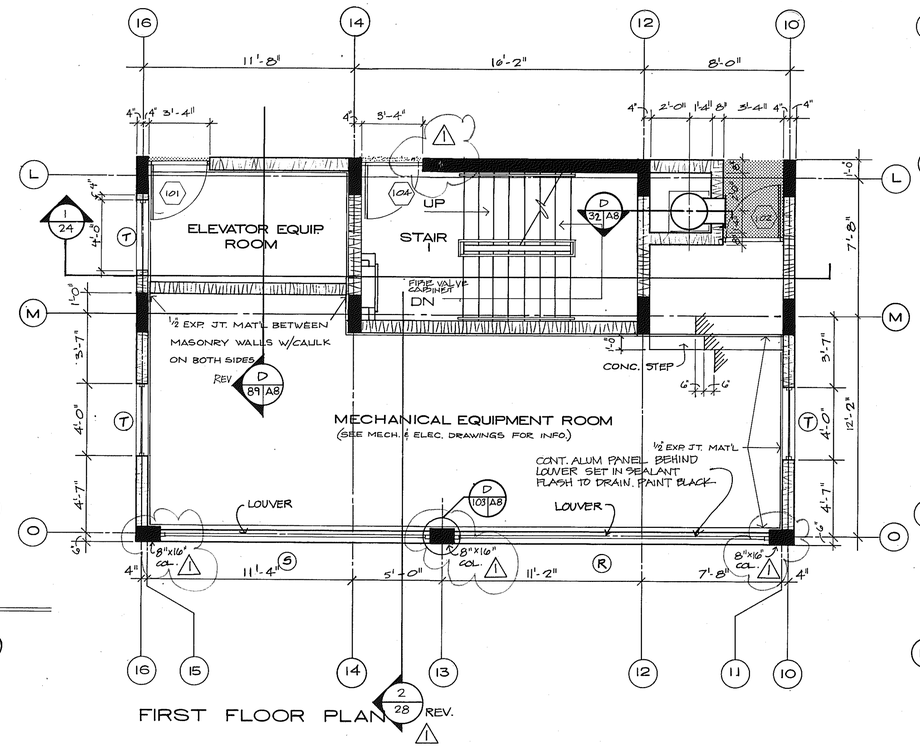

FIRST FLOOR PLAN

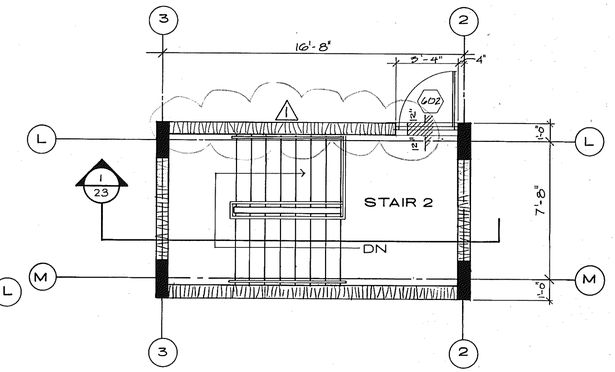

ROOF FLOOR PLAN

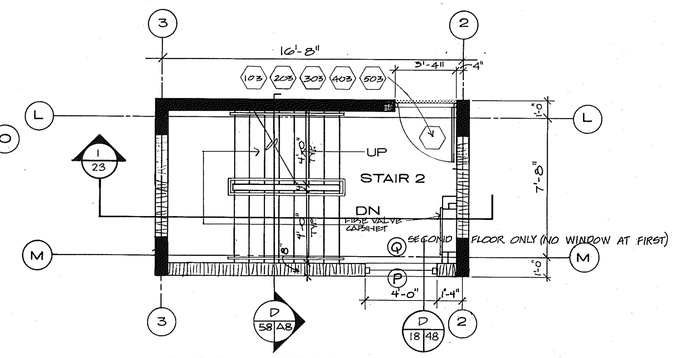

TYPICAL FIRST THRU FIFTH FLOOR PLAN

TOWER 1

GROUND FLOOR PLAN

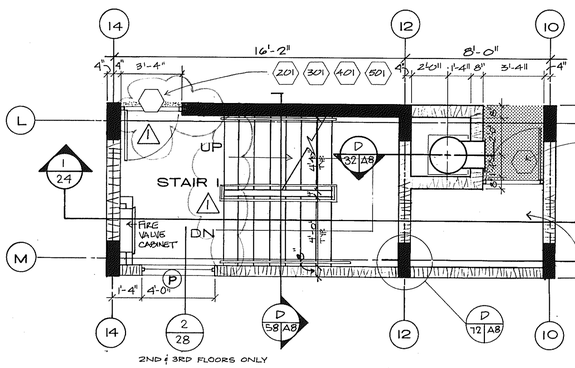

TYPICAL SECOND THRU FIFTH FLOOR PLAN

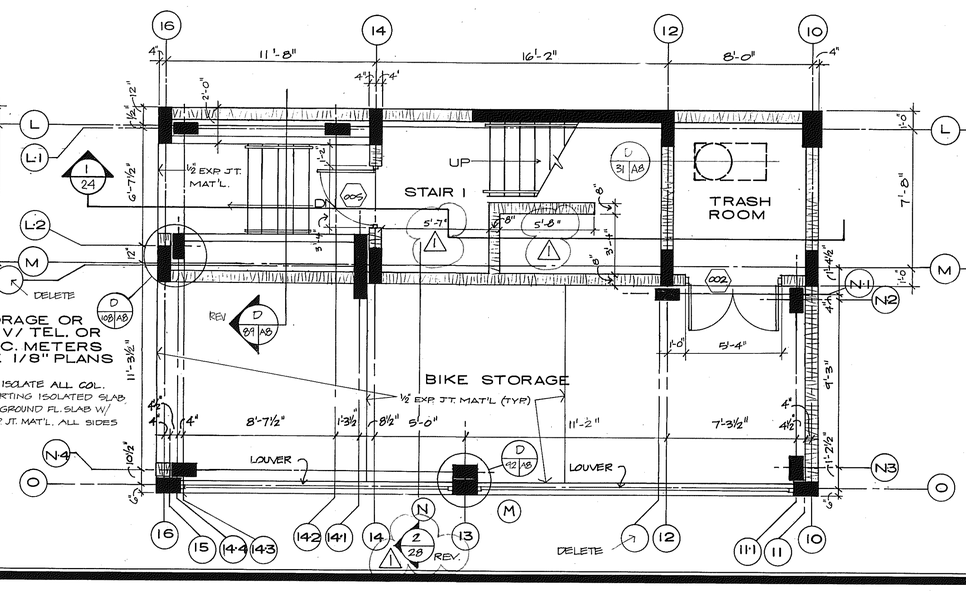

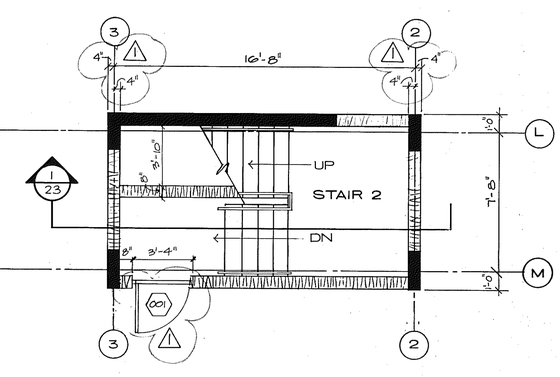

GROUND FLOOR PLAN

TOWER 2

SUNSET BEACH OF LONGBOAT KEY

BUILDING 2 STAIR TOWERS

1/4" = 1'-0"

ARVIDA CORPORATION · EDWARD J SEIBERT AIA ARCHITECT & PLANNER PA · THE SWA GROUP
BRABHAM KUHNS DEBAY CONSULTING ENGINEERS · OLSEN WHITE & ASSOCIATES STRUCTURAL ENGINEERS · BENNETT & BISHOP INC CONSULTING ENGINEERS & SURVEYORS

ISSUED 10 DEC. 82

REVISED 4-1-83

SHEET A·8 OF 37