


NOTE:
BALCONY DEPTHS DIFFER FROM THIS DRAWING ON FLOORS 4 AND 5. SEE 1/8" BLDG PLANS. END WALLS OCCUR ON BALCONIES @ FLOORS 3, 4, AND 5. SEE 1/8" BLDG PLANS.

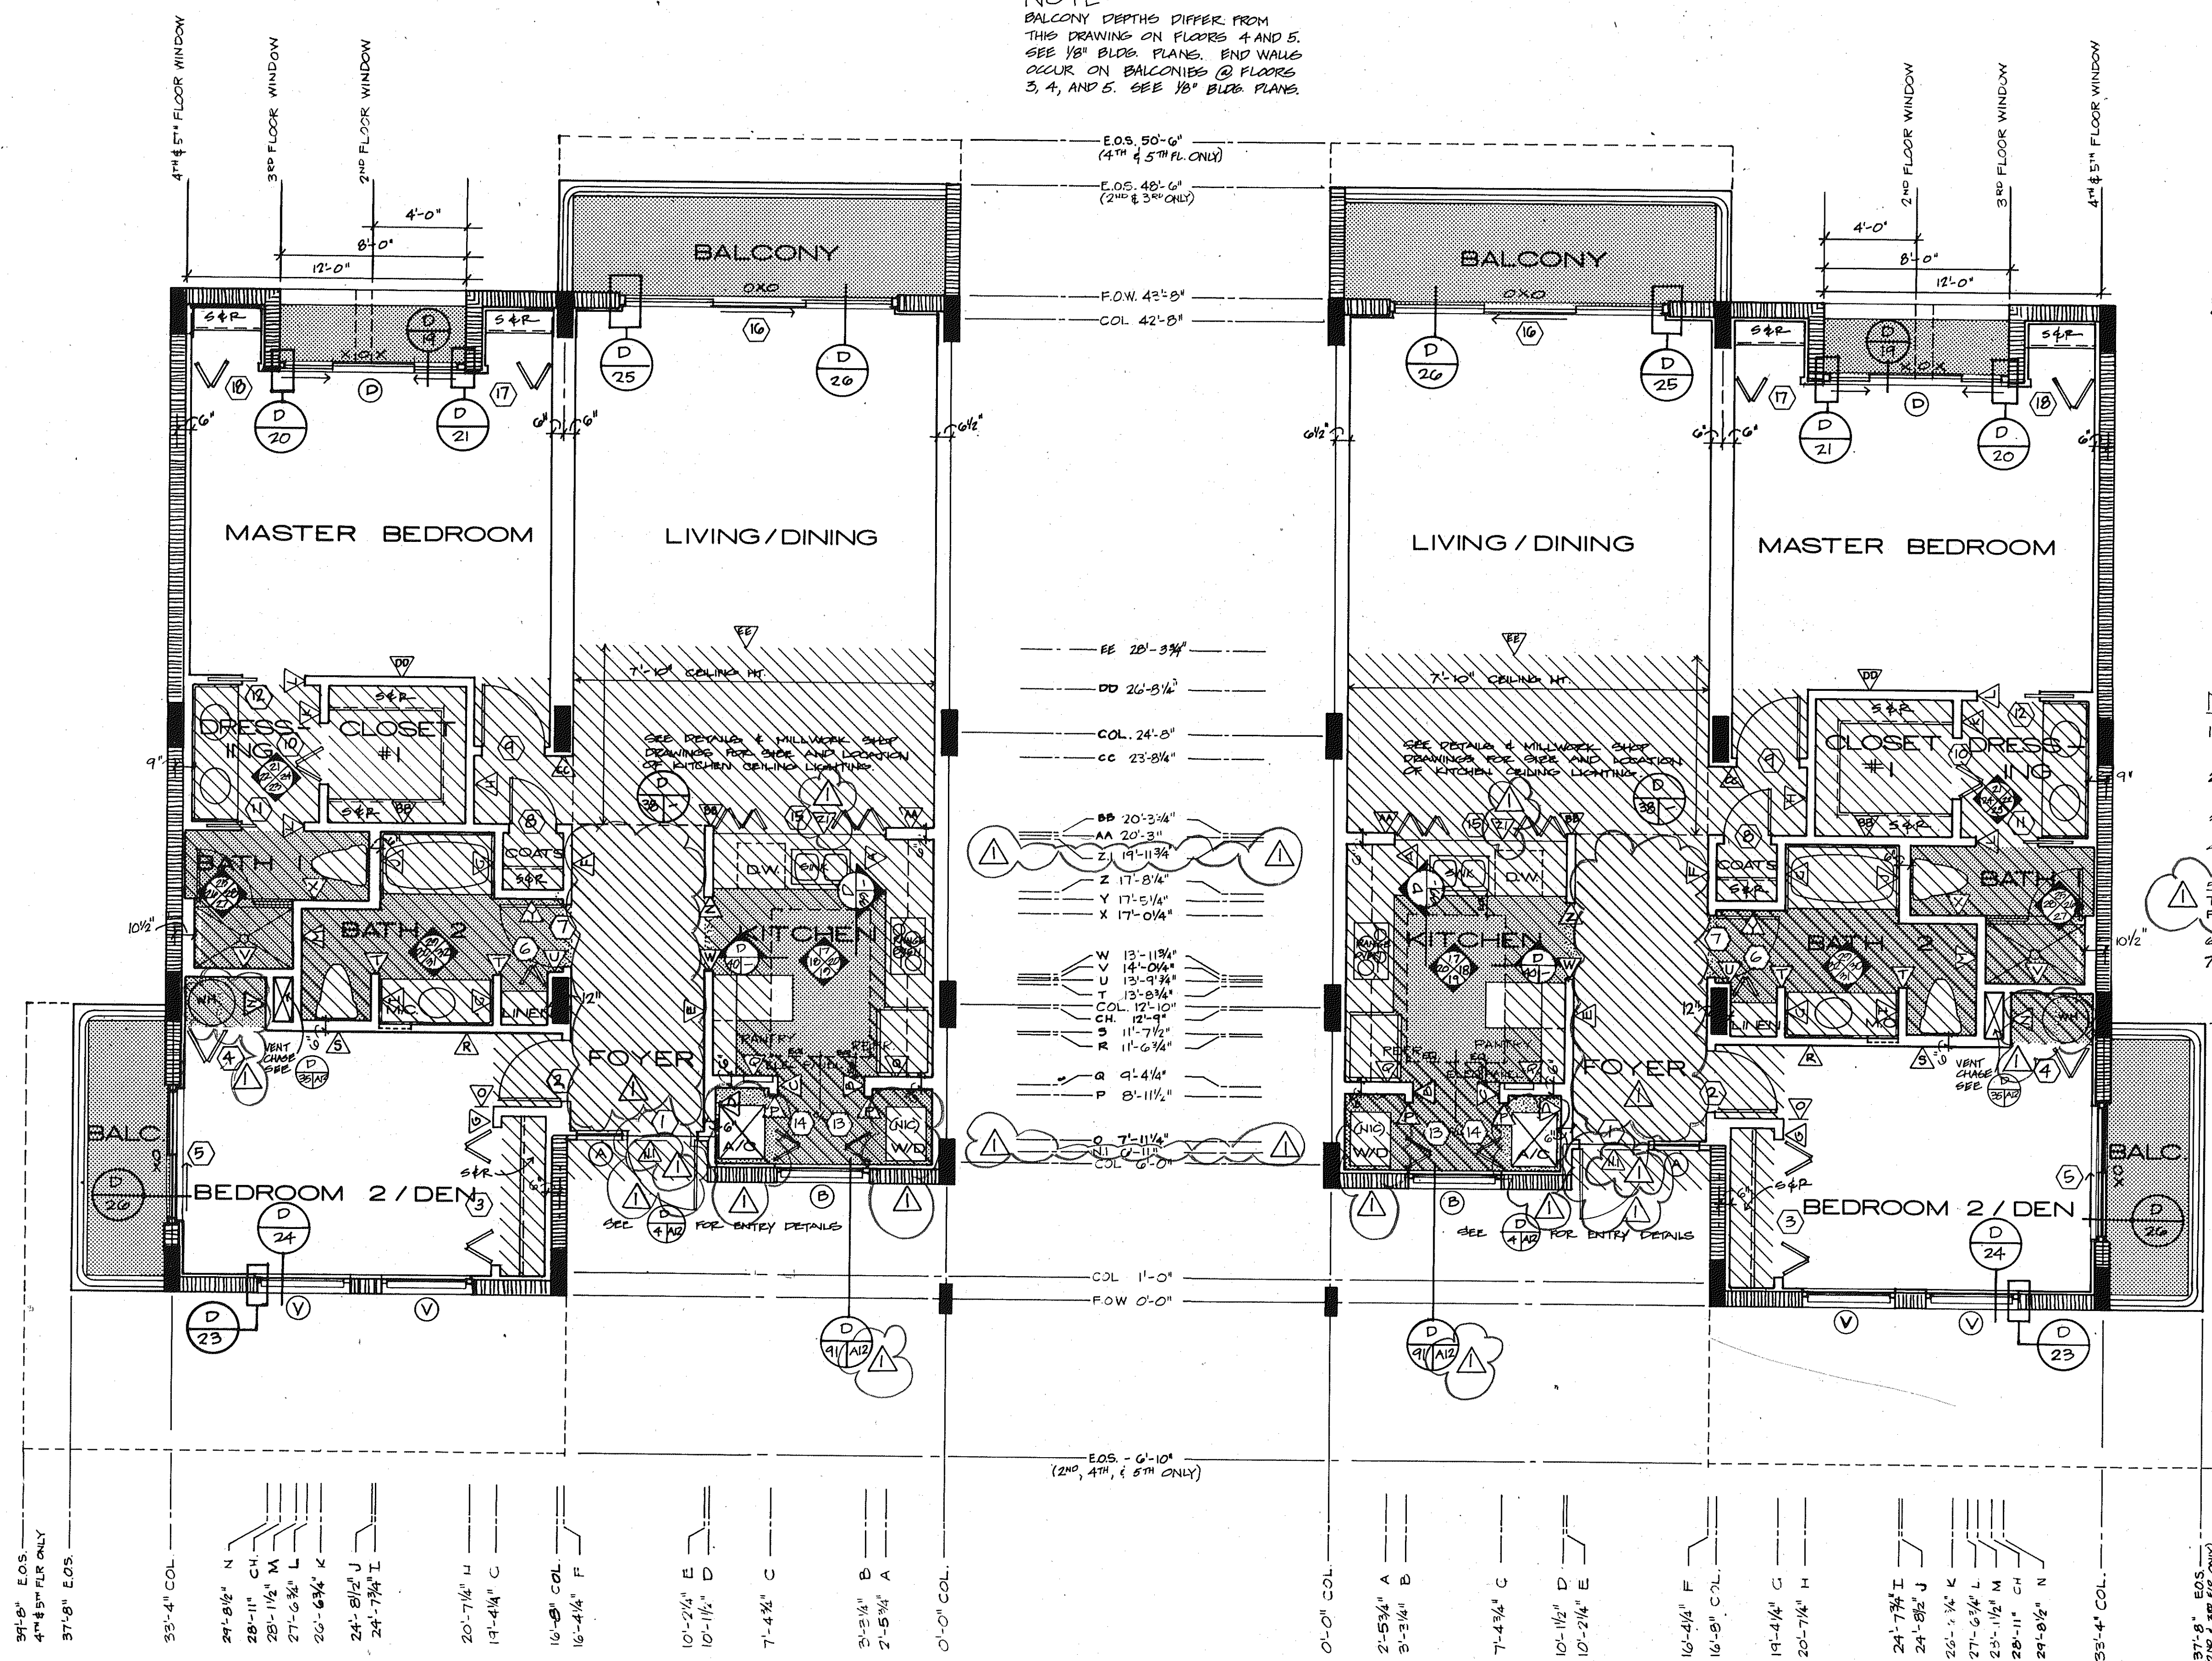

SEE 1/8" BLDG PLANS FOR WINDOW CONFIGURATION OF B UNITS.

NOTES

- SEE 1/8" BLDG PLANS FOR COL. & CHEAR WALL LOCATIONS.
- ALL DROPPED CEILING ARE 7'-0" UNLESS OTHERWISE NOTED.
- ALL DIMENSIONS ARE FROM CENTERLINE OF WALL.
- SEE DETAIL BOOKLET FOR DOOR, WINDOW & FINISH SCHEDULES.
- SCREEN DOT TEXTURE DENOTES PAVERS, CER. TILE, VINYL TILE & VAT. SEE FINISH SCHEDULES FOR EXACT LOCATION.
- VERIFY EXACT LOCATION OF LANS. W/ ARCH.
- SEE SHEET A-9 FOR PLAN DIMENSIONING KEY.

UNIT B LEFT

UNIT B RIGHT

37'-9" E.O.S.
4" #5 FLOOR ONLY
37'-9" E.O.S.

33'-4" COL.
24'-8 1/2" N
28'-11" CH
28'-1 1/2" M
27'-6 3/4" L
26'-6 3/4" K
24'-8 1/2" J
24'-7 3/4" I
20'-7 1/4" H
19'-4 1/4" C
16'-9" COL.
16'-4 1/4" F
10'-2 1/4" E
10'-1 1/2" D
7'-4 1/2" C
3'-5 1/4" B
2'-5 3/4" A
0'-0" COL.

E.O.S. - 6'-10"
(2ND, 4TH, & 5TH ONLY)

0'-0" COL.
2'-5 3/4" A
3'-3 1/4" B
7'-4 3/4" C
10'-1 1/2" D
10'-2 1/4" E
16'-4 1/4" F
16'-9" COL.
19'-4 1/4" G
20'-7 1/4" H
24'-7 3/4" I
24'-8 1/2" J
26'-5 1/4" K
27'-6 3/4" L
23'-1 1/2" M
23'-11" CH
24'-8 1/2" N
33'-4" COL.

37'-9" E.O.S.
(2ND & 3RD FLOOR ONLY)
37'-9" E.O.S.
4" #5 FLOOR ONLY