


- NOTES:
1. SEE 1/8" BLDG. PLANS FOR COL. & SHEAR WALL LOCATIONS.
 2. ALL DROPPED CLOS. ARE 7'-0" UNLESS OTHERWISE NOTED.
 3. ALL DIMENSIONS ARE FROM CENTERLINE OF WALL.
 4. SEE DETAIL BOOKLET FOR DOOR, WINDOW & FINISH SCHEDULES.
 5. SCREEN DOT TEXTURE DENOTES PAVERS, CER. TILE, VINYL TILE OR VAT. SEE FINISH SCHEDULE FOR EXACT LOCATION.
 6. VERIFY EXACT LOCATION OF LAYS. W/ ARCHITECT.
 7. DASHED LINE ABOVE THE WASHER/DRYER IS A CONTINUOUS UPPER CABINET W/ DOORS. CONSTRUCTION IS TO BE PER KITCHEN UPPER CABINETS EXCEPT DELETE ALL WOOD TRIM. FULLS TO BE RECESSED OAK.
 8. SEE SHEET A-9 FOR PLAN DIMENSIONING KEY.

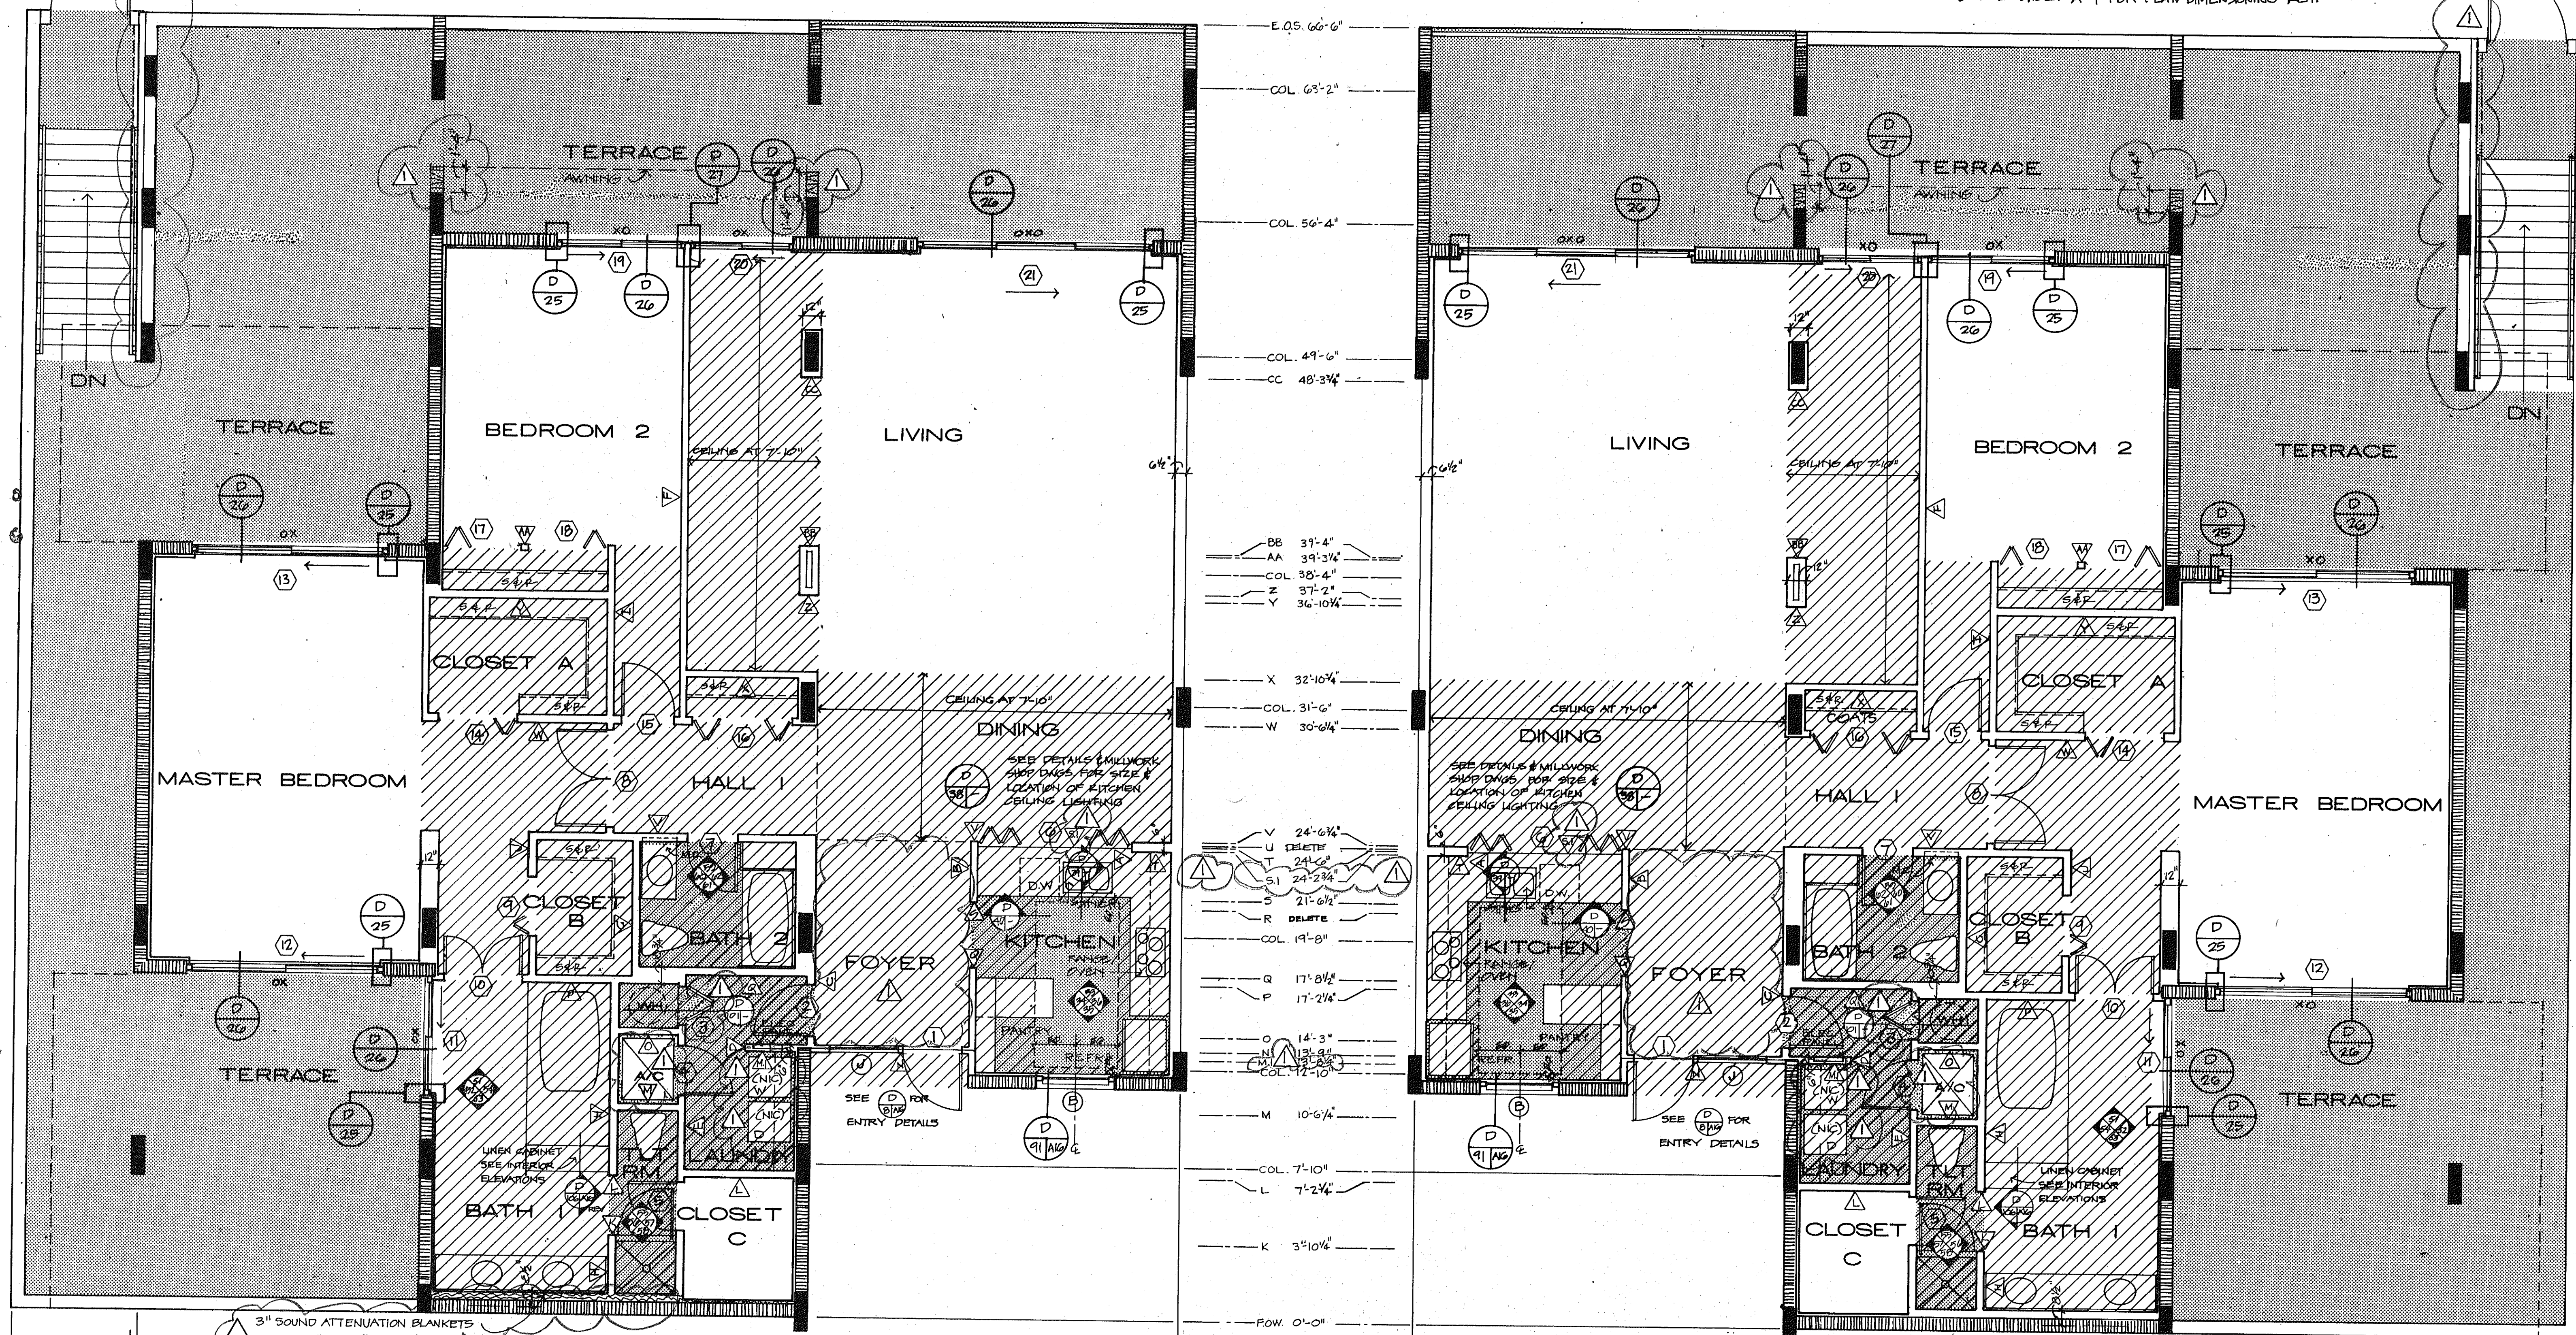

BB 31'-4"
AA 39'-3/4"
COL 38'-4"
Z 37'-2"
Y 36'-10 1/4"

X 32'-10 1/4"
COL 31'-6"
W 30'-0 1/4"

V 24'-6 1/2"
DELETE
U 24'-6 1/2"
S 24'-2 3/4"
S 21'-6 1/2"
R DELETE
COL 19'-8"

Q 17'-8 1/2"
P 17'-2 1/4"
O 14'-3"
N 13'-8 1/2"
COL 12'-10"

M 10'-6 1/4"
COL 7'-10"
L 7'-2 1/4"

K 3'-10 1/4"
FOW 0'-0"

UNIT D+ LEFT

UNIT D+ RIGHT