



OVERLAYS  
 COMPOSITE  
 OR 50R  
 12 51R  
 52 52

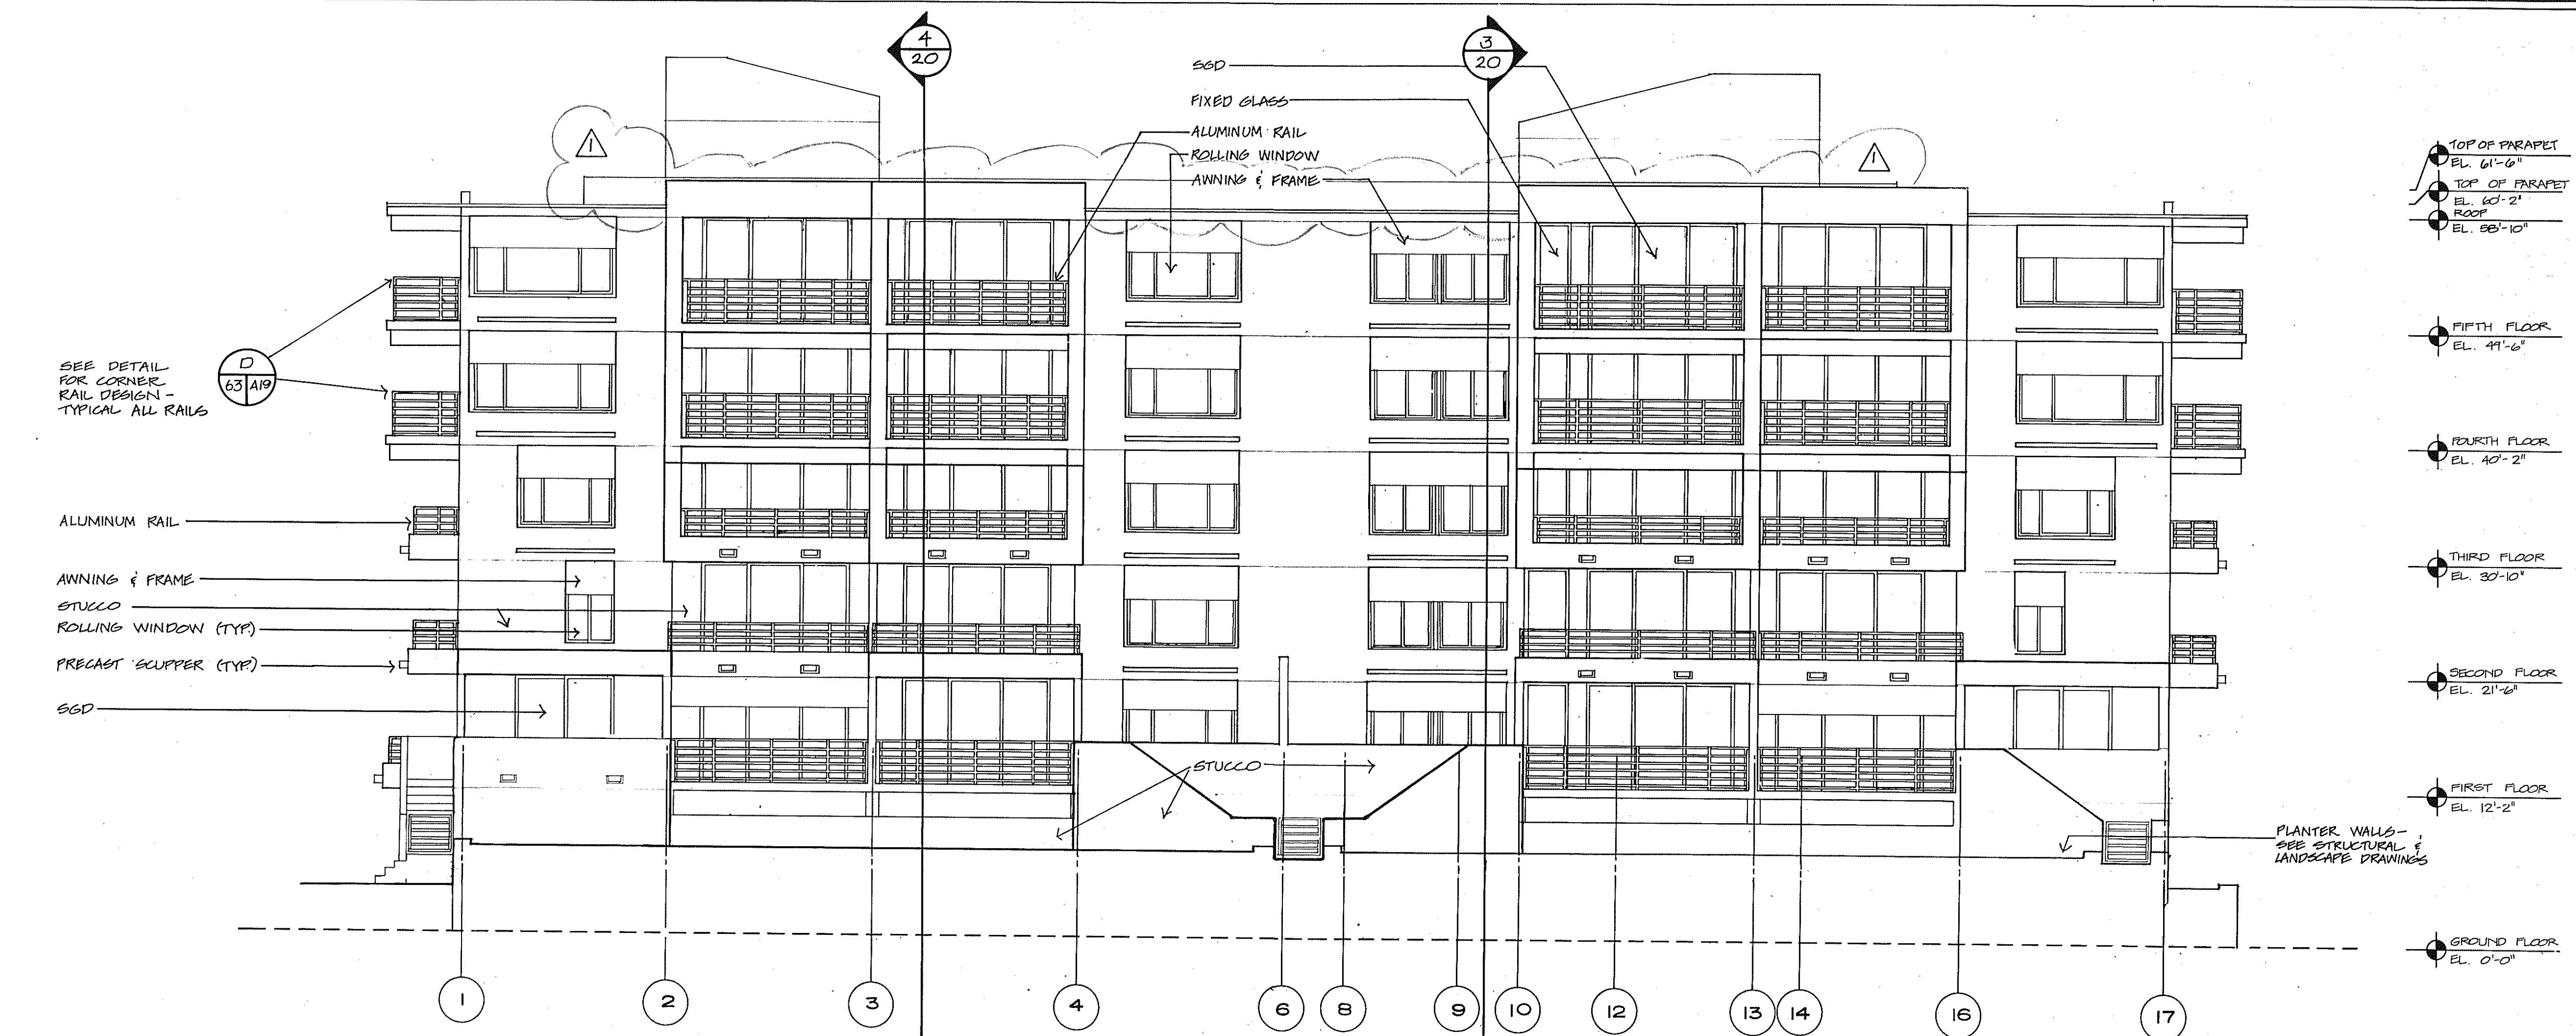

SEE LANDSCAPE PLANS FOR LOCATION & FINISH OF LOW WALLS AND FIN. GRADING (TYPICAL).

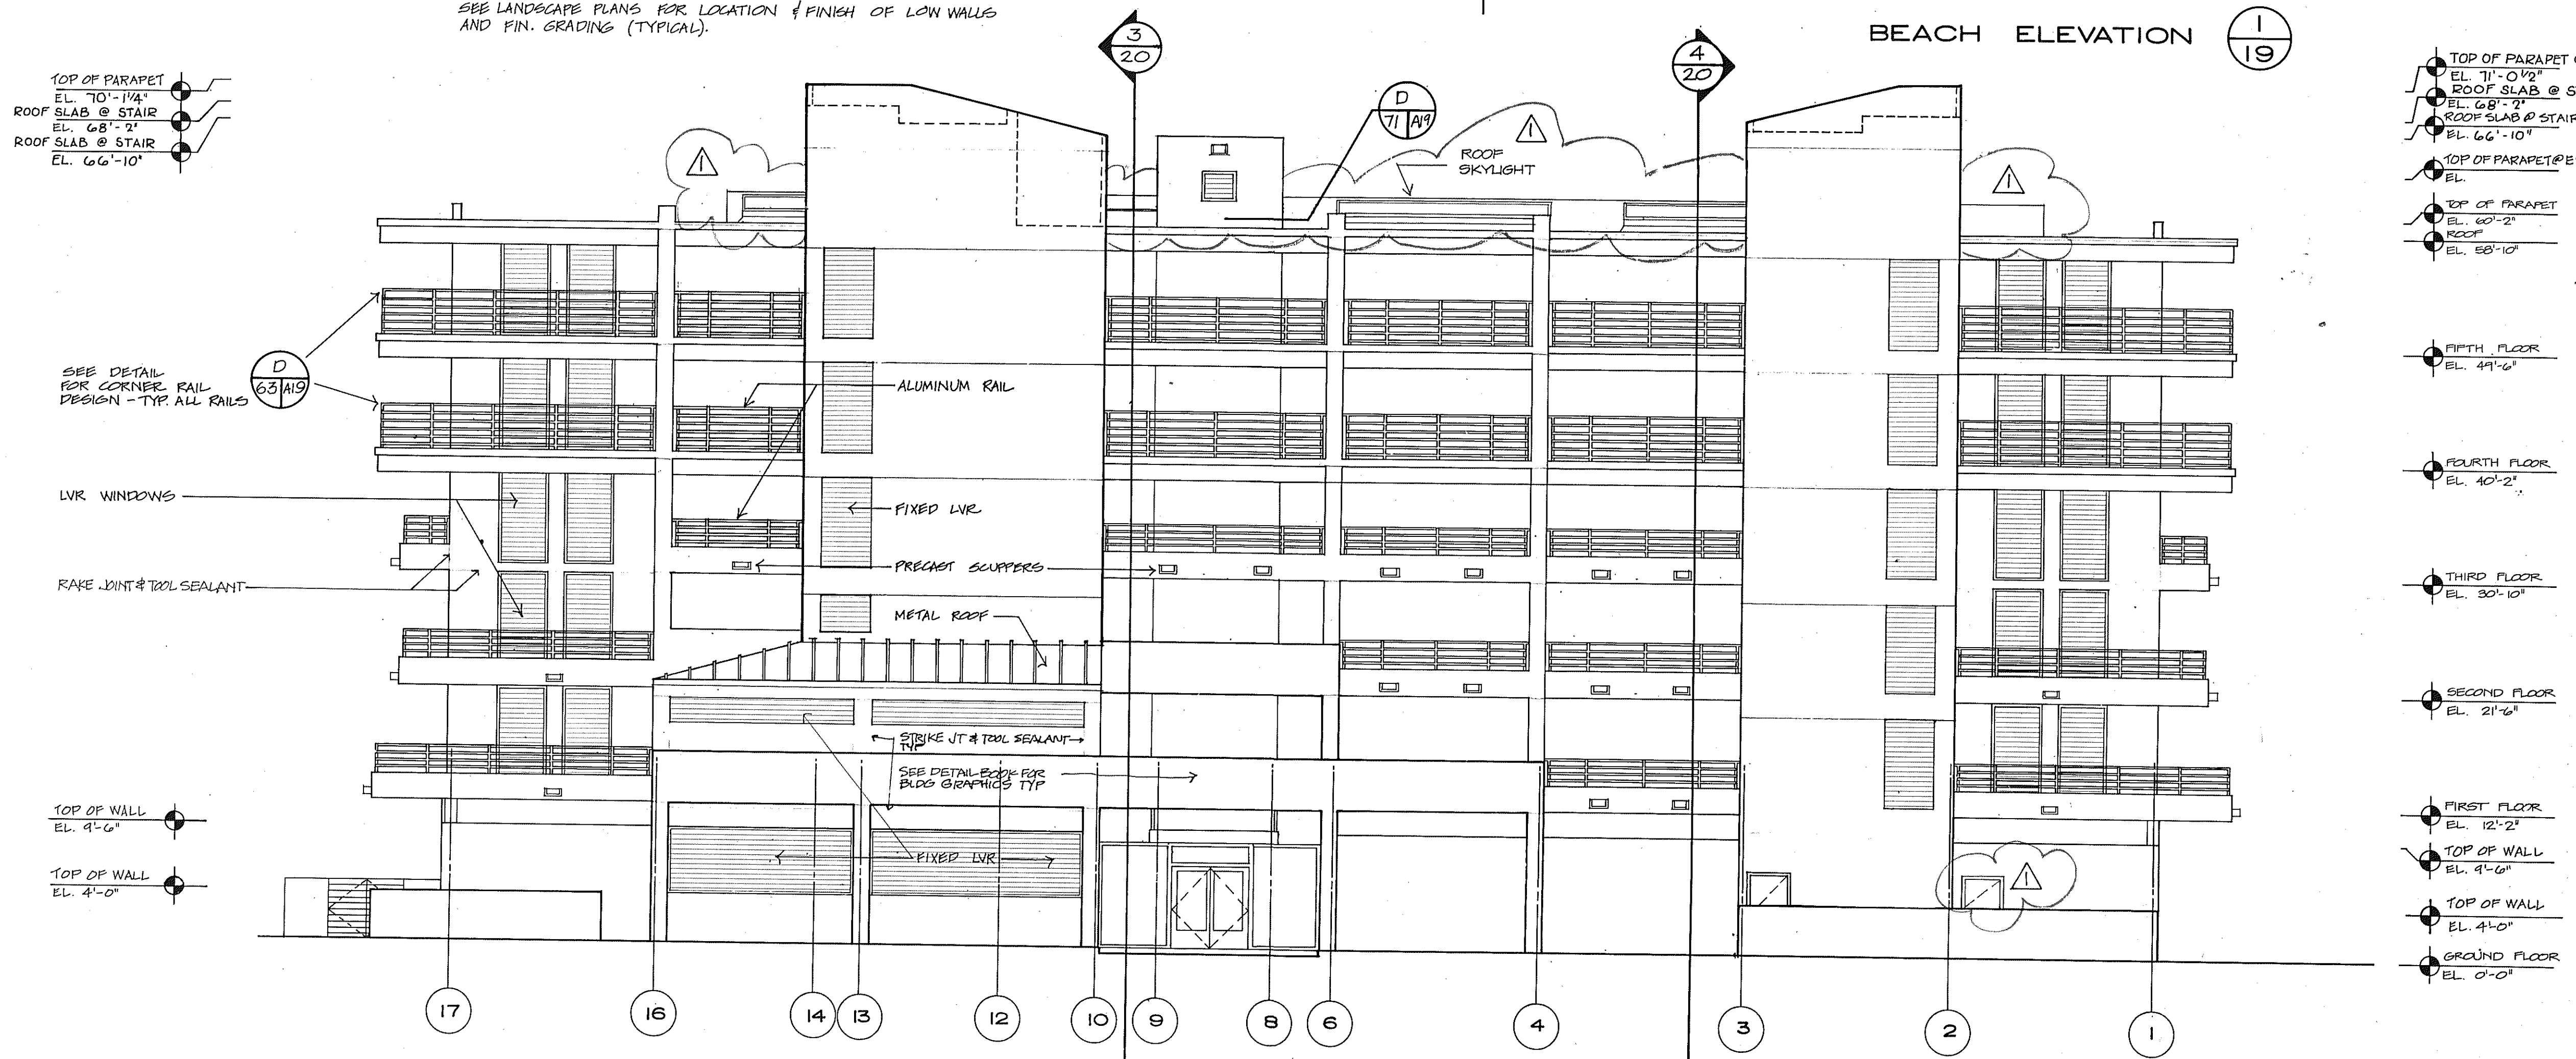

BEACH ELEVATION 1/19

ENTRY ELEVATION 2/19