

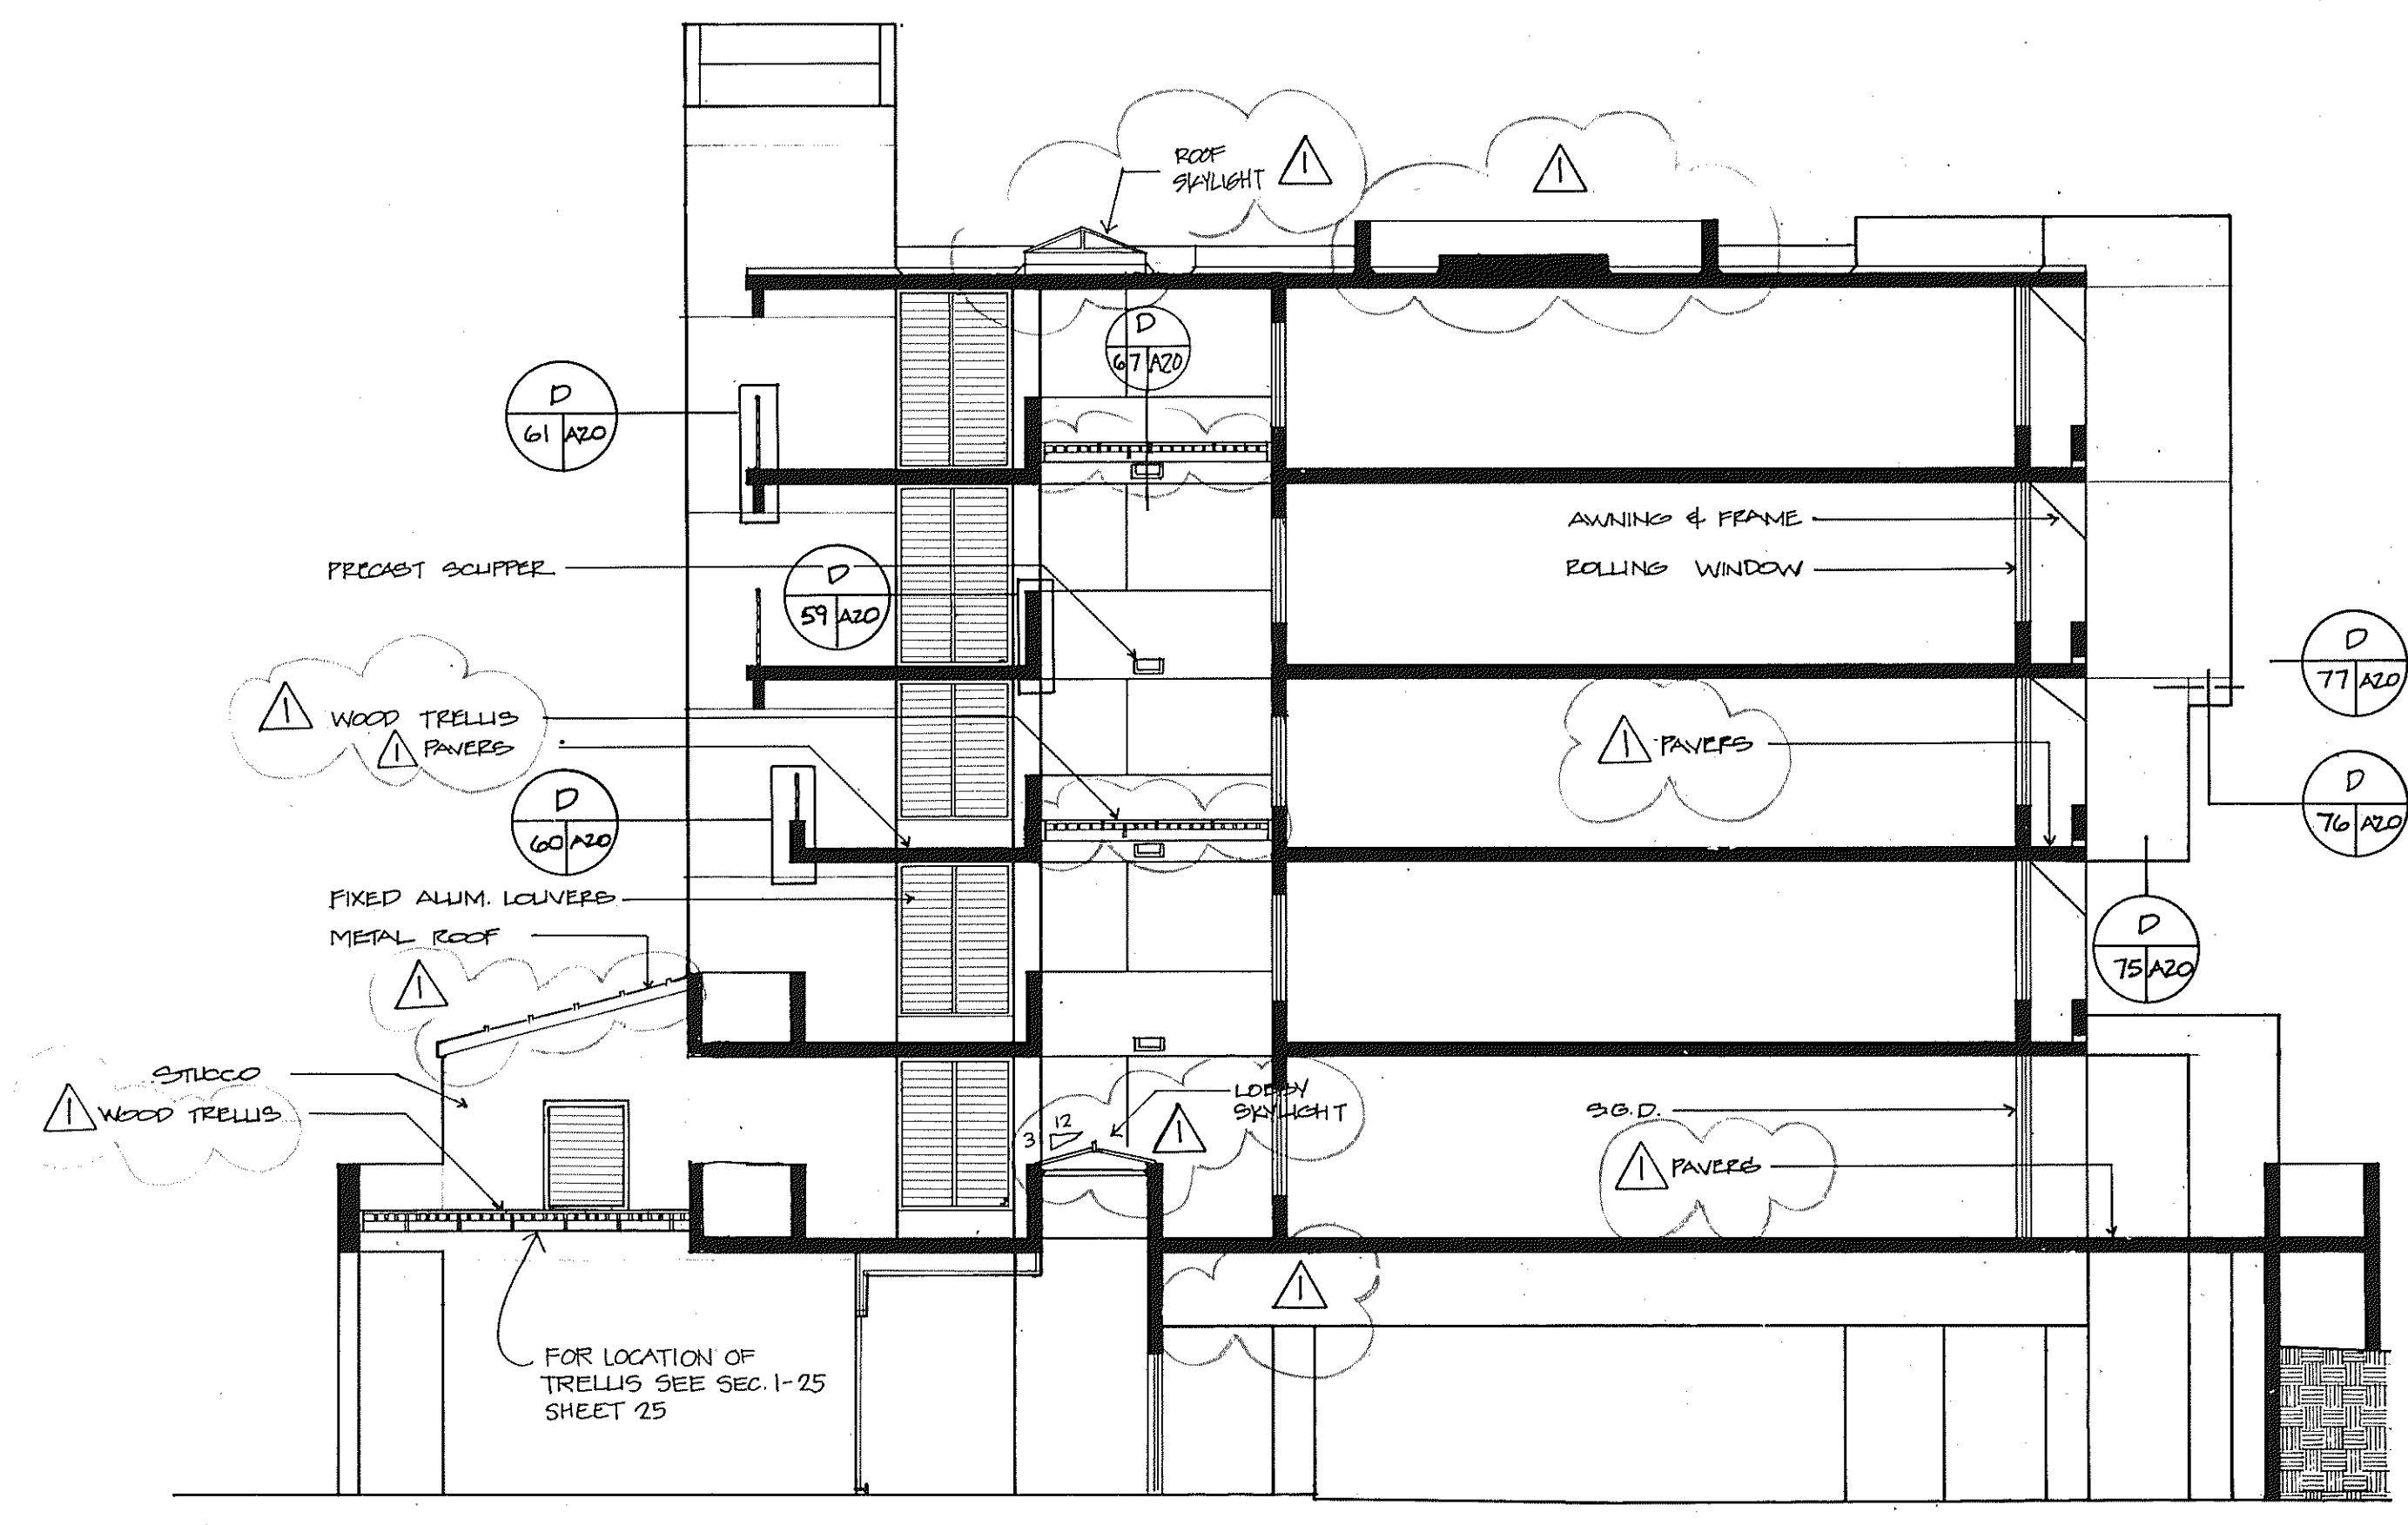



OVERLAYS
 1
 2
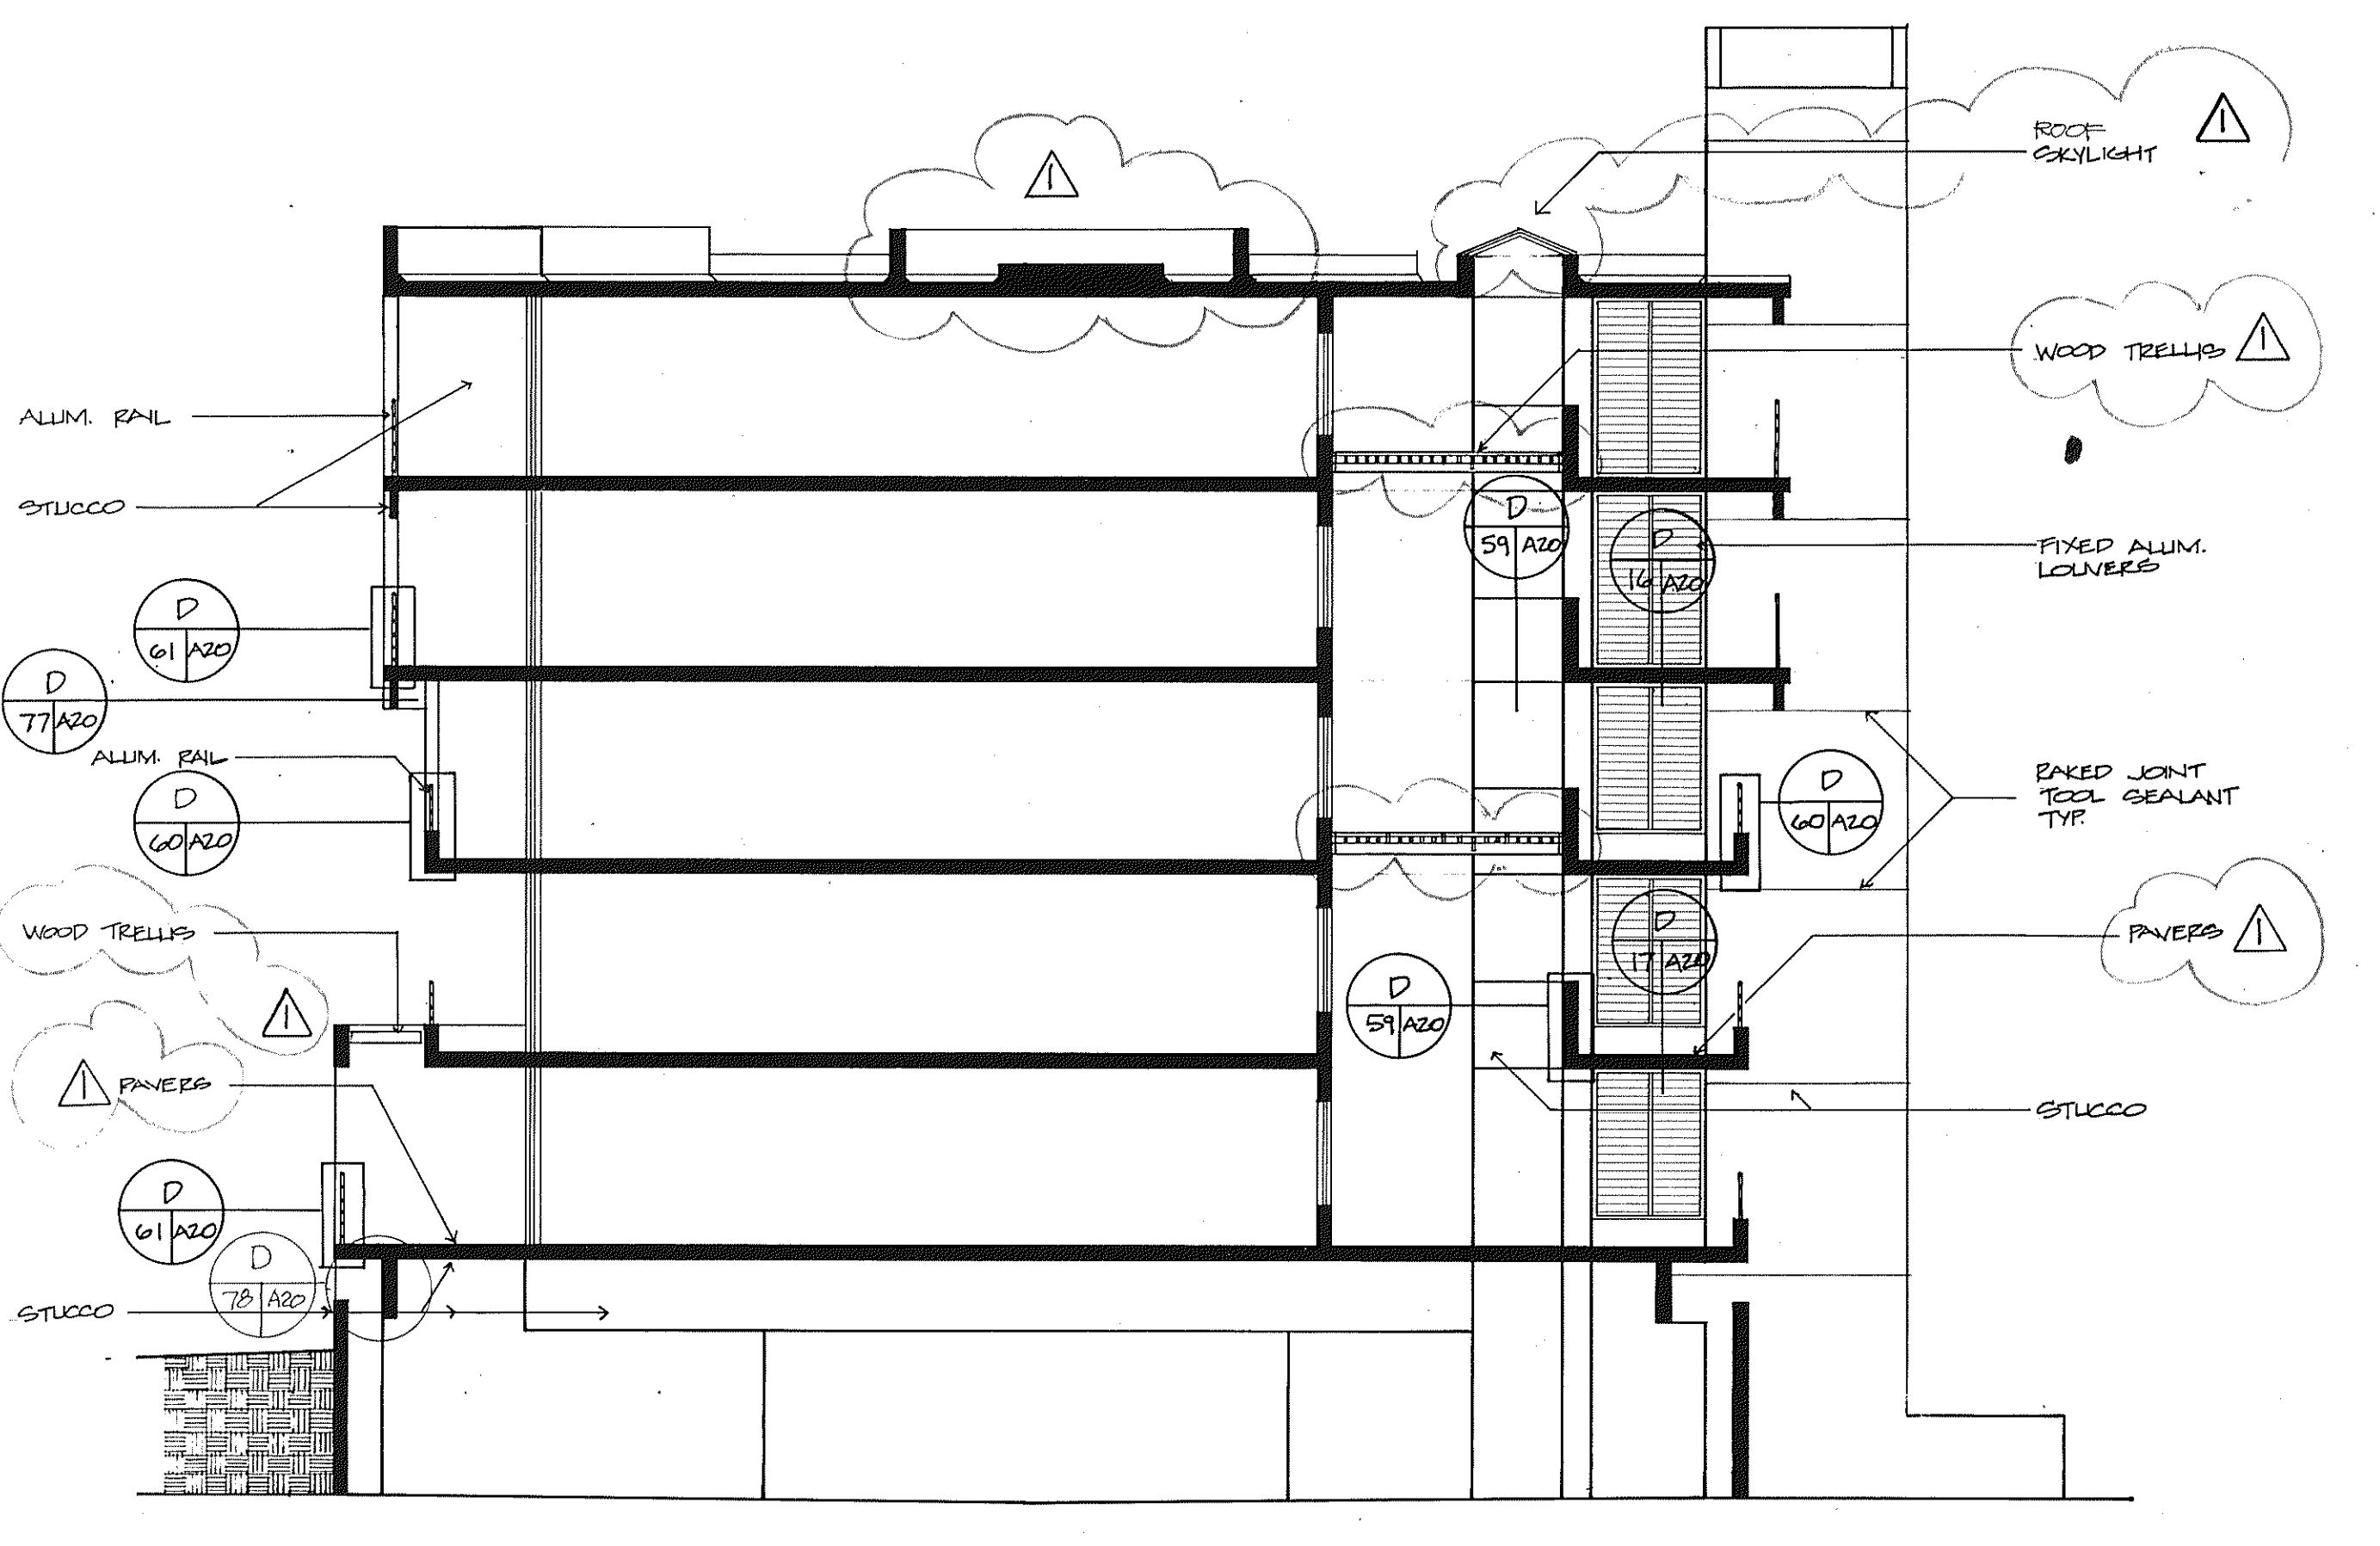


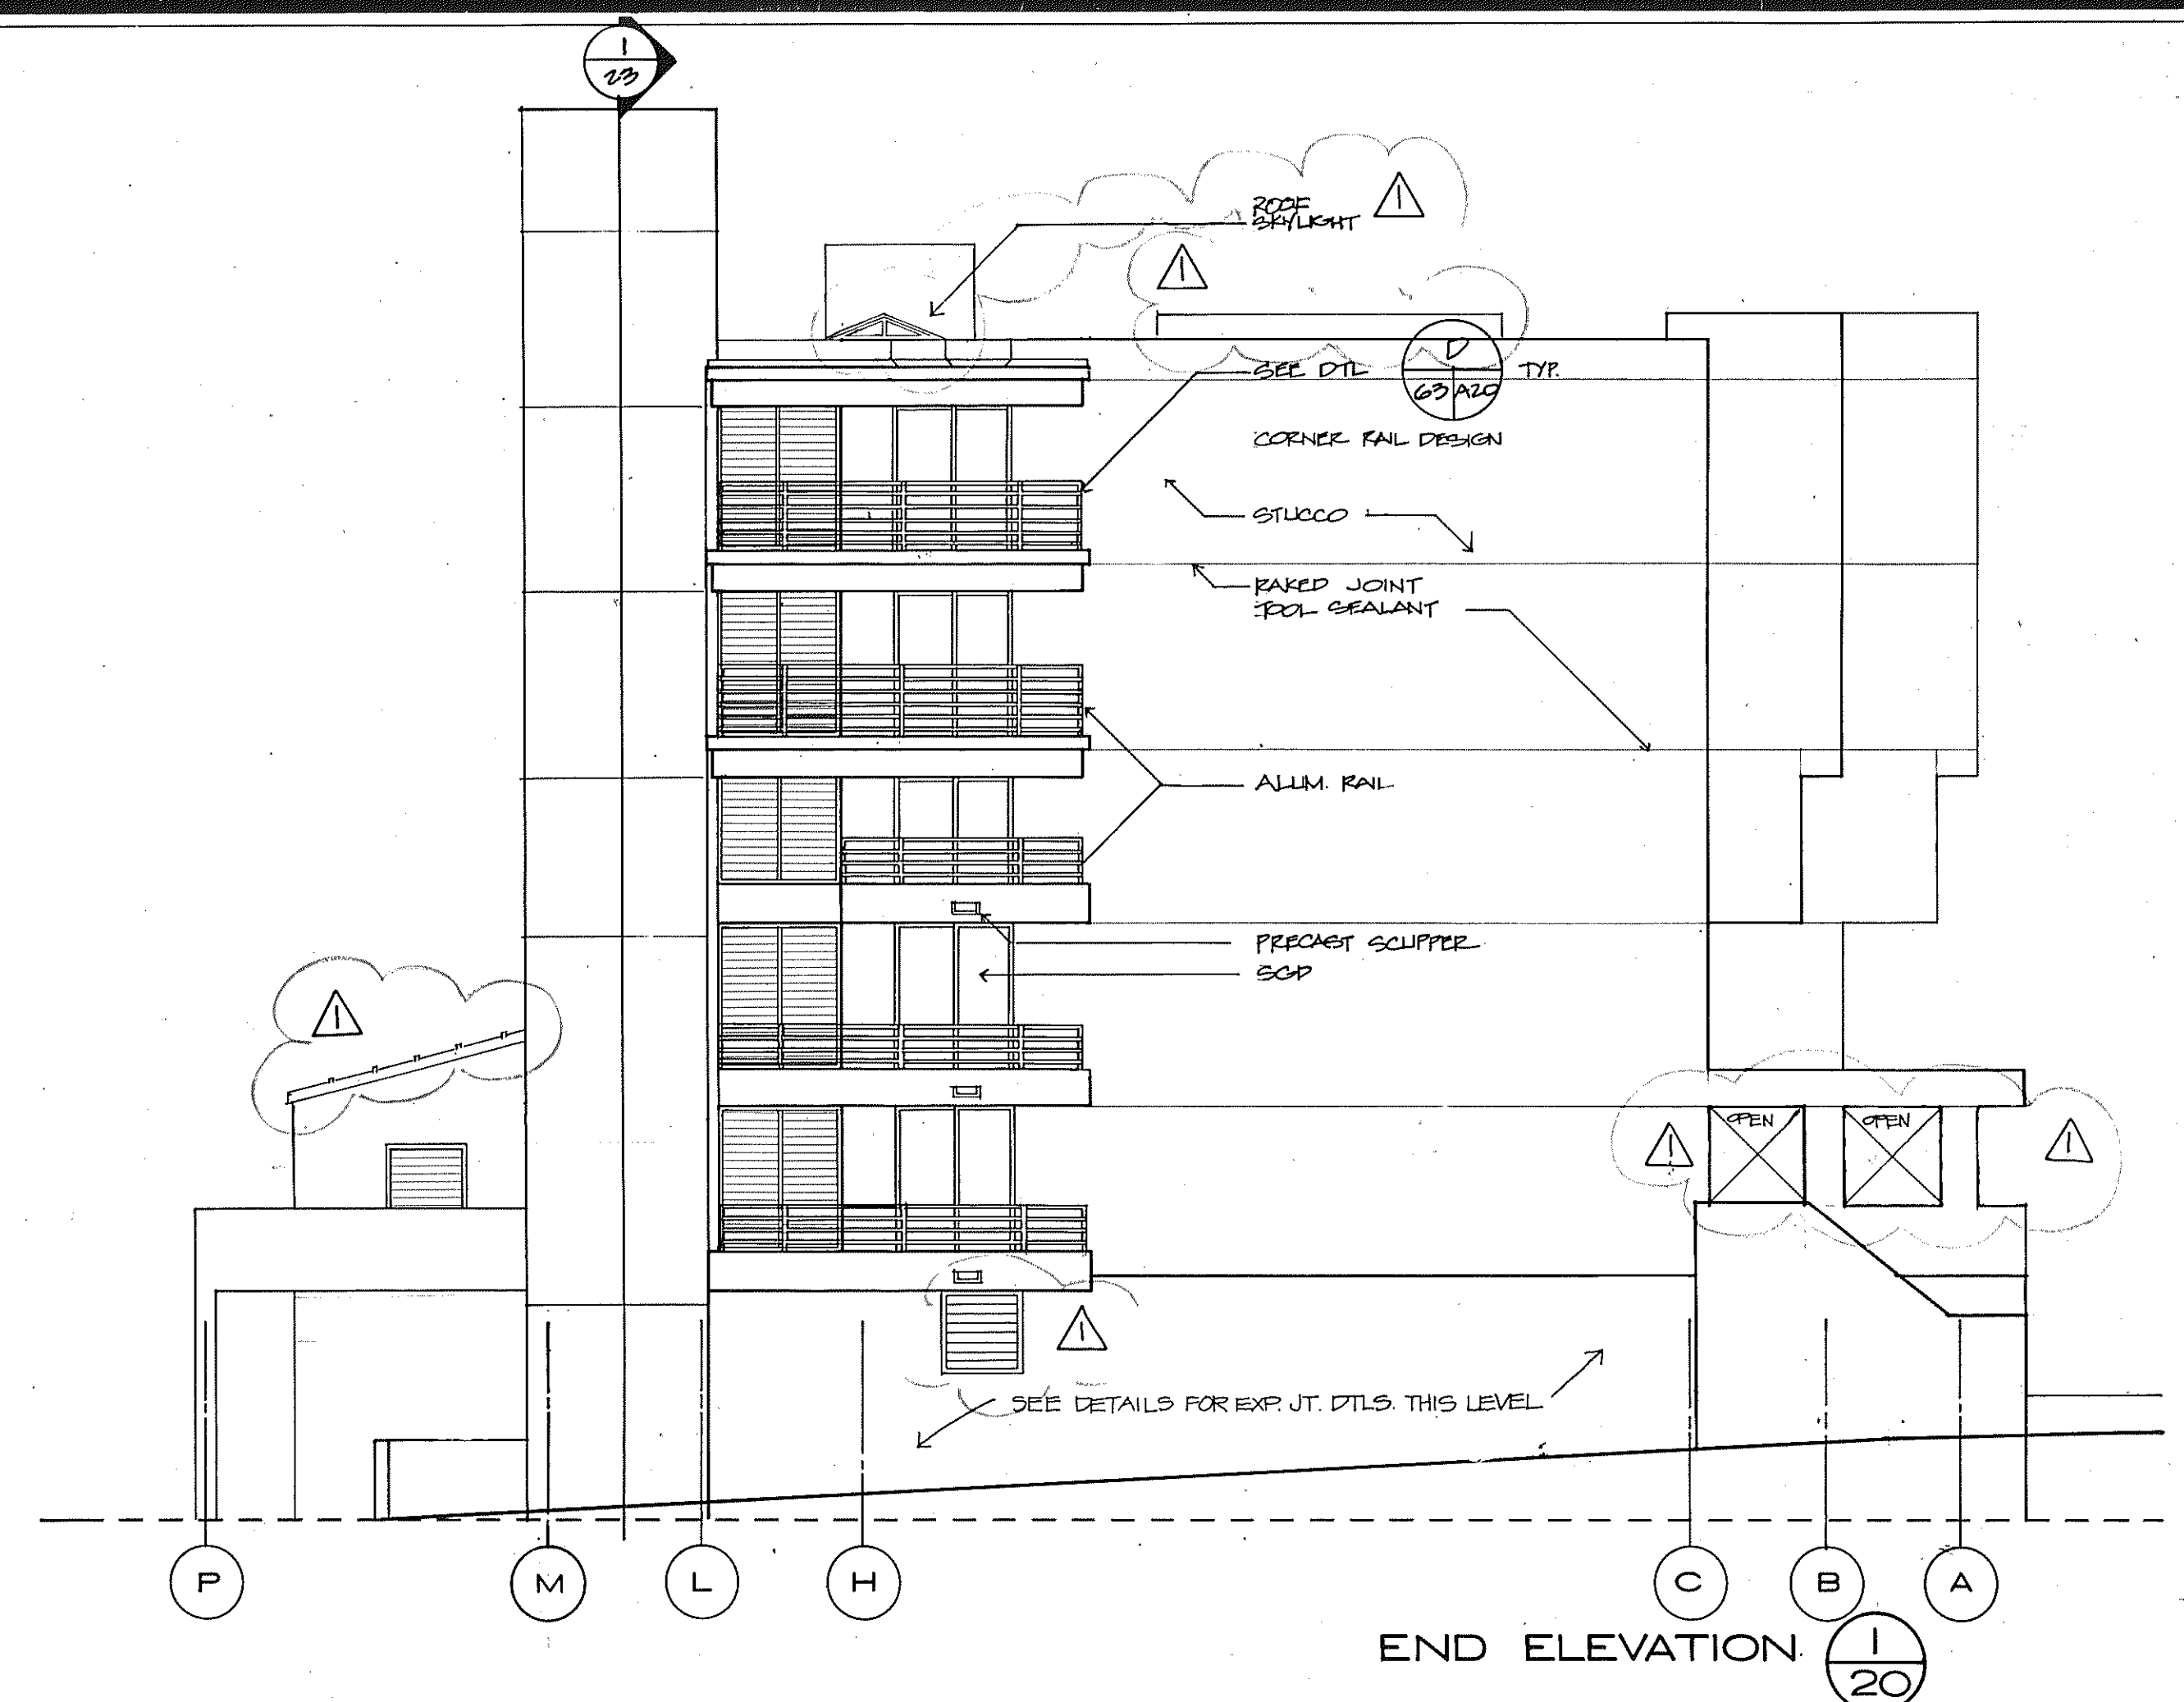


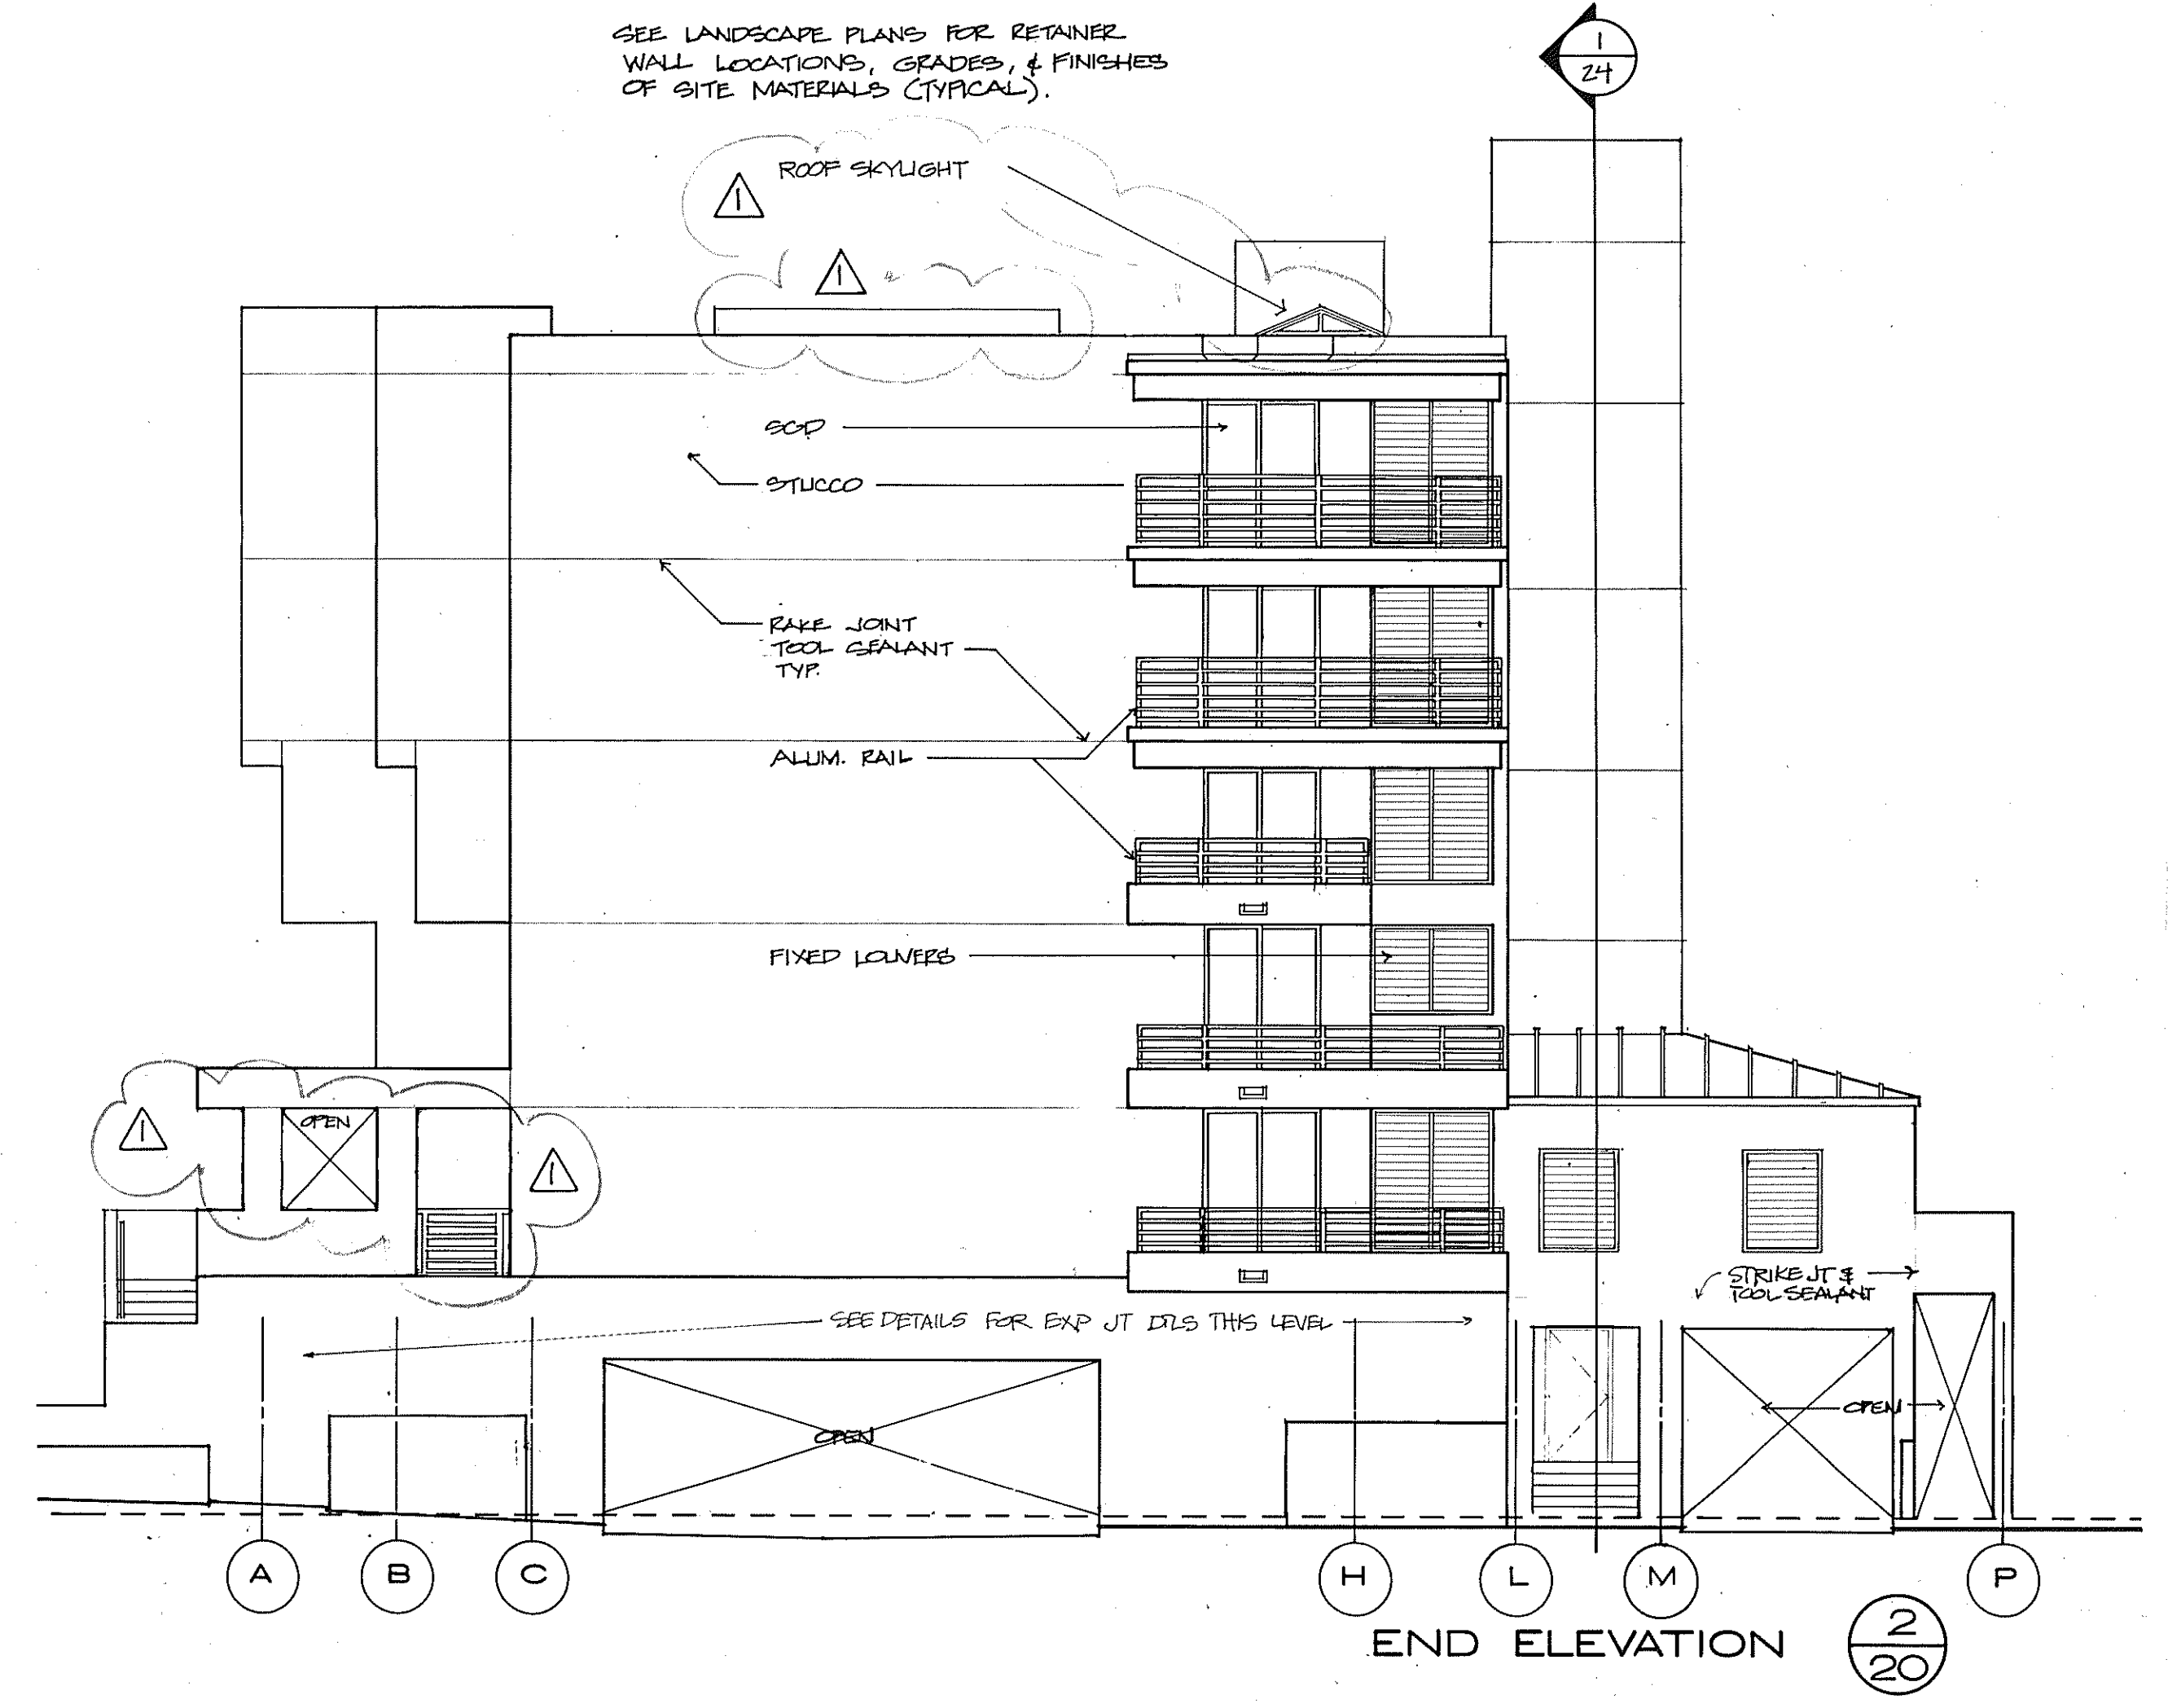

SUNSET BEACH
 SOF LONG BOAT KEY
 BUILDING 2 ELEVATIONS & SECTIONS 1/8" = 1'-0"
 ARVDA CORPORATION EDWARD J. SEBERT AIA ARCHITECT & PLANNER PA THE SWA GROUP
 BRADHAM KUHNIS DEBAY CONSULTING ENGINEERS OLSEN WHITE & ASSOCIATES STRUCTURAL ENGINEERS BENNETT & BISHOP INC CONSULTING ENGINEERS & SURVEYORS
 ISSUED 10 DEC. 82
 REVISED 4-1-83
 SHEET A-20 OF 37