


OVERLAYS

COMPOSITE

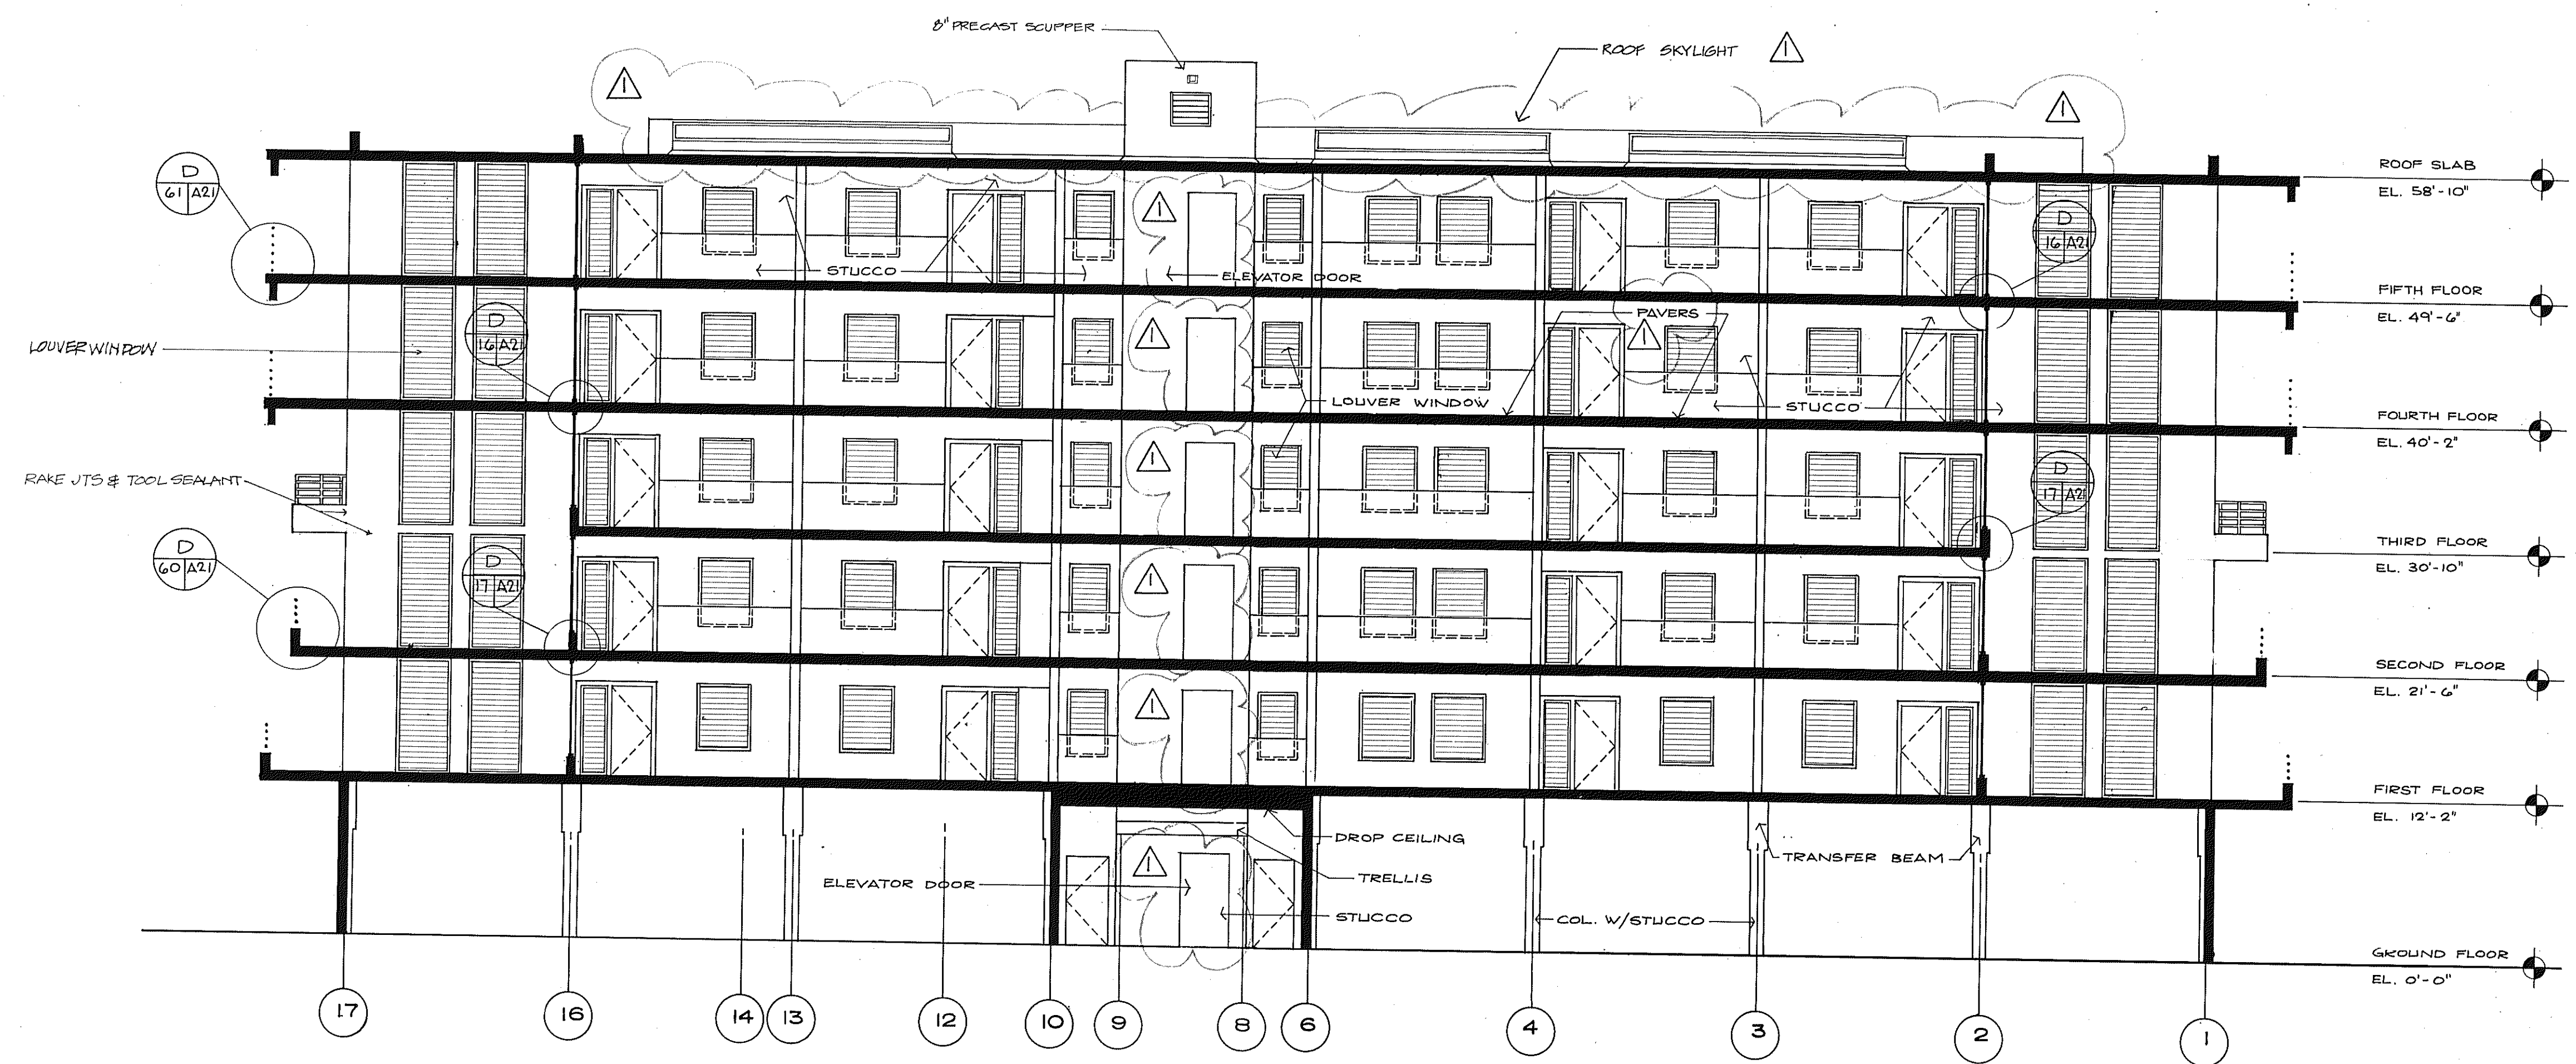

SUNSET BEACH
 BOAT KEY
 SOF LONG

BUILDING 2 BUILDING SECTION 1/8" = 1'-0"
 ARVIDA CORPORATION · EDWARD J. SEIBERT AIA ARCHITECT & PLANNER PA · THE SWA GROUP
 BRABHAM, KUHNS DEBAY CONSULTING ENGINEERS · OLSEN WHITE & ASSOCIATES STRUCTURAL ENGINEERS · BENNETT & BISHOP INC CONSULTING ENGINEERS & SURVEYORS

ISSUED 10 DEC. 82
 REVISED 4-1-83
 SHEET A-21 OF 37