



OVERLAYS
COMPOSITE

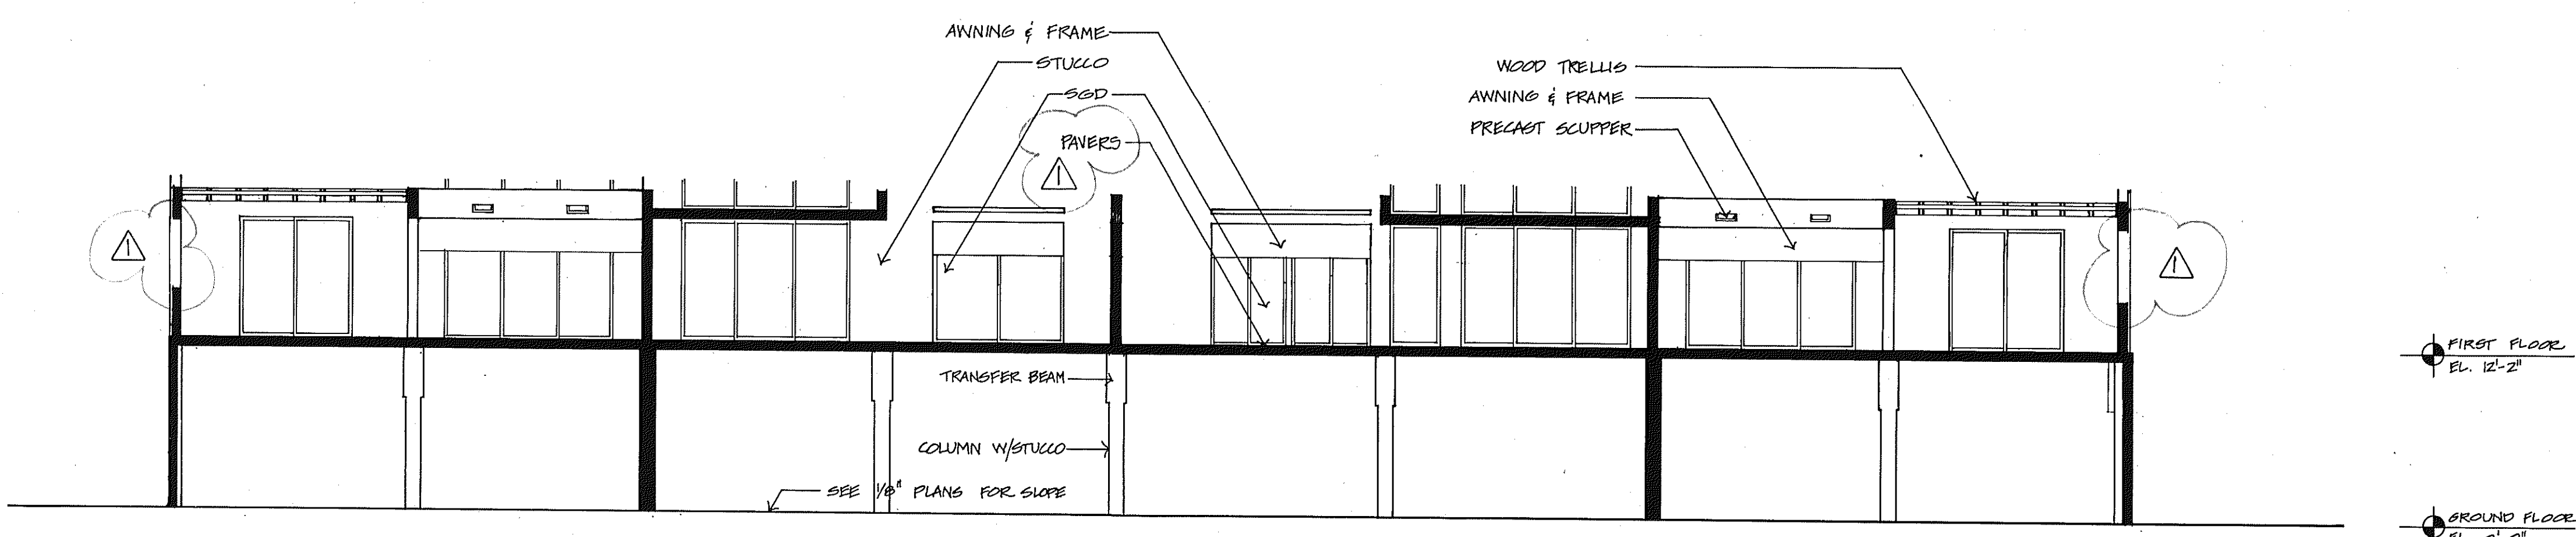

SECTION 1/22

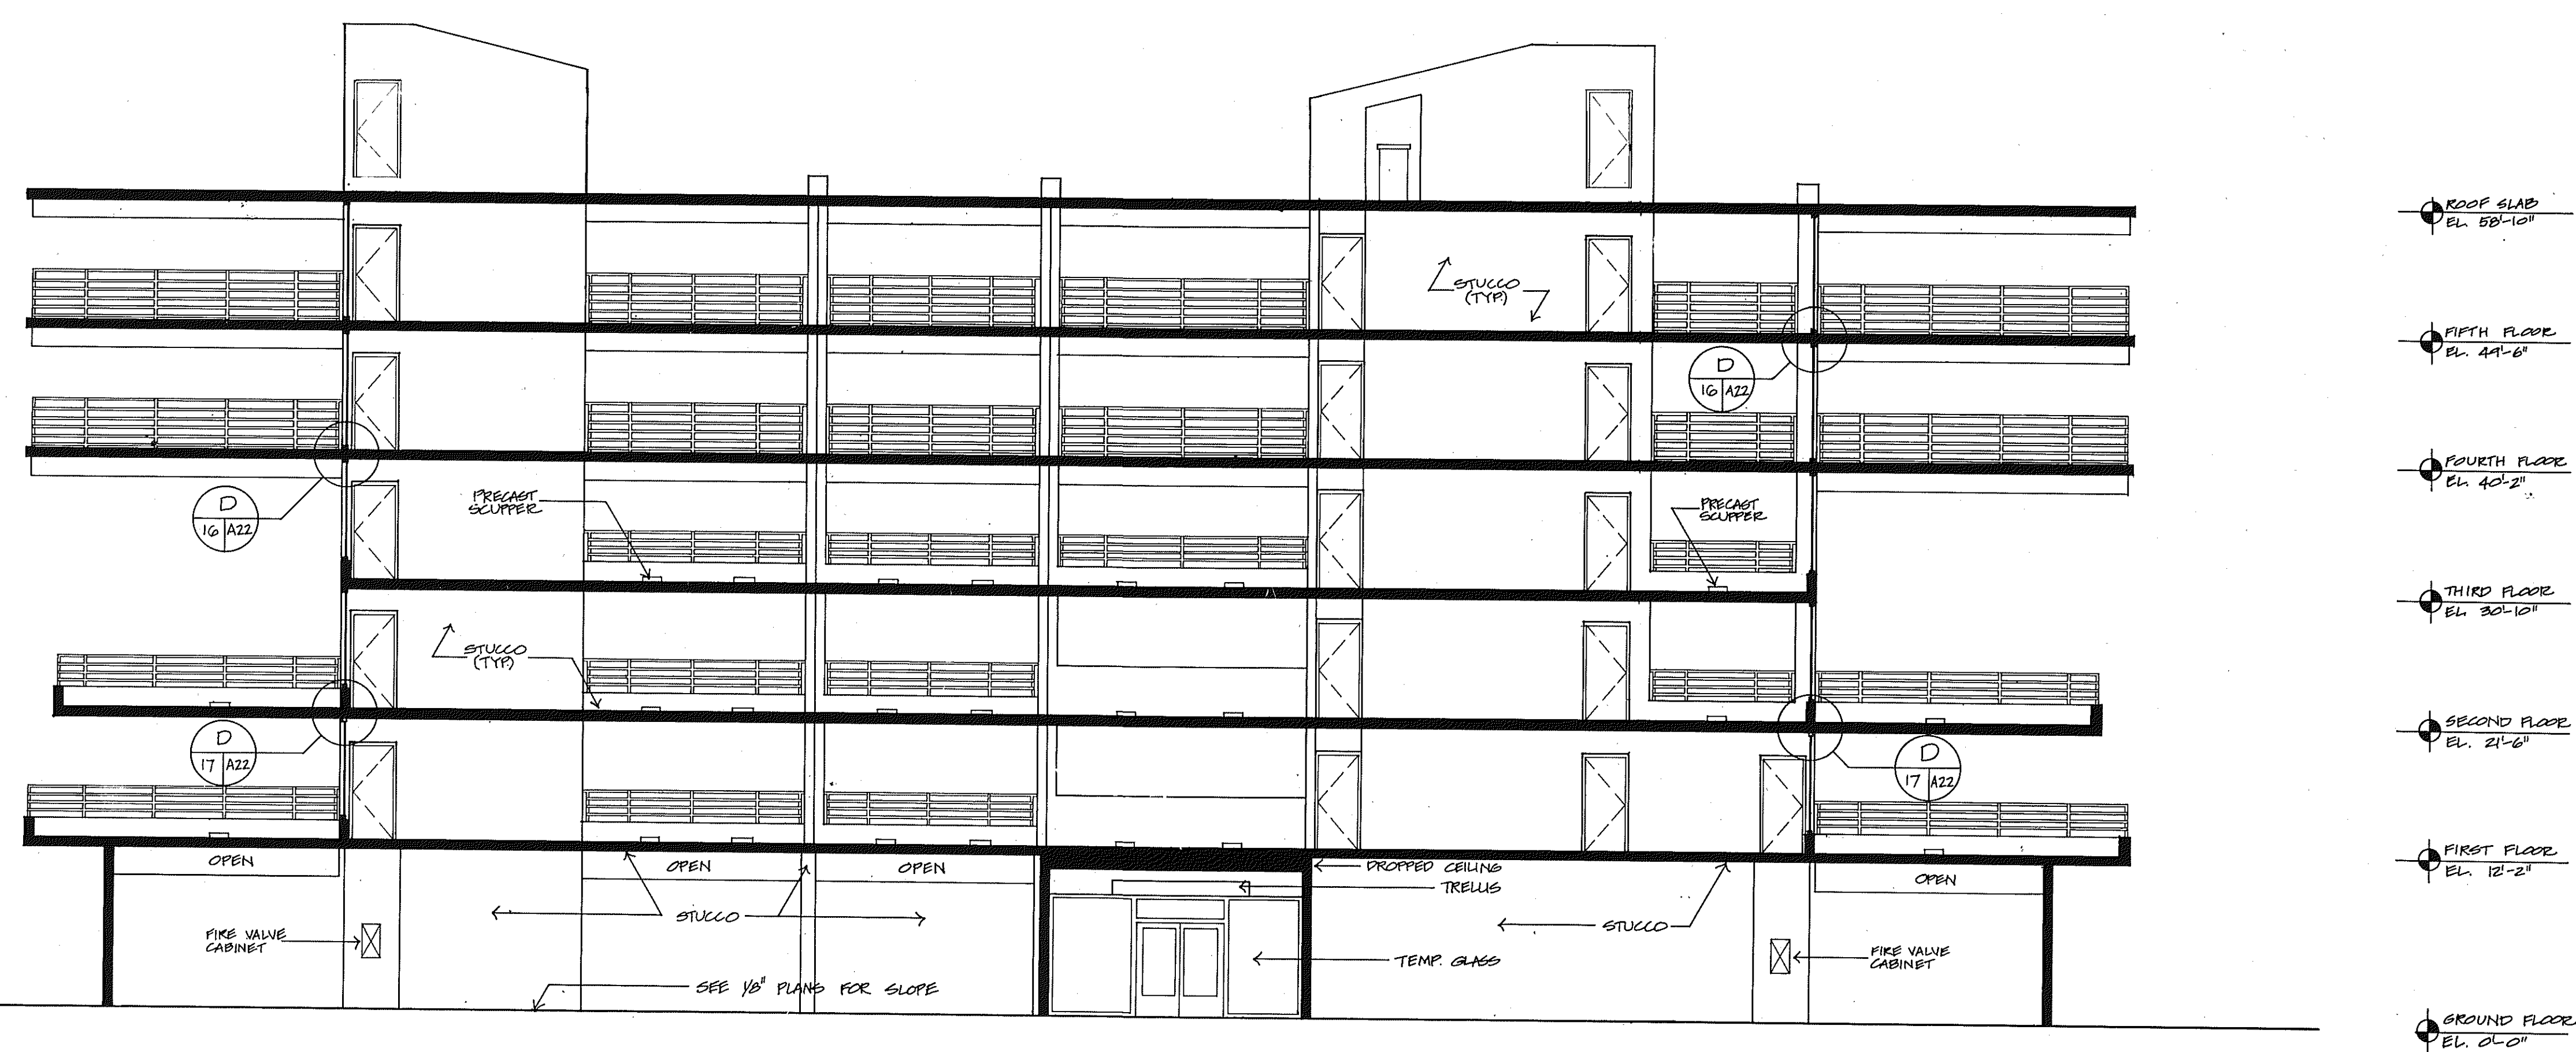

SECTION 2/22

FIRST FLOOR
EL. 12'-2"

GROUND FLOOR
EL. 0'-0"

ROOF SLAB
EL. 58'-10"

FIFTH FLOOR
EL. 44'-6"

FOURTH FLOOR
EL. 40'-2"

THIRD FLOOR
EL. 30'-10"

SECOND FLOOR
EL. 21'-6"

FIRST FLOOR
EL. 12'-2"

GROUND FLOOR
EL. 0'-0"

SUNSET BEACH

BUILDING SECTIONS 1/8" = 1'-0"

ARVADA CORPORATION · EDWARD J. SEIBERT AIA ARCHITECT & PLANNER PA · THE SVA GROUP
BRABHAM KUHN DEBAY CONSULTING ENGINEERS · OLSEN WHITE & ASSOCIATES STRUCTURAL ENGINEERS · BENNETT & BISHOP INC CONSULTING ENGINEERS & SURVEYORS

ISSUED
10 DEC. 82

REVISED
4-1-83

SHEET
A-22
OF 37