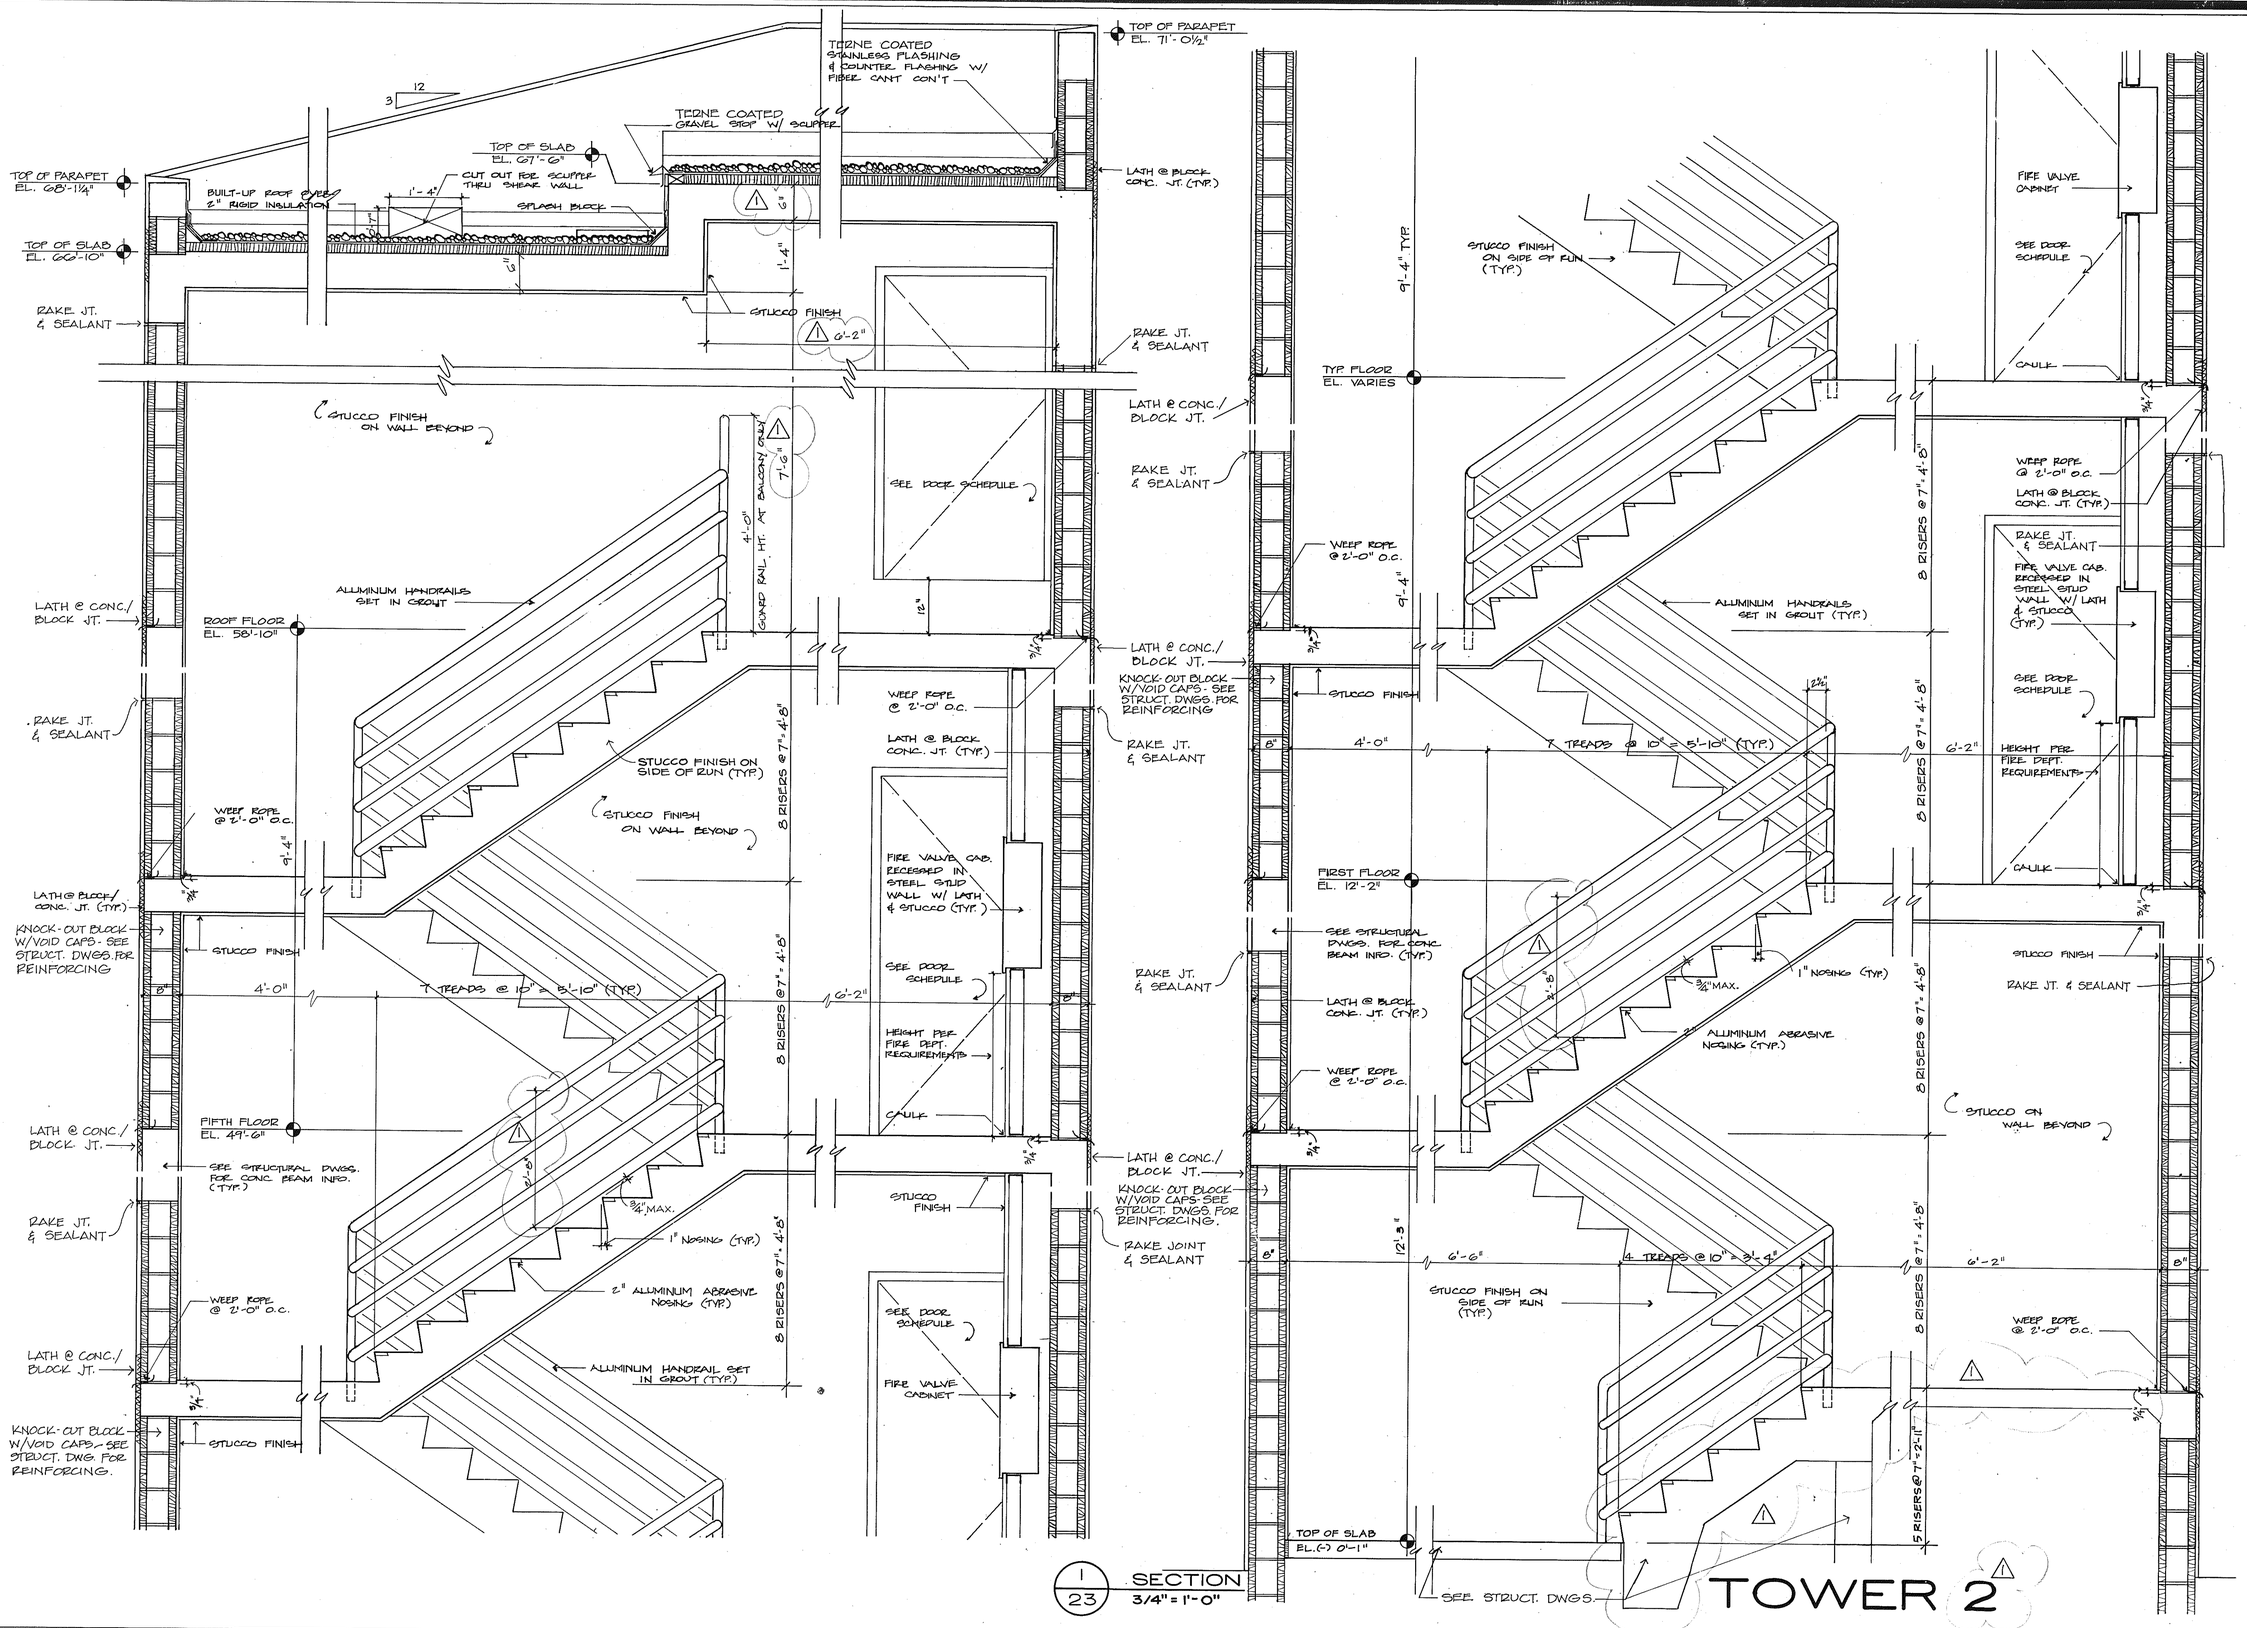

1/23 SECTION
3/4" = 1'-0"

SUNSET BEACH OF LONGBOAT KEY

STAIR SECTIONS 3/4" = 1'-0"

BUILDING 2

ARVIDA CORPORATION · EDWARD J SEIBERT AIA ARCHITECT & PLANNER PA · THE SWA GROUP · BRABHAM KUHNS DEBAY CONSULTING ENGINEERS · OLSEN WHITE & ASSOCIATES STRUCTURAL ENGINEERS · BENNETT & BISHOP INC CONSULTING ENGINEERS & SURVEYORS

ISSUED	10 DEC. 82
REVISED	1 4-1-83

SHEET A·23 OF 37