


COMPOSITE

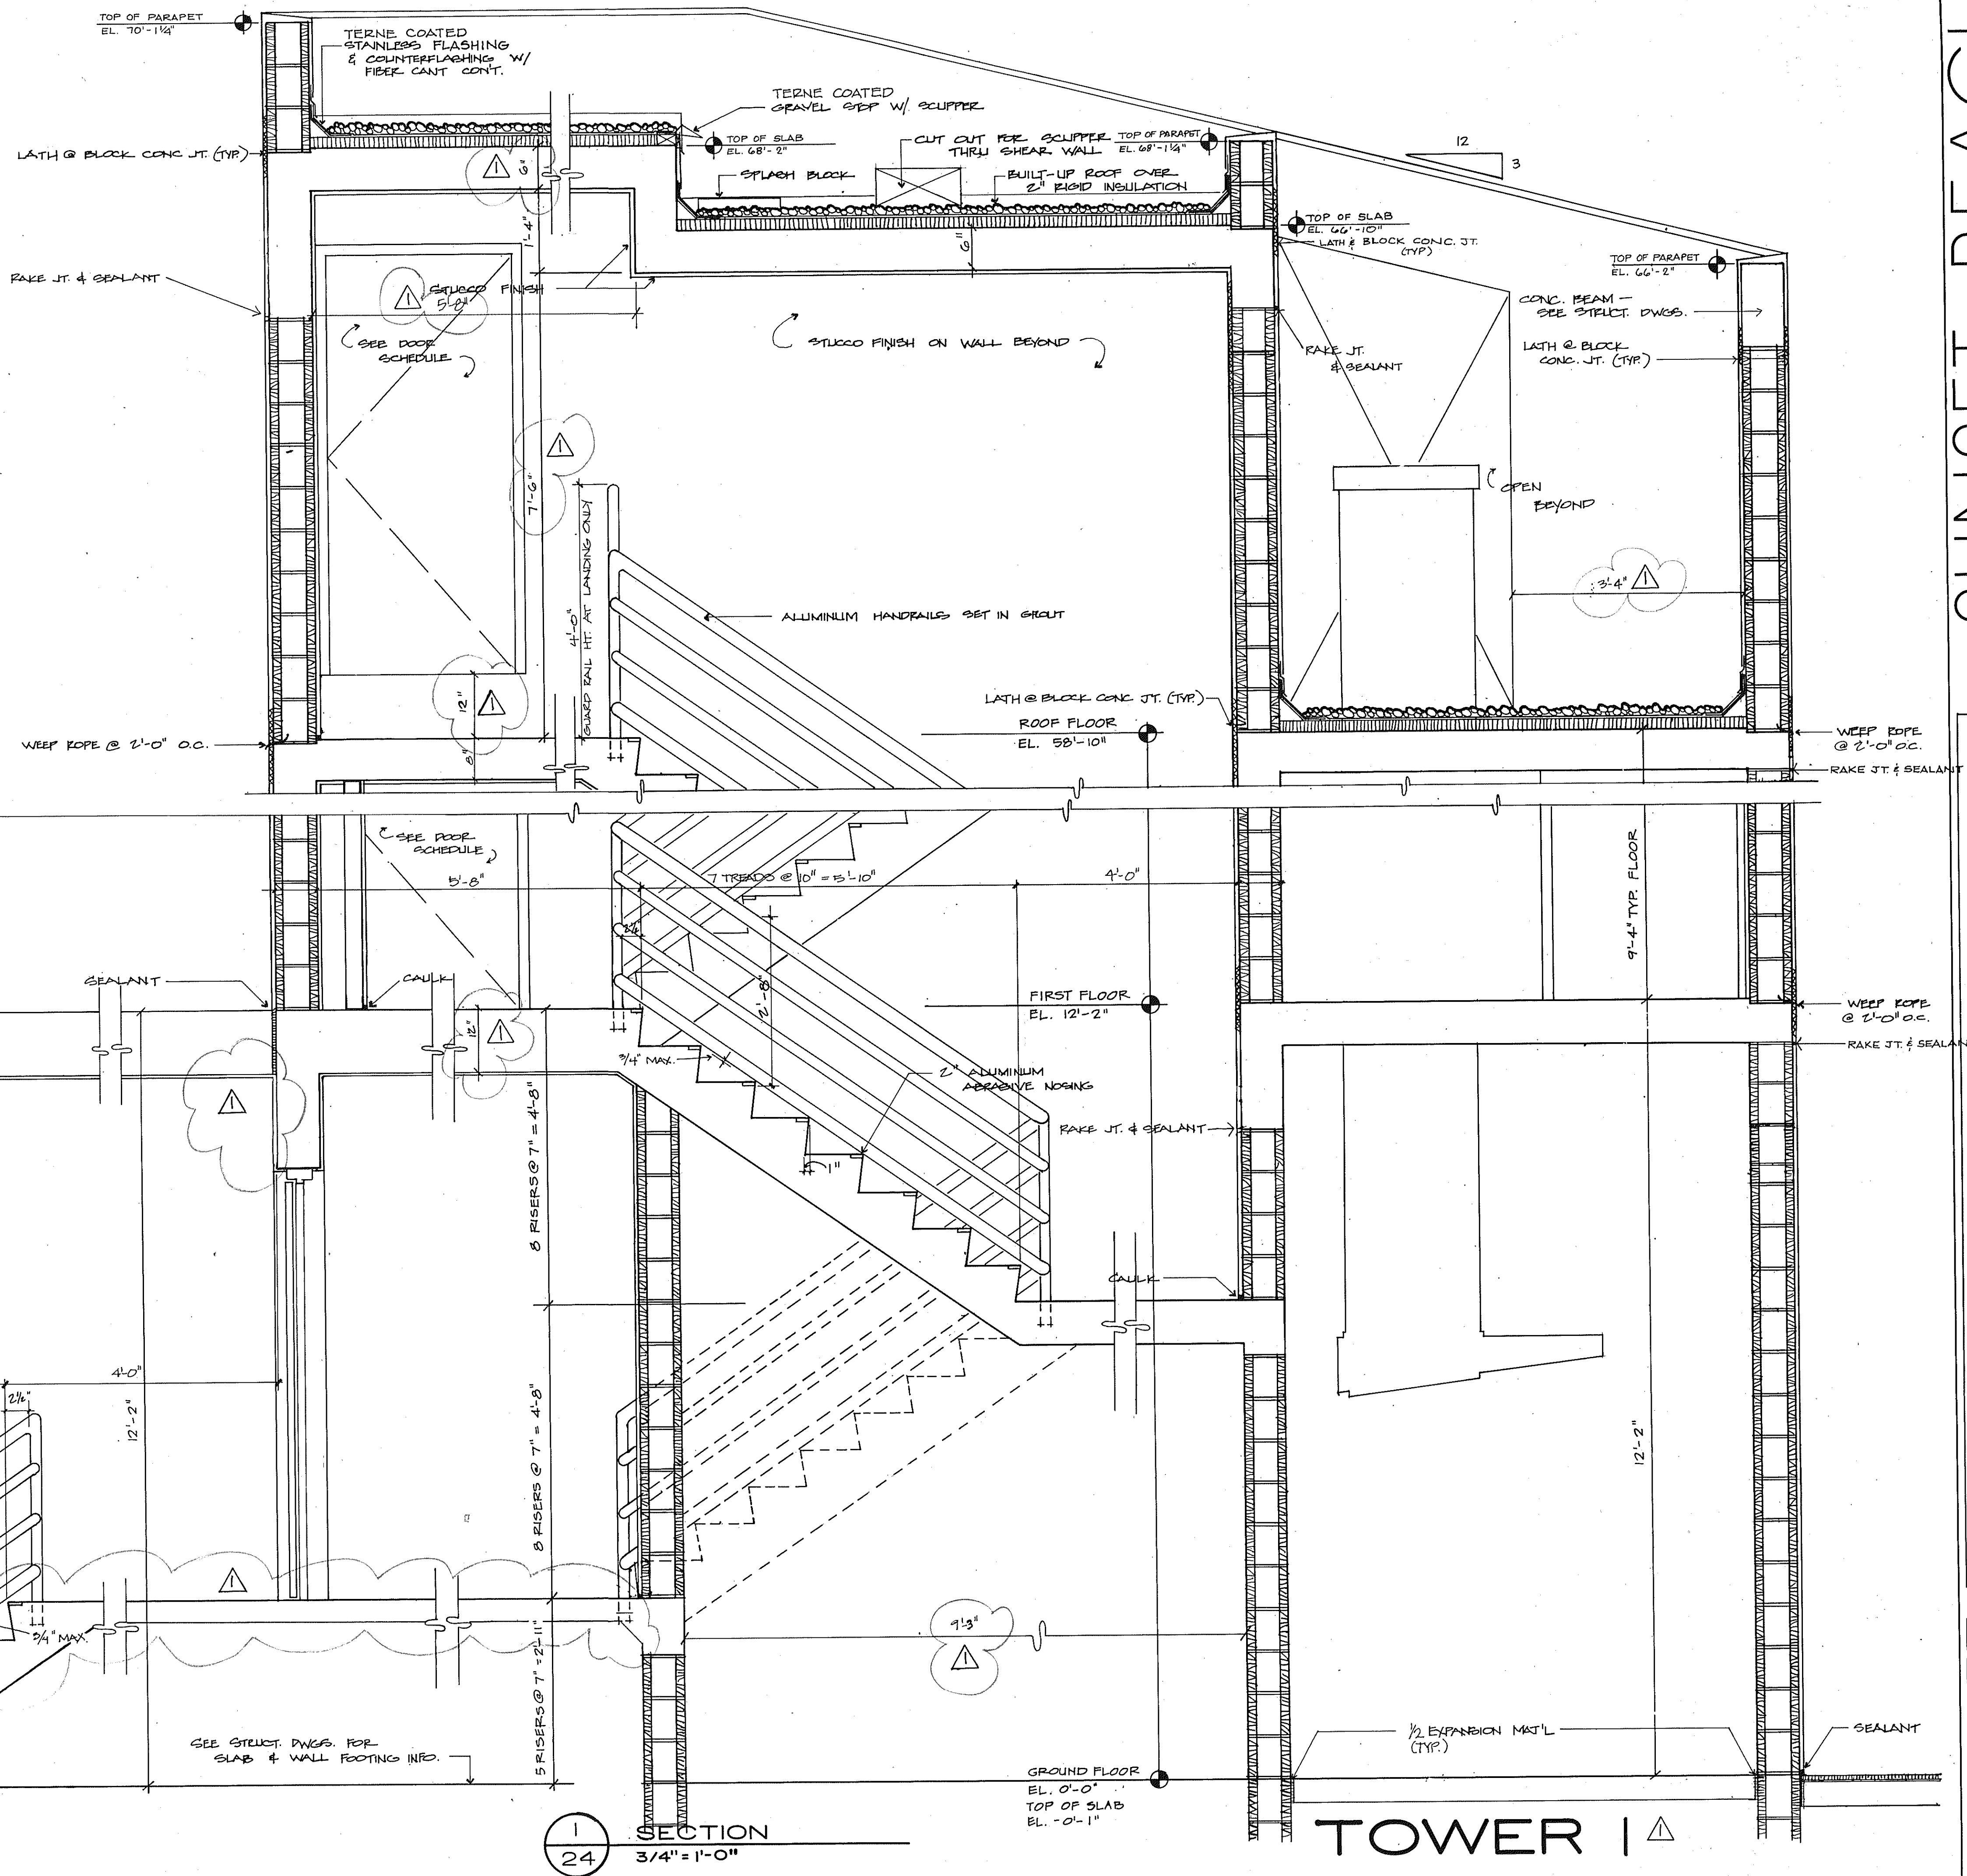

ELEV. EQUIPMENT ROOM

LATH & BLOCK CONC. JT. (TYP.)
 WEEP KOPE @ 2'-0" O.C.
 1/2" EXP. JT. MATERIAL (TYP.)
 STUCCO
 CUT DRIP
 SEE STRUCTURAL DWGS. FOR THIS SLAB AND BEAM

2" ALUMINUM ABRASIVE NOSING

EXPANSION MAT'L

SEE STRUCT. DWGS. FOR SLAB & WALL FOOTING INFO.

GROUND FLOOR
 EL. 0'-0"
 TOP OF SLAB
 EL. -0'-1"

SECTION
 3/4" = 1'-0"

TOWER 1

SUNSET BEACH
 OF LONG BOAT KEY

BUILDING 2
 STAIR SECTIONS 3/4" = 1'-0"
 ARVIDA CORPORATION · EDWARD J. SEIBERT AIA ARCHITECT & PLANNER PA · THE SWA GROUP
 BRABHAM KUHNS DEBAY CONSULTING ENGINEERS · OLSEN WHITE & ASSOCIATES STRUCTURAL ENGINEERS · BENNETT & BISHOP INC CONSULTING ENGINEERS & SURVEYORS

ISSUED	10 DEC. 82
REVISED	4-1-83
SHEET	A-24
	OF 37