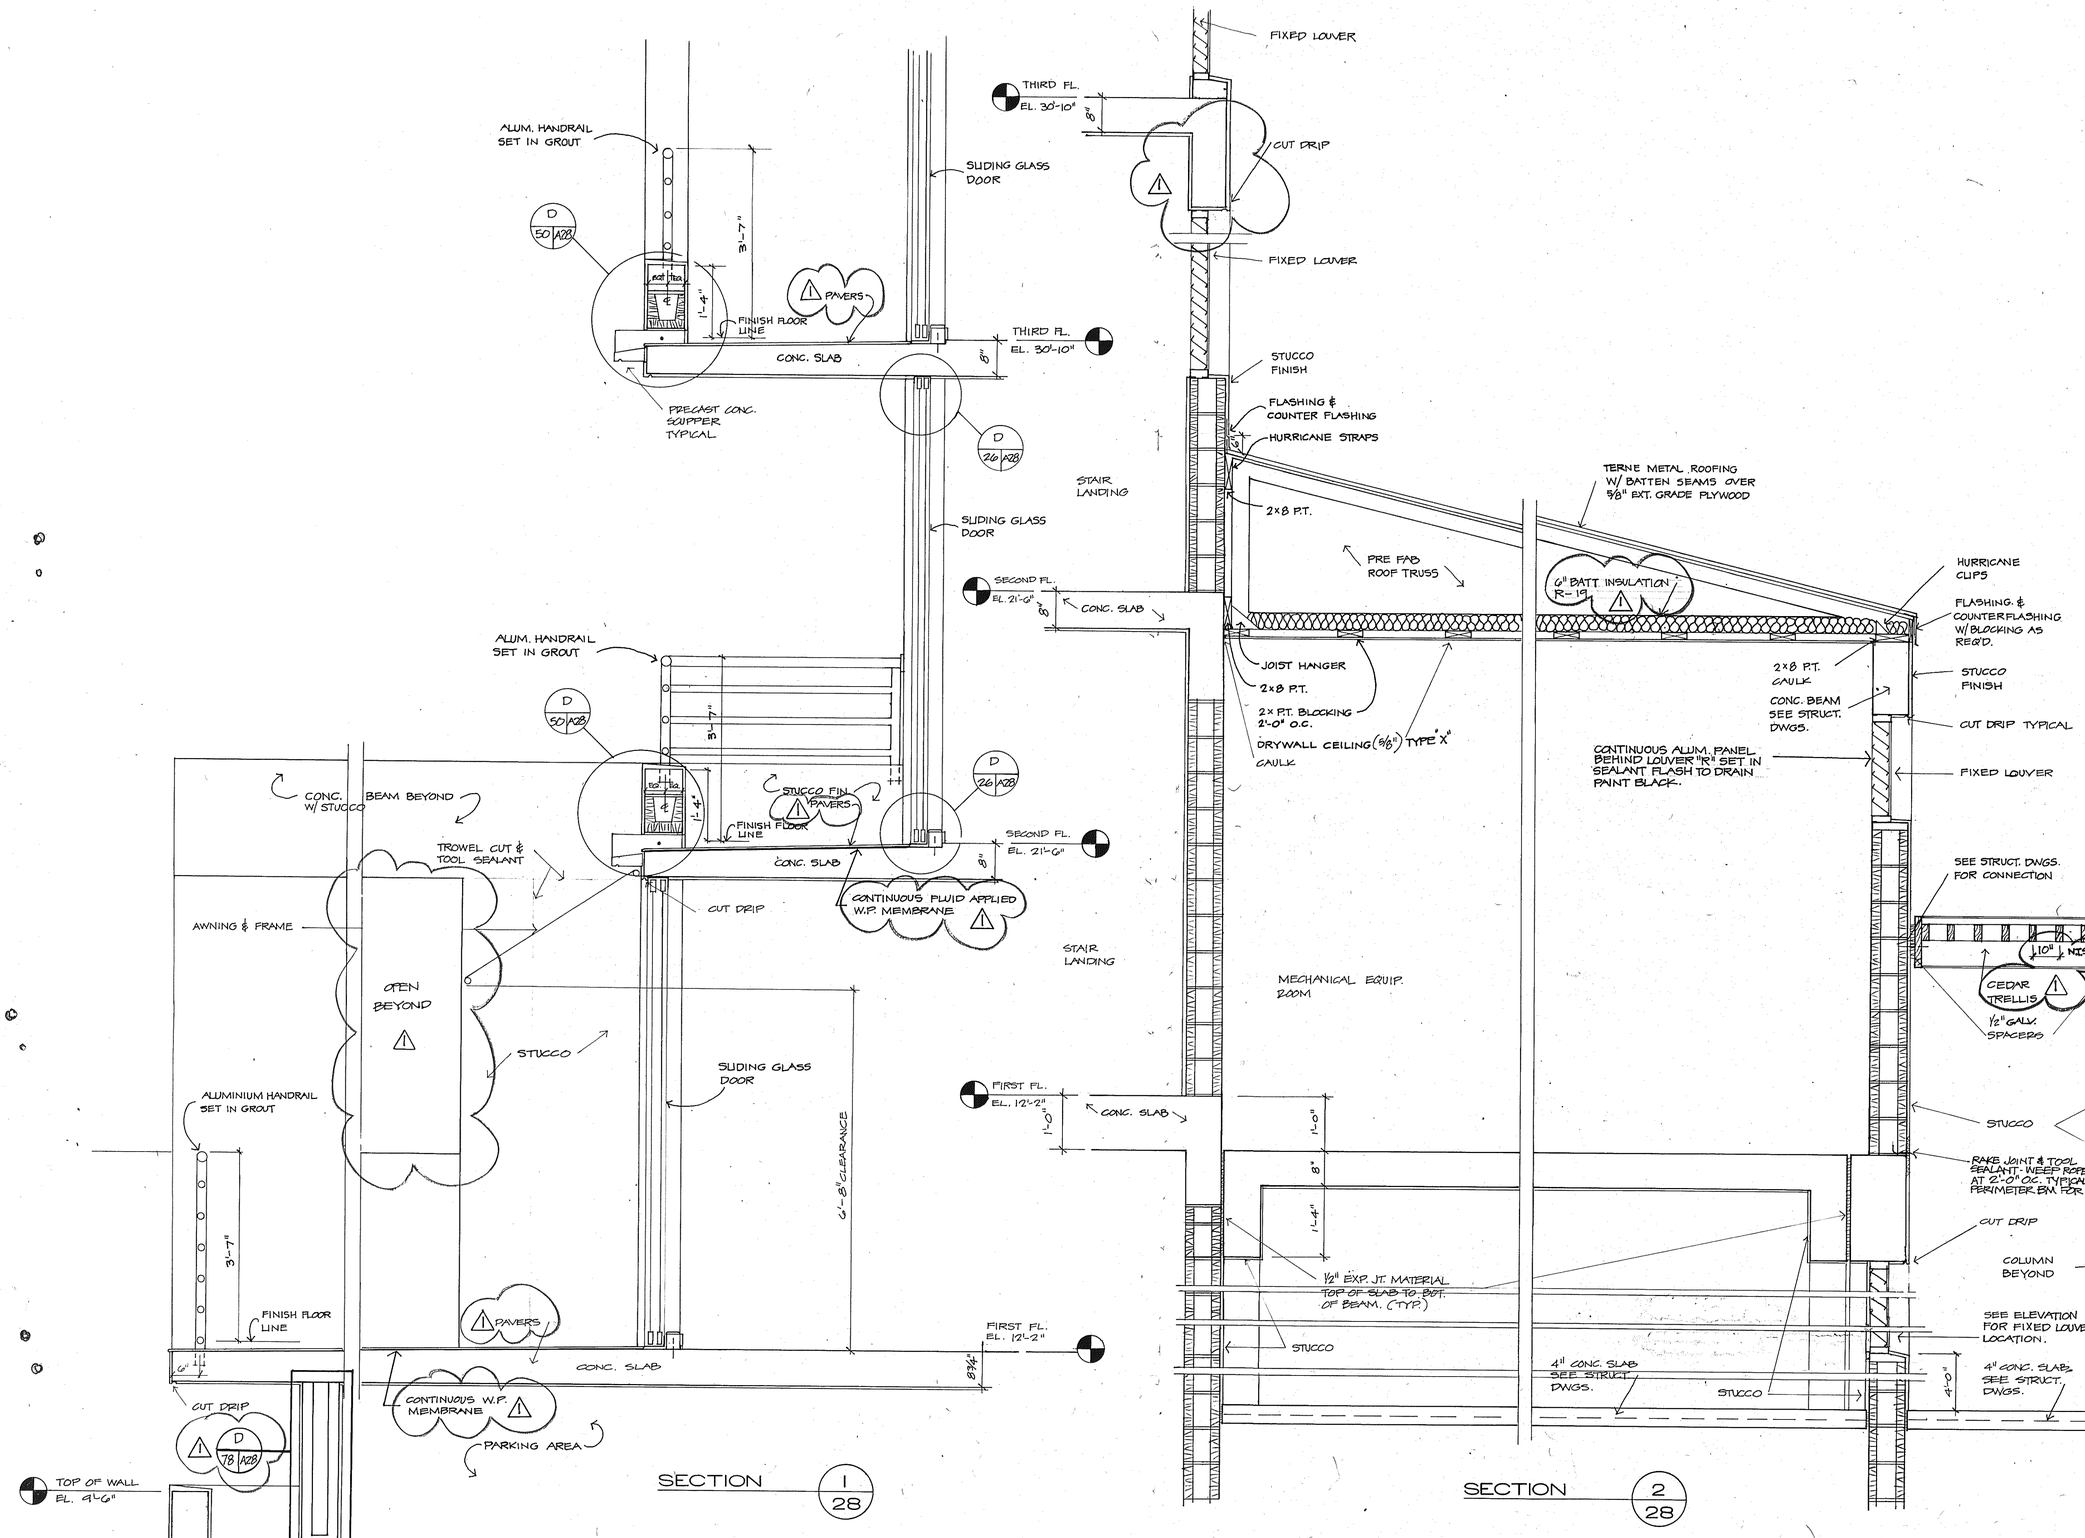

SUNSET BEACH OF LONGBOAT KEY

BLDG. 1 & BLDG. 2 REV. BUILDING SECTION

3/4" = 1'-0"

ARVIDA CORPORATION · EDWARD J SEIBERT, AIA ARCHITECT & PLANNER, PA · THE SVA GROUP
BRABHAM KUHNS DEBAY CONSULTING ENGINEERS · OLSEN WHITE & ASSOCIATES STRUCTURAL ENGINEERS · BENNETT & BISHOP INC CONSULTING ENGINEERS & SURVEYORS

ISSUED 10 DEC. 82

REVISED
1 4-1-83

SHEET A-28