
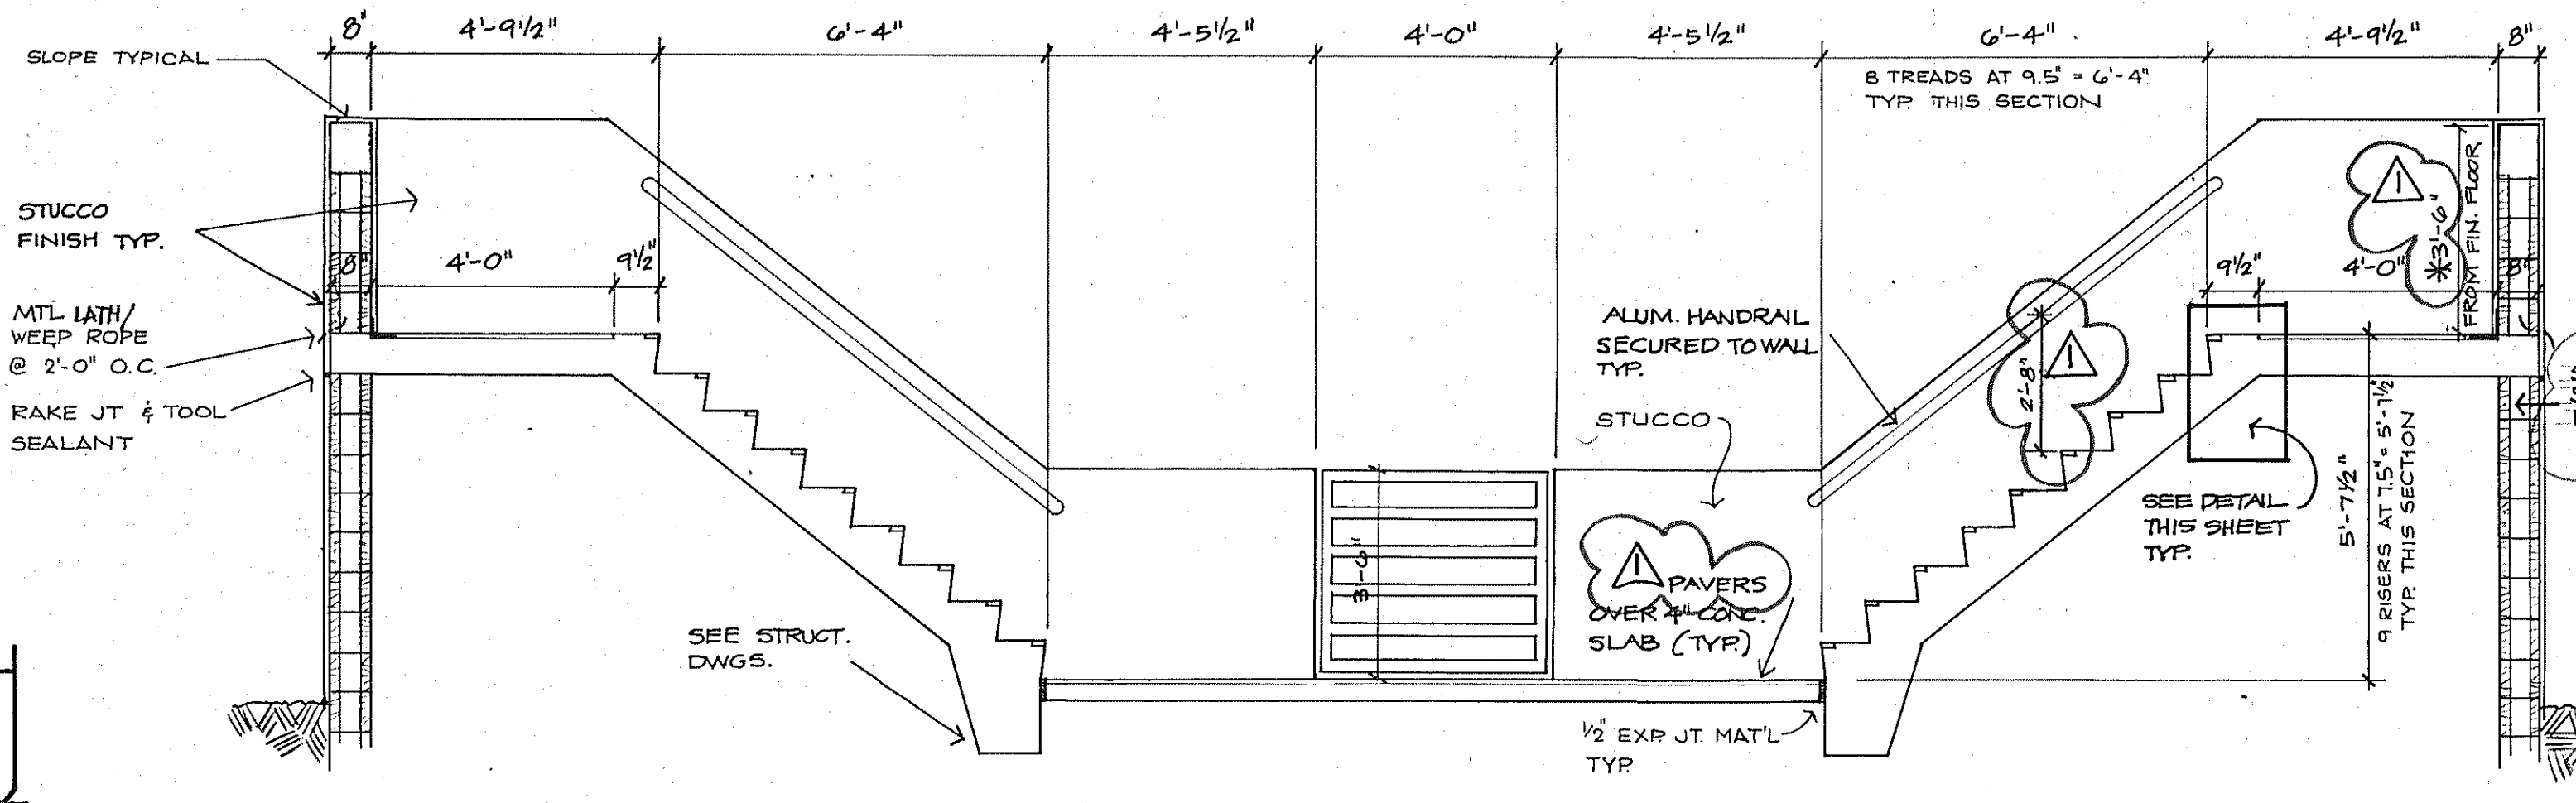



SECTION 1 (29) BUILDING 3
3/8"=1'-0"

* MEASURED FROM INTERIOR FINISH FLOOR LINE, TYP. ALL LANDINGS


NOTES
ALUMINUM RAIL GATES: PIVOT HINGES AND LATCH HARDWARE TO BE PROVIDED BY ALUM. RAIL FABRICATOR. SUBMIT SAMPLES TO ARCHITECT FOR APPROVAL PRIOR TO FABRICATION.

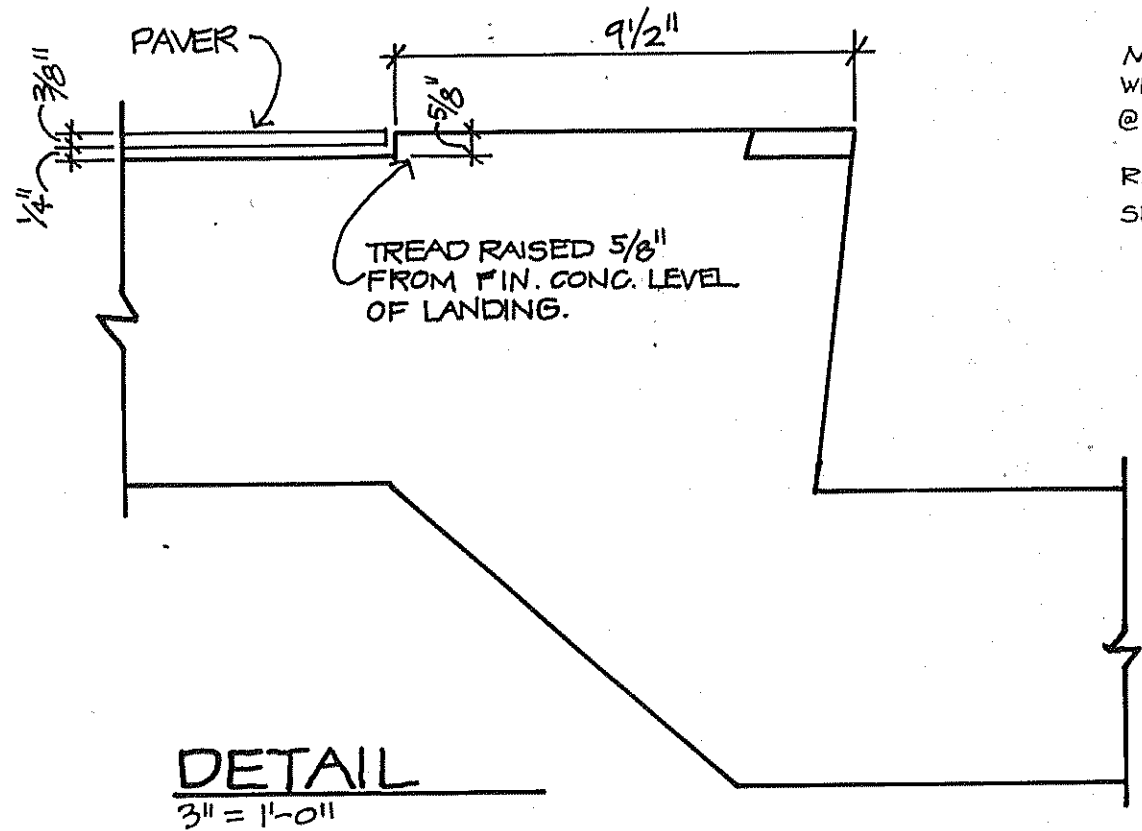

SECTION 3 (29) BUILDING 2
3/8"=1'-0"

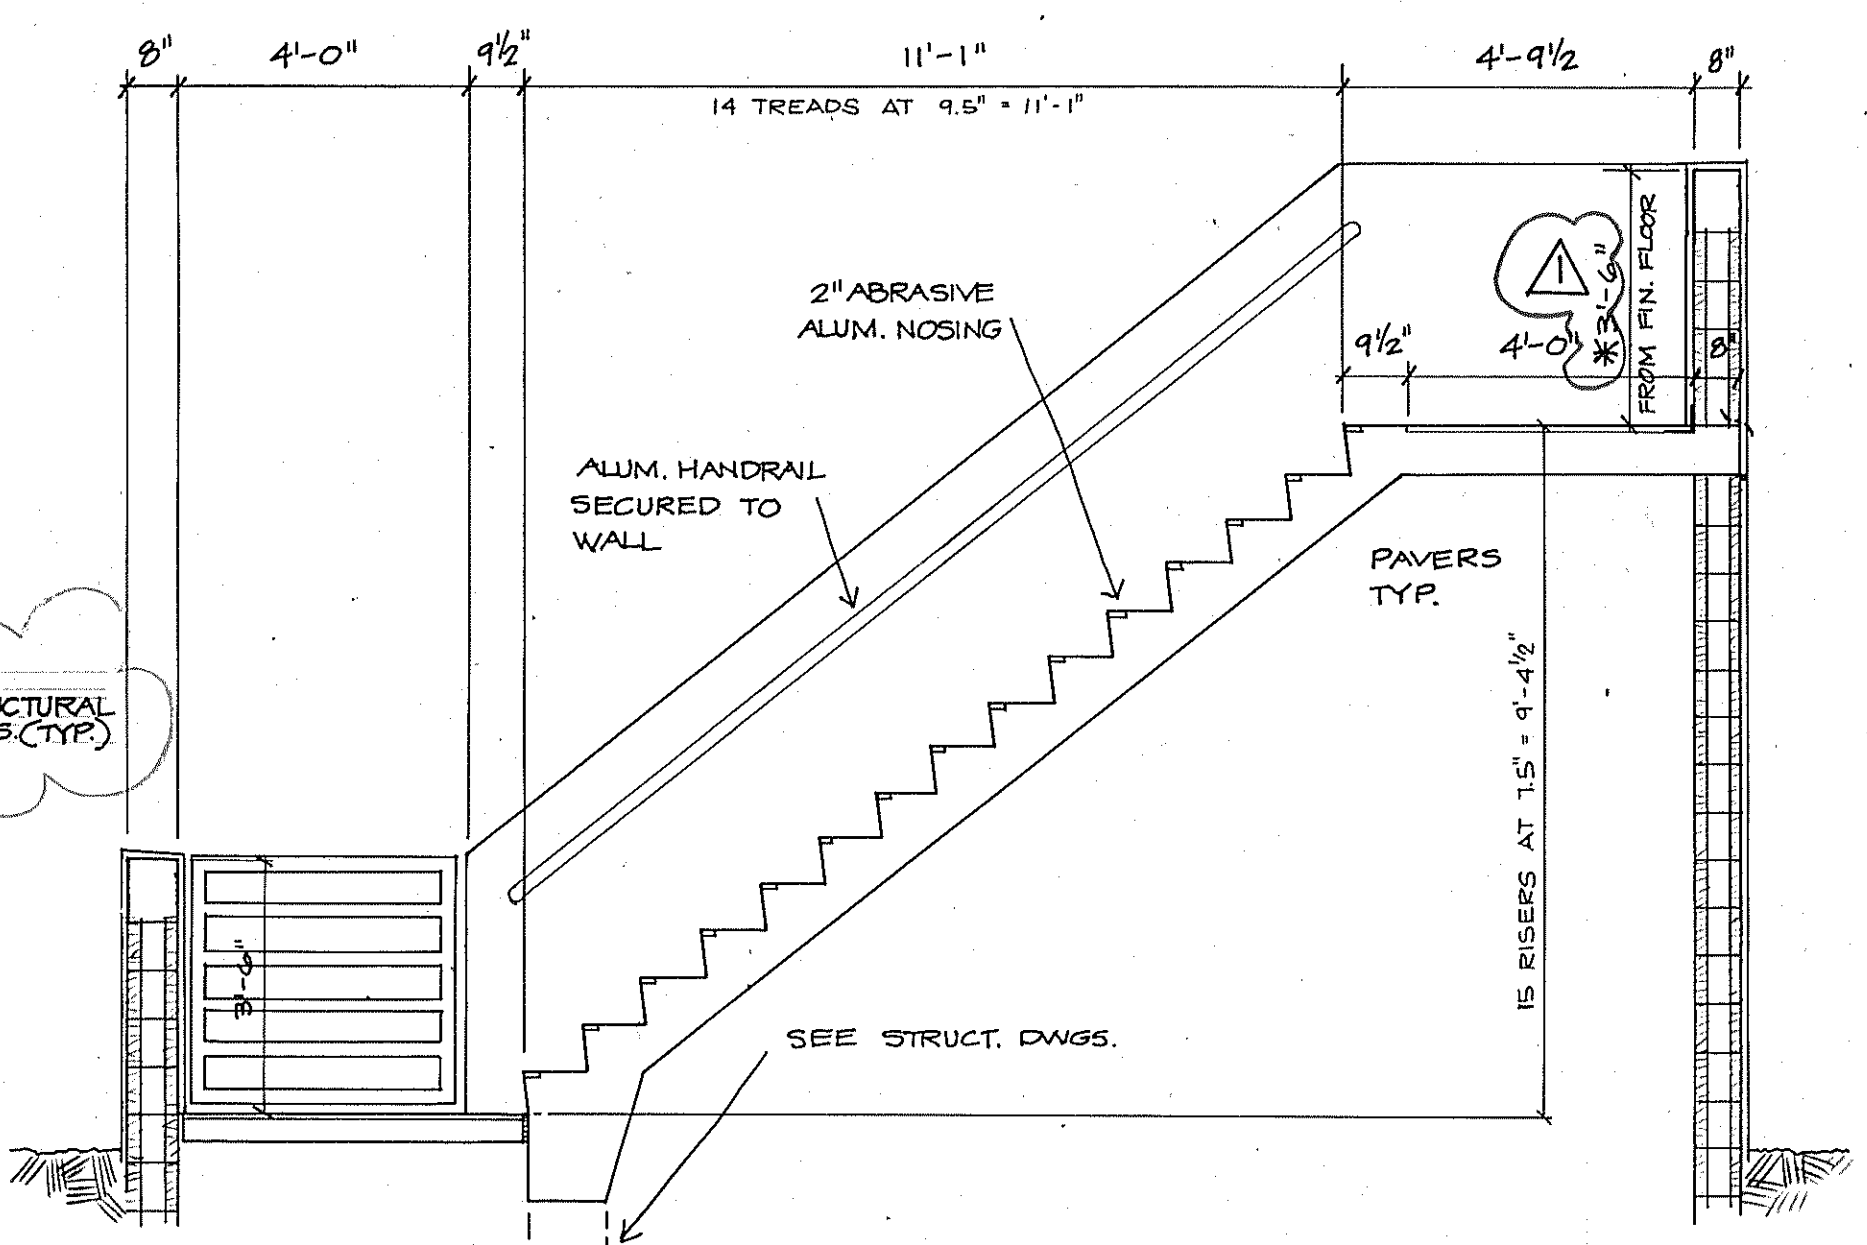


SECTION 4 (29) BUILDING 3
3/8"=1'-0"

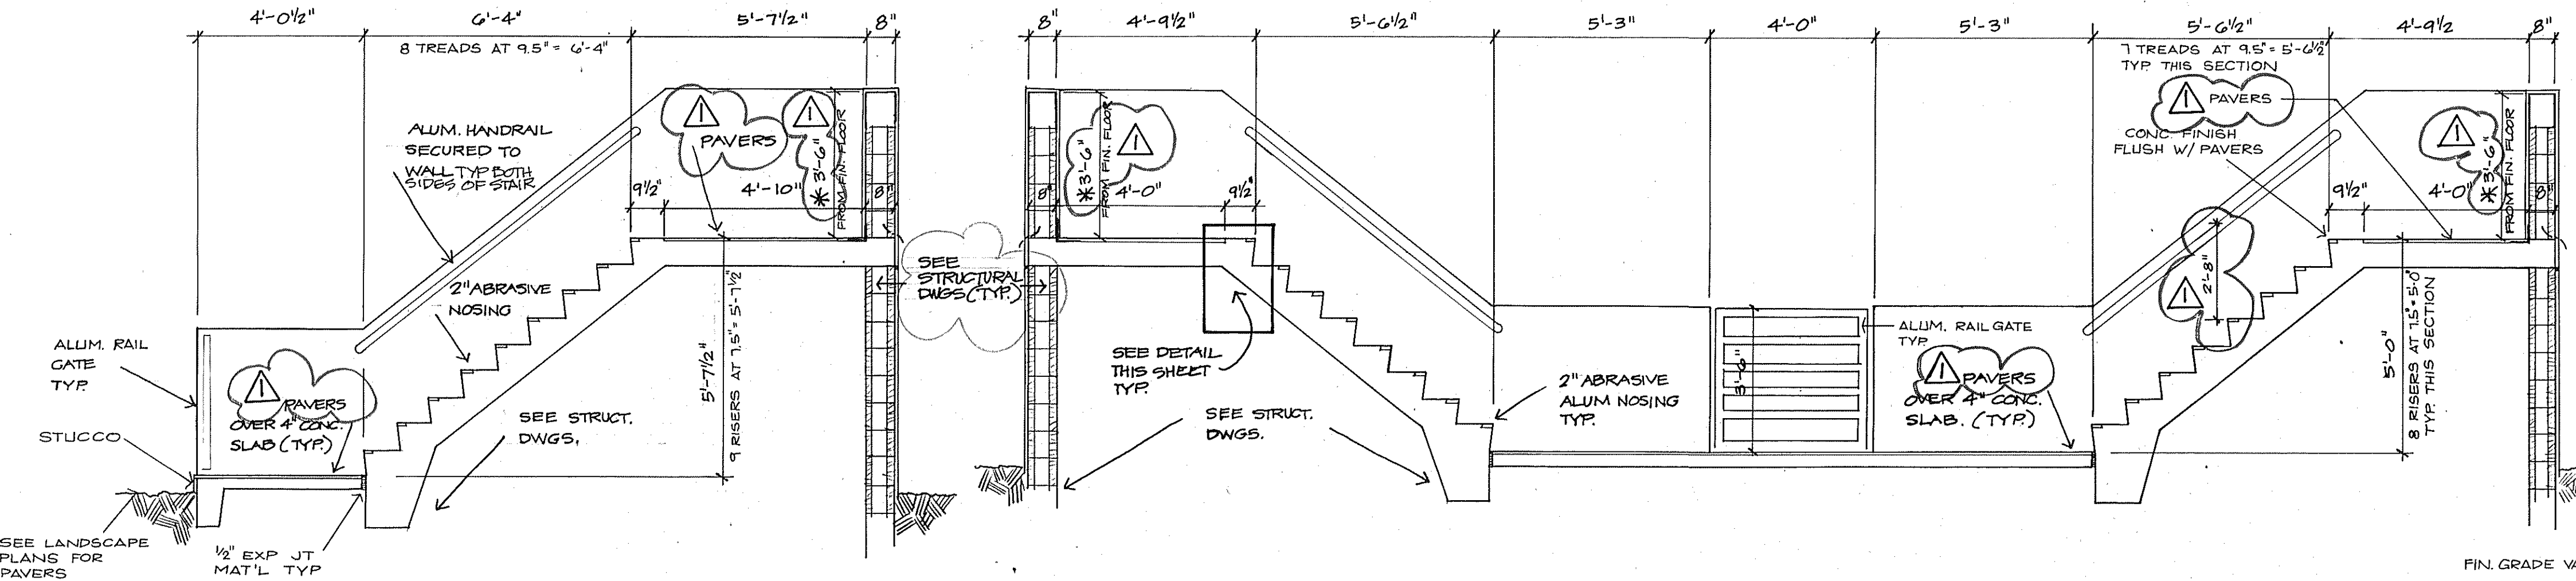

SECTION 5 (29) BUILDING 2
3/8"=1'-0"

SECTION 6 (29) BUILDING 1
3/8"=1'-0"

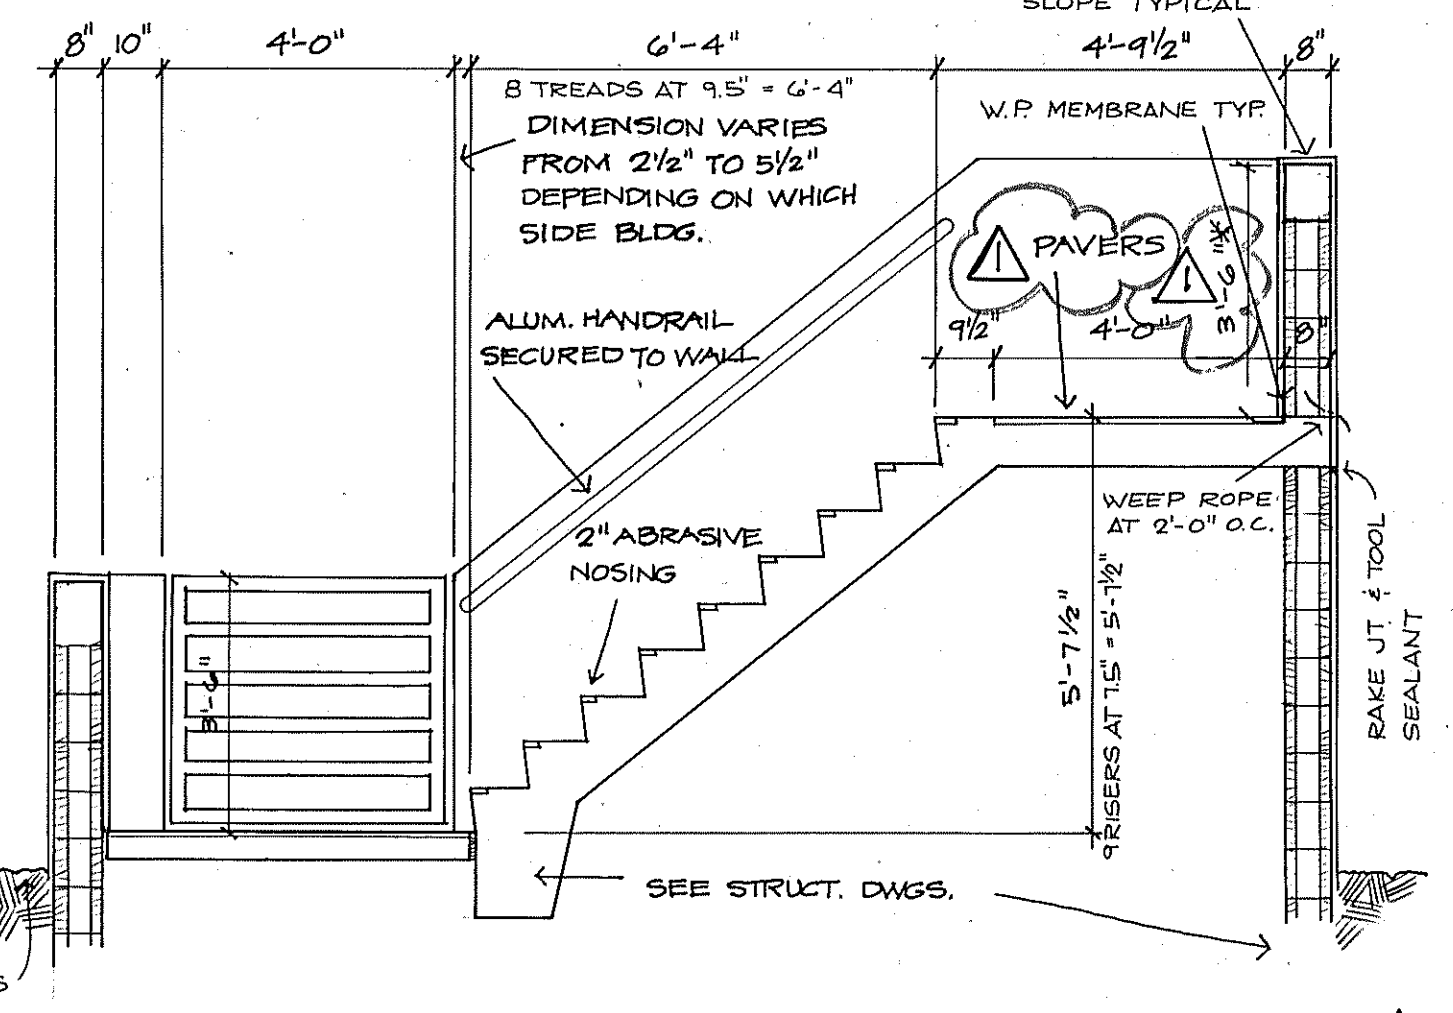

SECTION 7 (29) BUILDINGS 1&2
3/8"=1'-0"