



NOTES:
 1. MEDICINE CABINETS TO BE BUILT IN W/ MIRROR FACE
 2. ALLOW FOR MARBLE SIL. BETWEEN CERAMIC TILE & CARPET

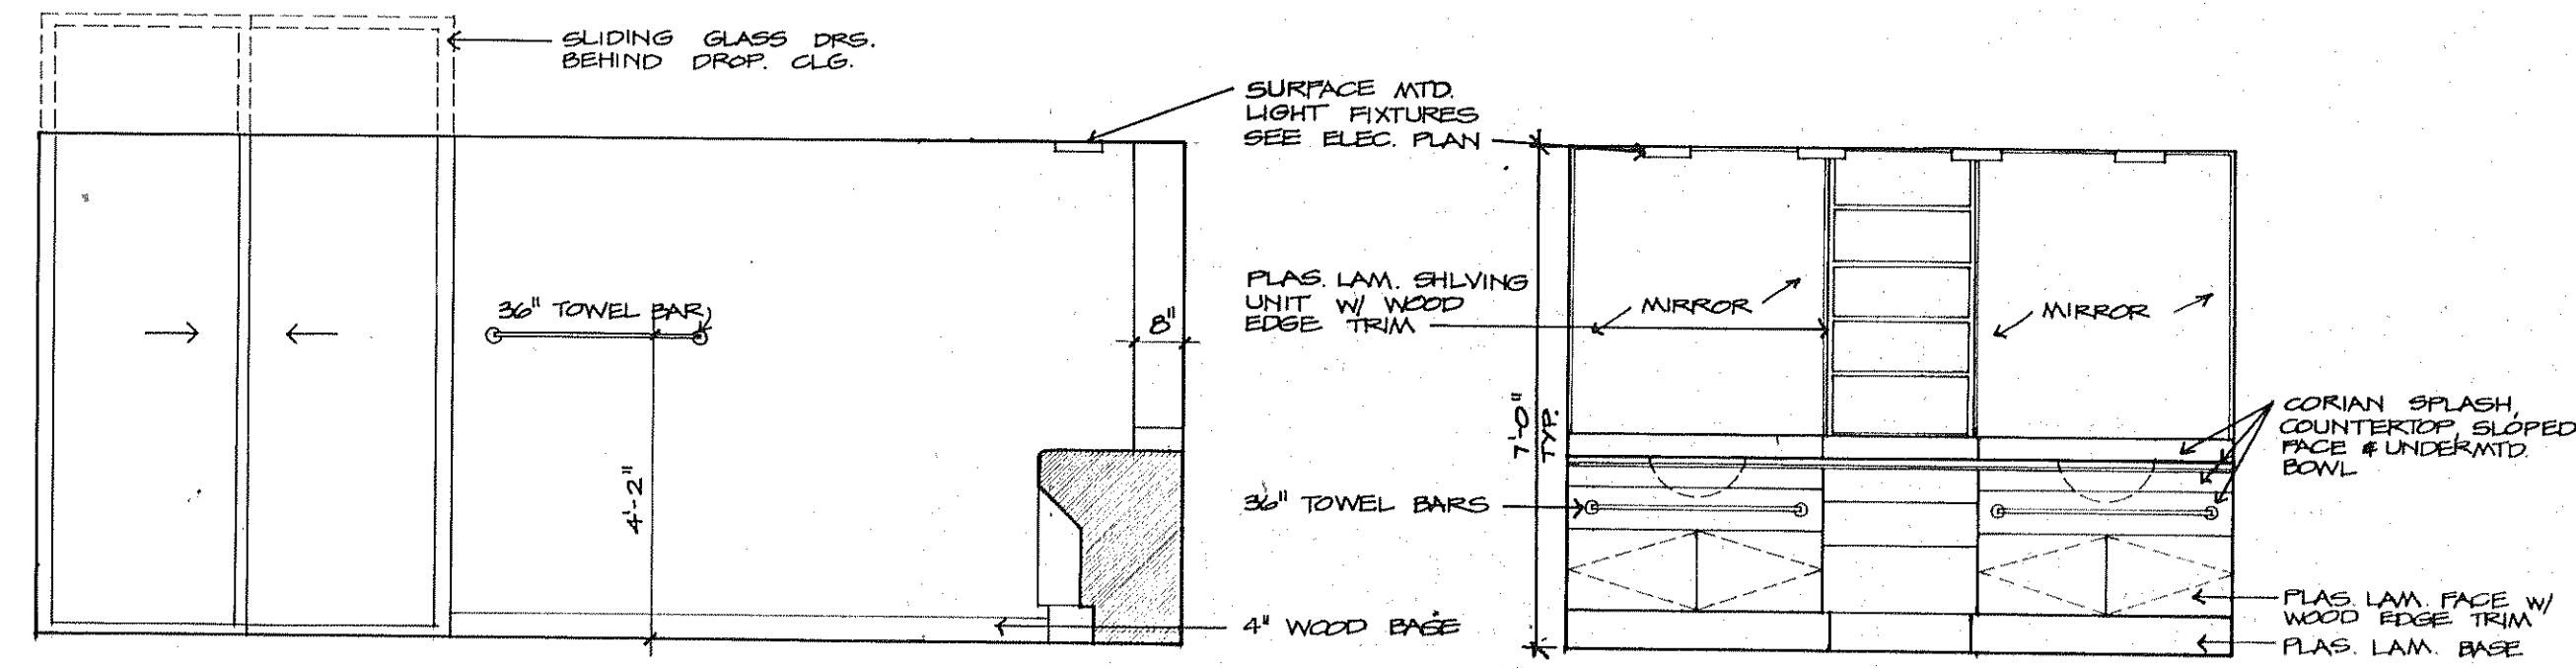


ELEV. 52
 UNIT D+R
 REVERSE D+L
BATH 1

ELEV. 53

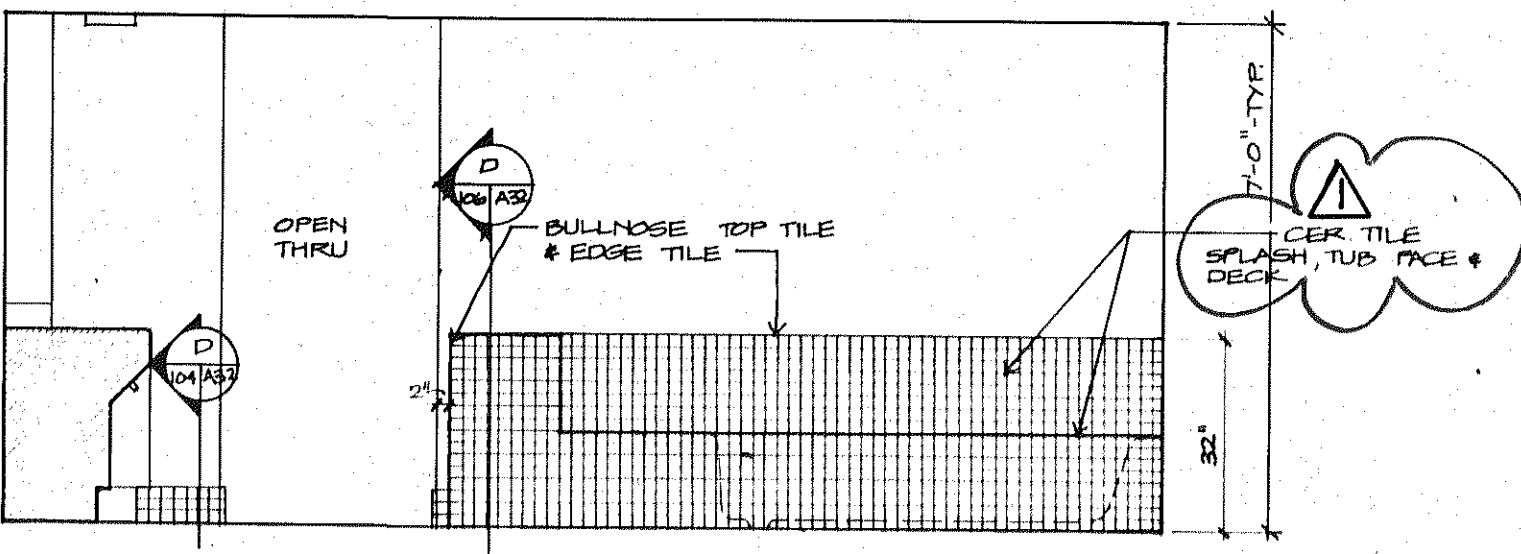


ELEV. 54

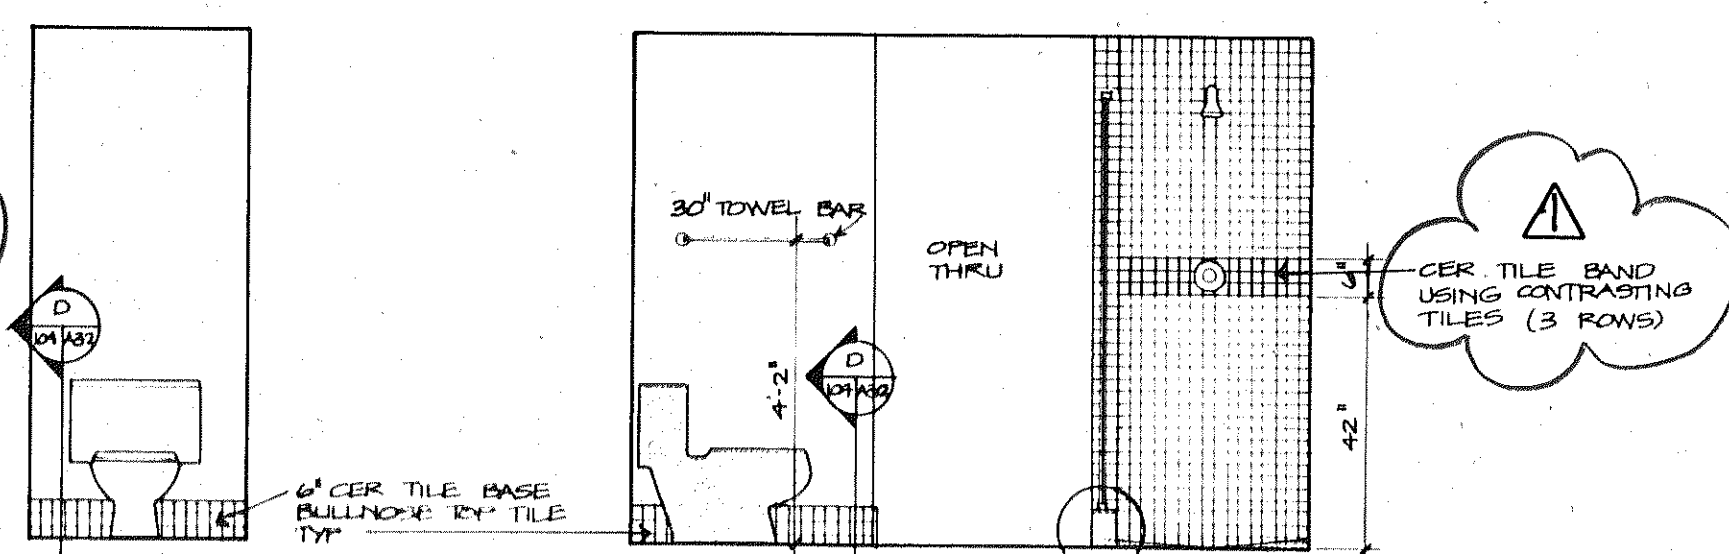


ELEV. 55
 UNIT D+R
 REVERSE D+L
TOILET ROOM

ELEV. 56

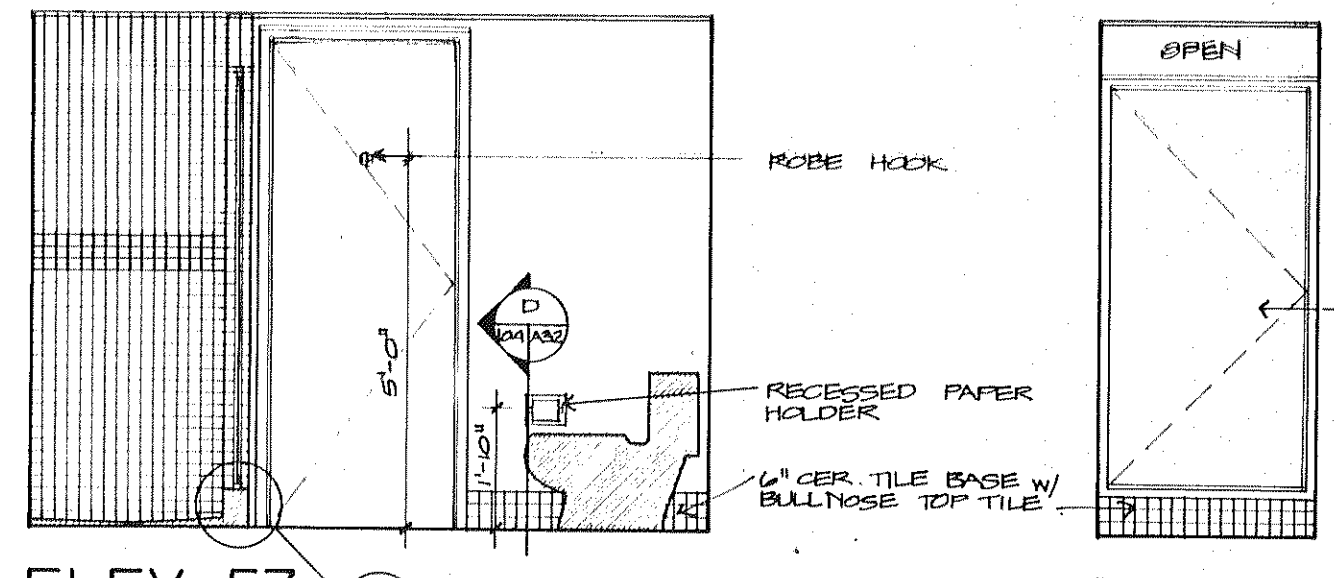


ELEV. 57

ELEV. 58

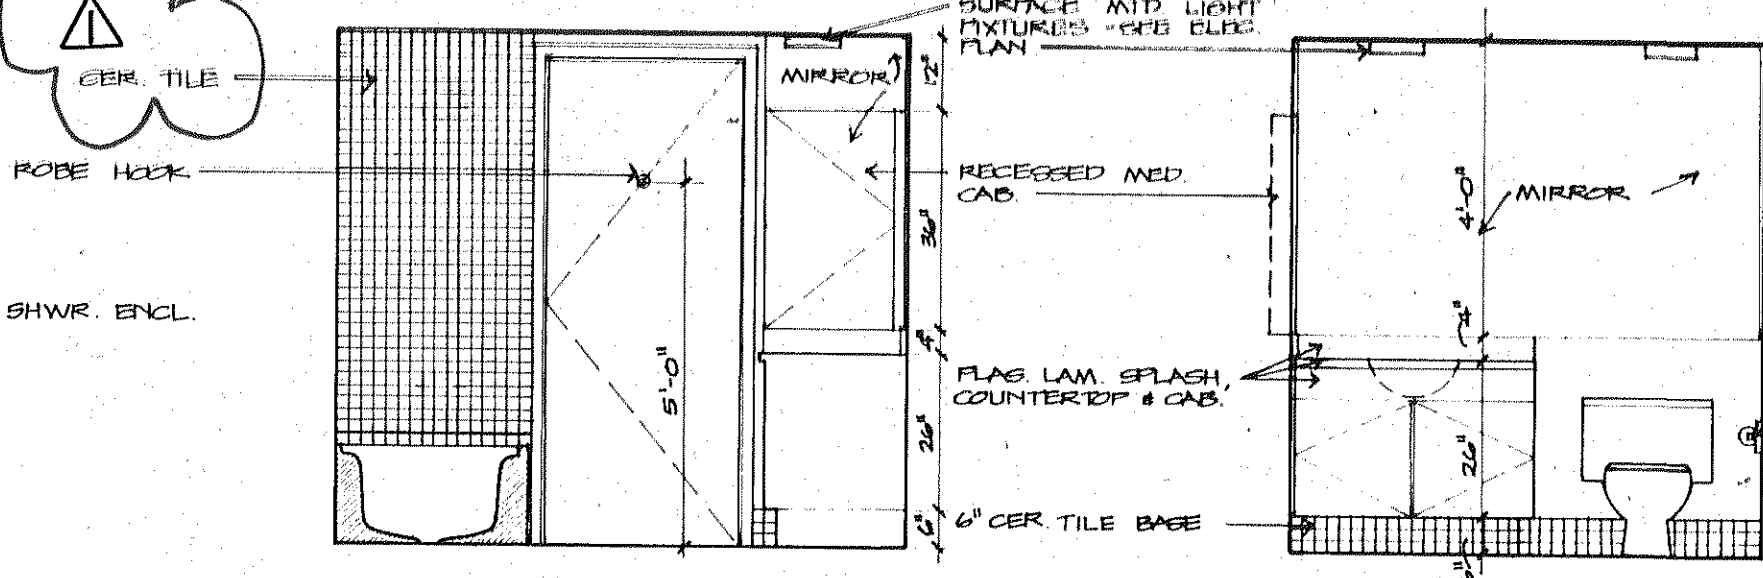


ELEV. 59
 UNIT D+R
 REVERSE D+L
BATH 2

ELEV. 60

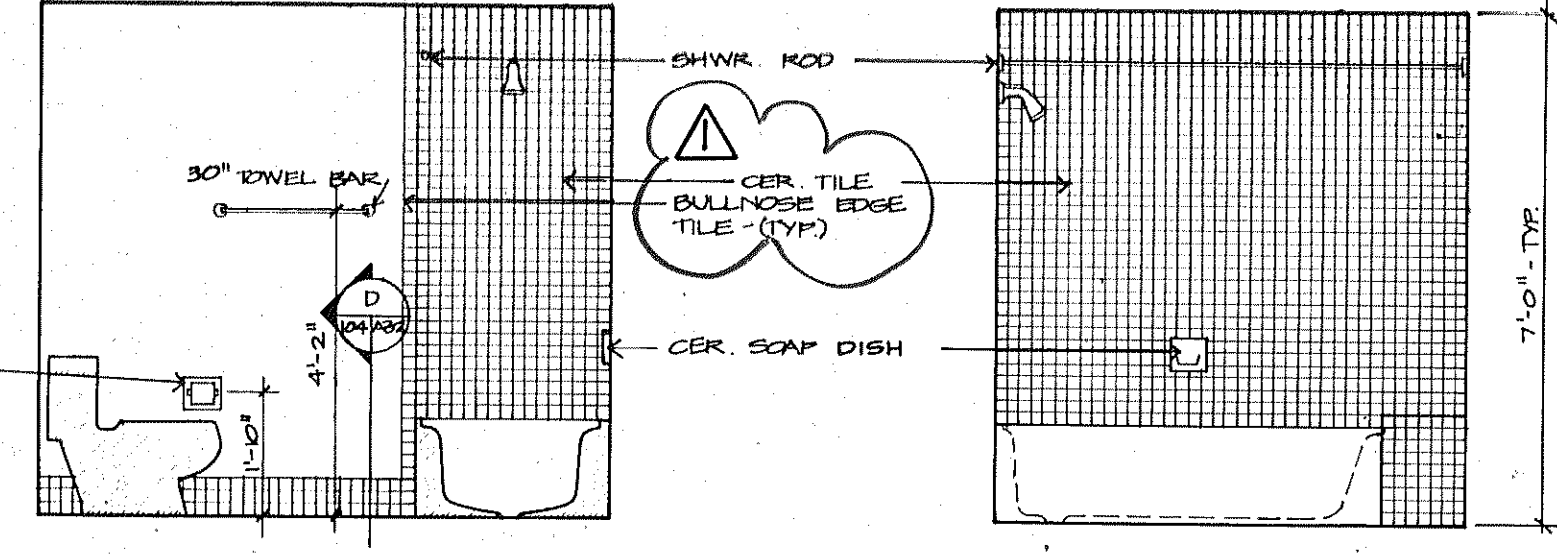


ELEV. 61

ELEV. 62

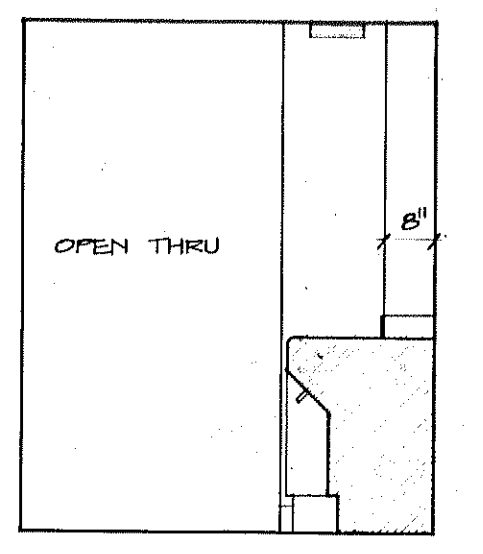


ELEV. 63
 UNITS D-R, D-MOD-R
 REVERSE D-L, D-MOD-L
DRESSING

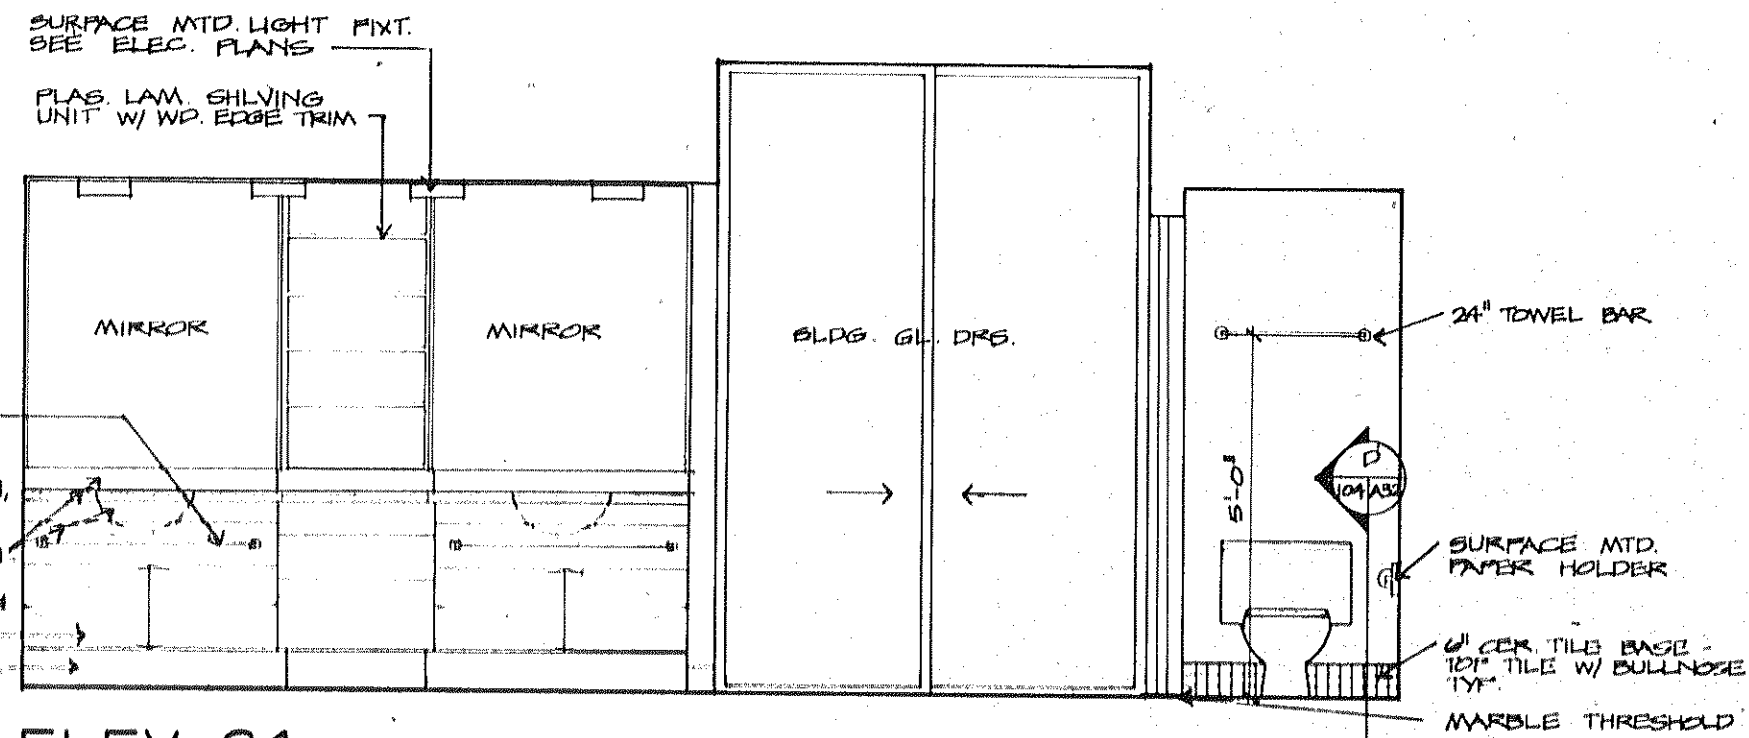

ELEV. 64
 UNITS D-R, D-MOD-R
 REVERSE D-L, D-MOD-L
DRESSING / BATH 1 / TLT. RM.


ELEV. 65

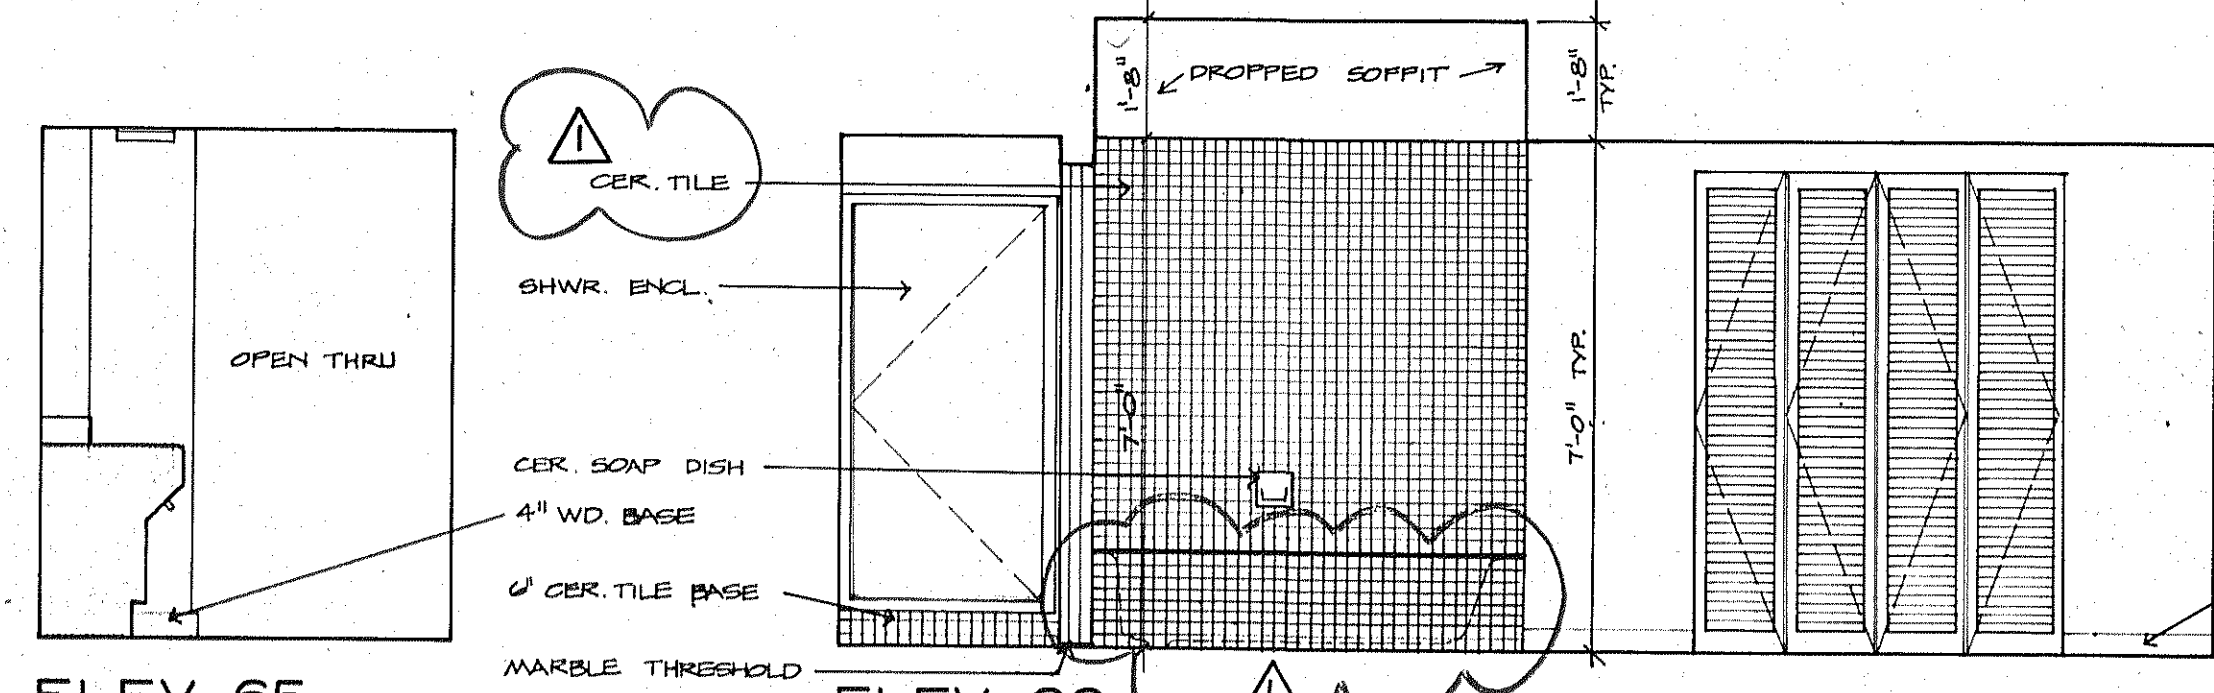

ELEV. 66


ELEV. 67
 UNITS D-R, D-MOD-R
 REVERSE D-L, D-MOD-L
BATH 1

ELEV. 67

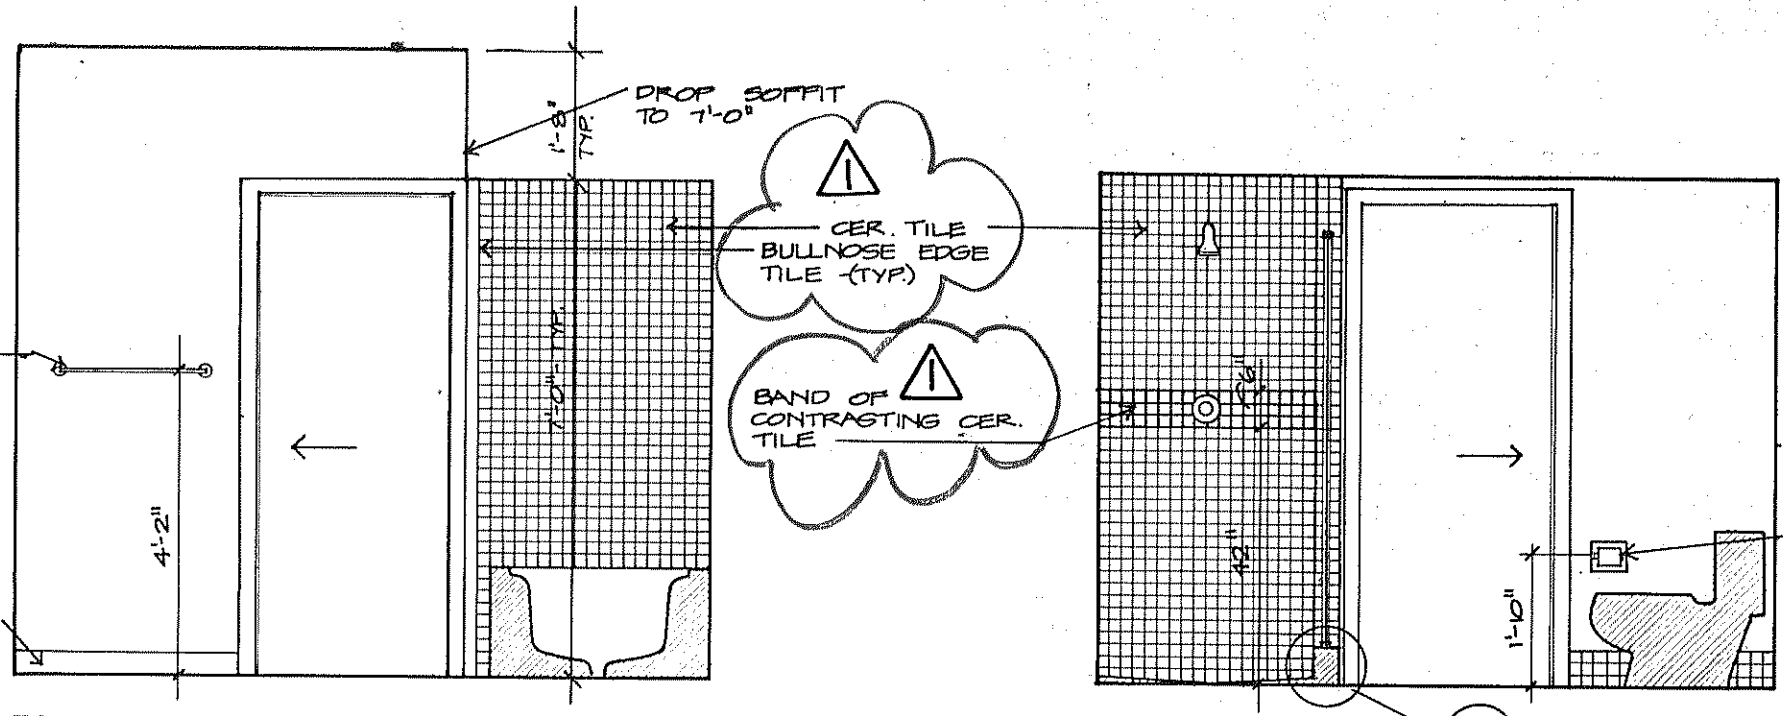


ELEV. 68


ELEV. 69
 UNIT D-R, D-MOD-R
 REVERSE D-L, D-MOD-L
TOILET RM.

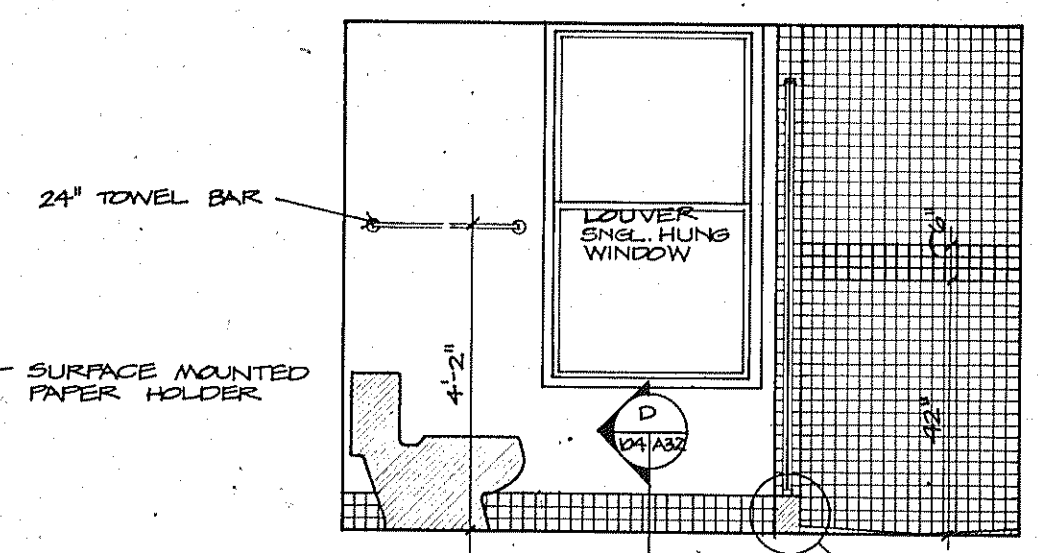

ELEV. 70

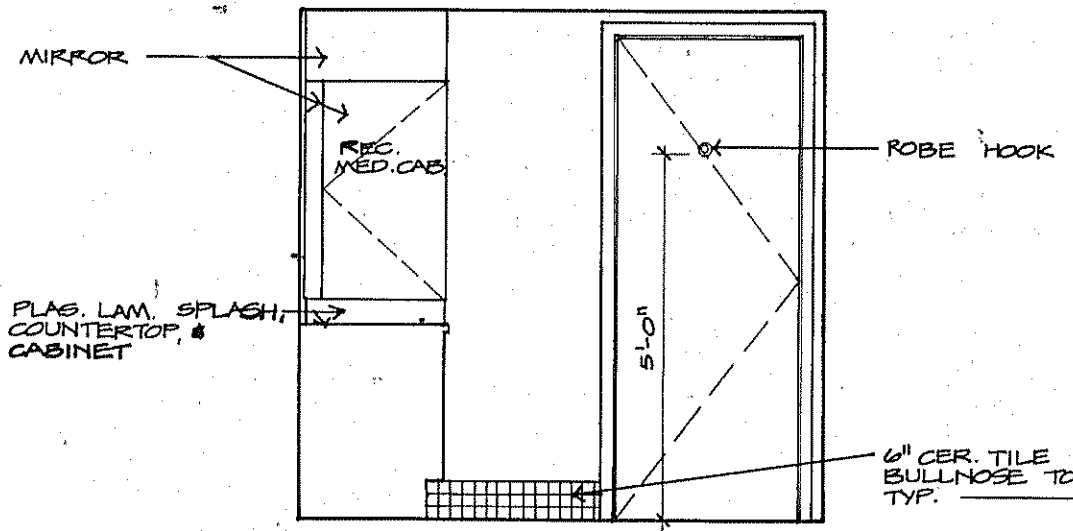

ELEV. 71
 UNIT D-MOD-R
 REVERSE D-MOD-L
BATH 2

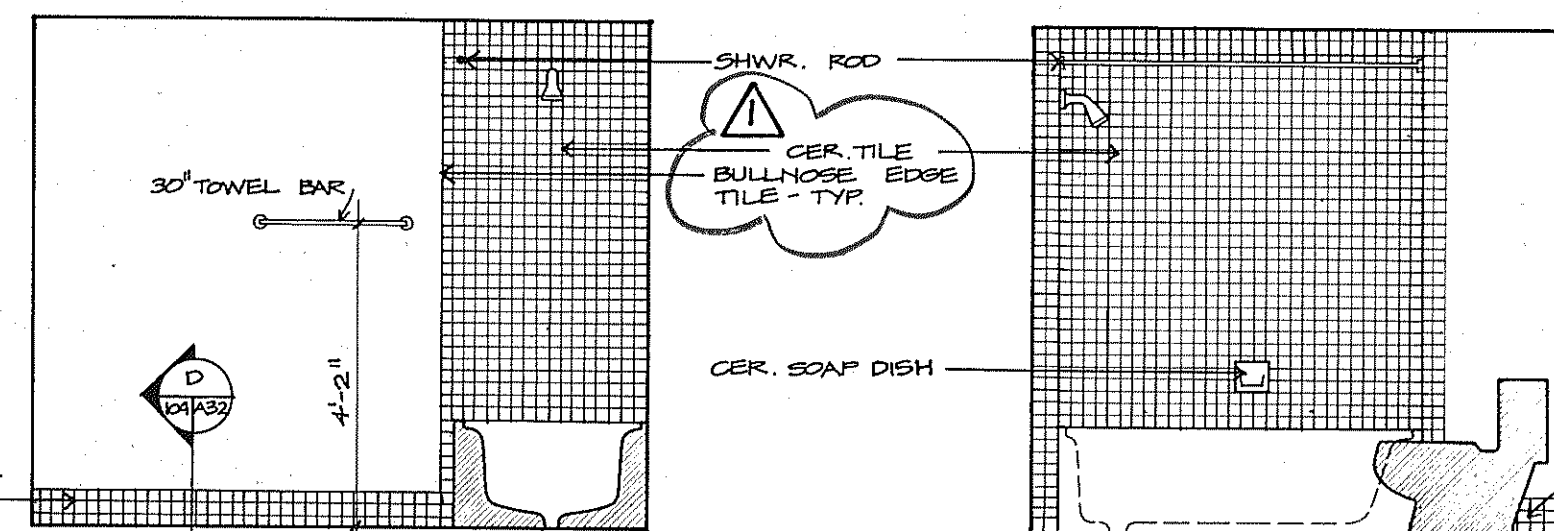

ELEV. 72

ELEV. 73

SUNSET BEACH
 OF LONG BEACH
 BENNETT & BISHOP, INC. CONSULTING ENGINEERS & SURVEYORS

INTERIOR ELEVATIONS 3/8" = 1'-0"
 ARVIDA CORPORATION · EDWARD J. SEBERT, AIA ARCHITECT & PLANNER, PA · THE SWA GROUP
 BRABHAM, KUHNS, DEBAY · CONSULTING ENGINEERS · OLSEN, WHITE & ASSOCIATES · STRUCTURAL ENGINEERS

ISSUED	10 DEC '82
REVISED	4-1-83
SHEET	A-32
	OF 37