
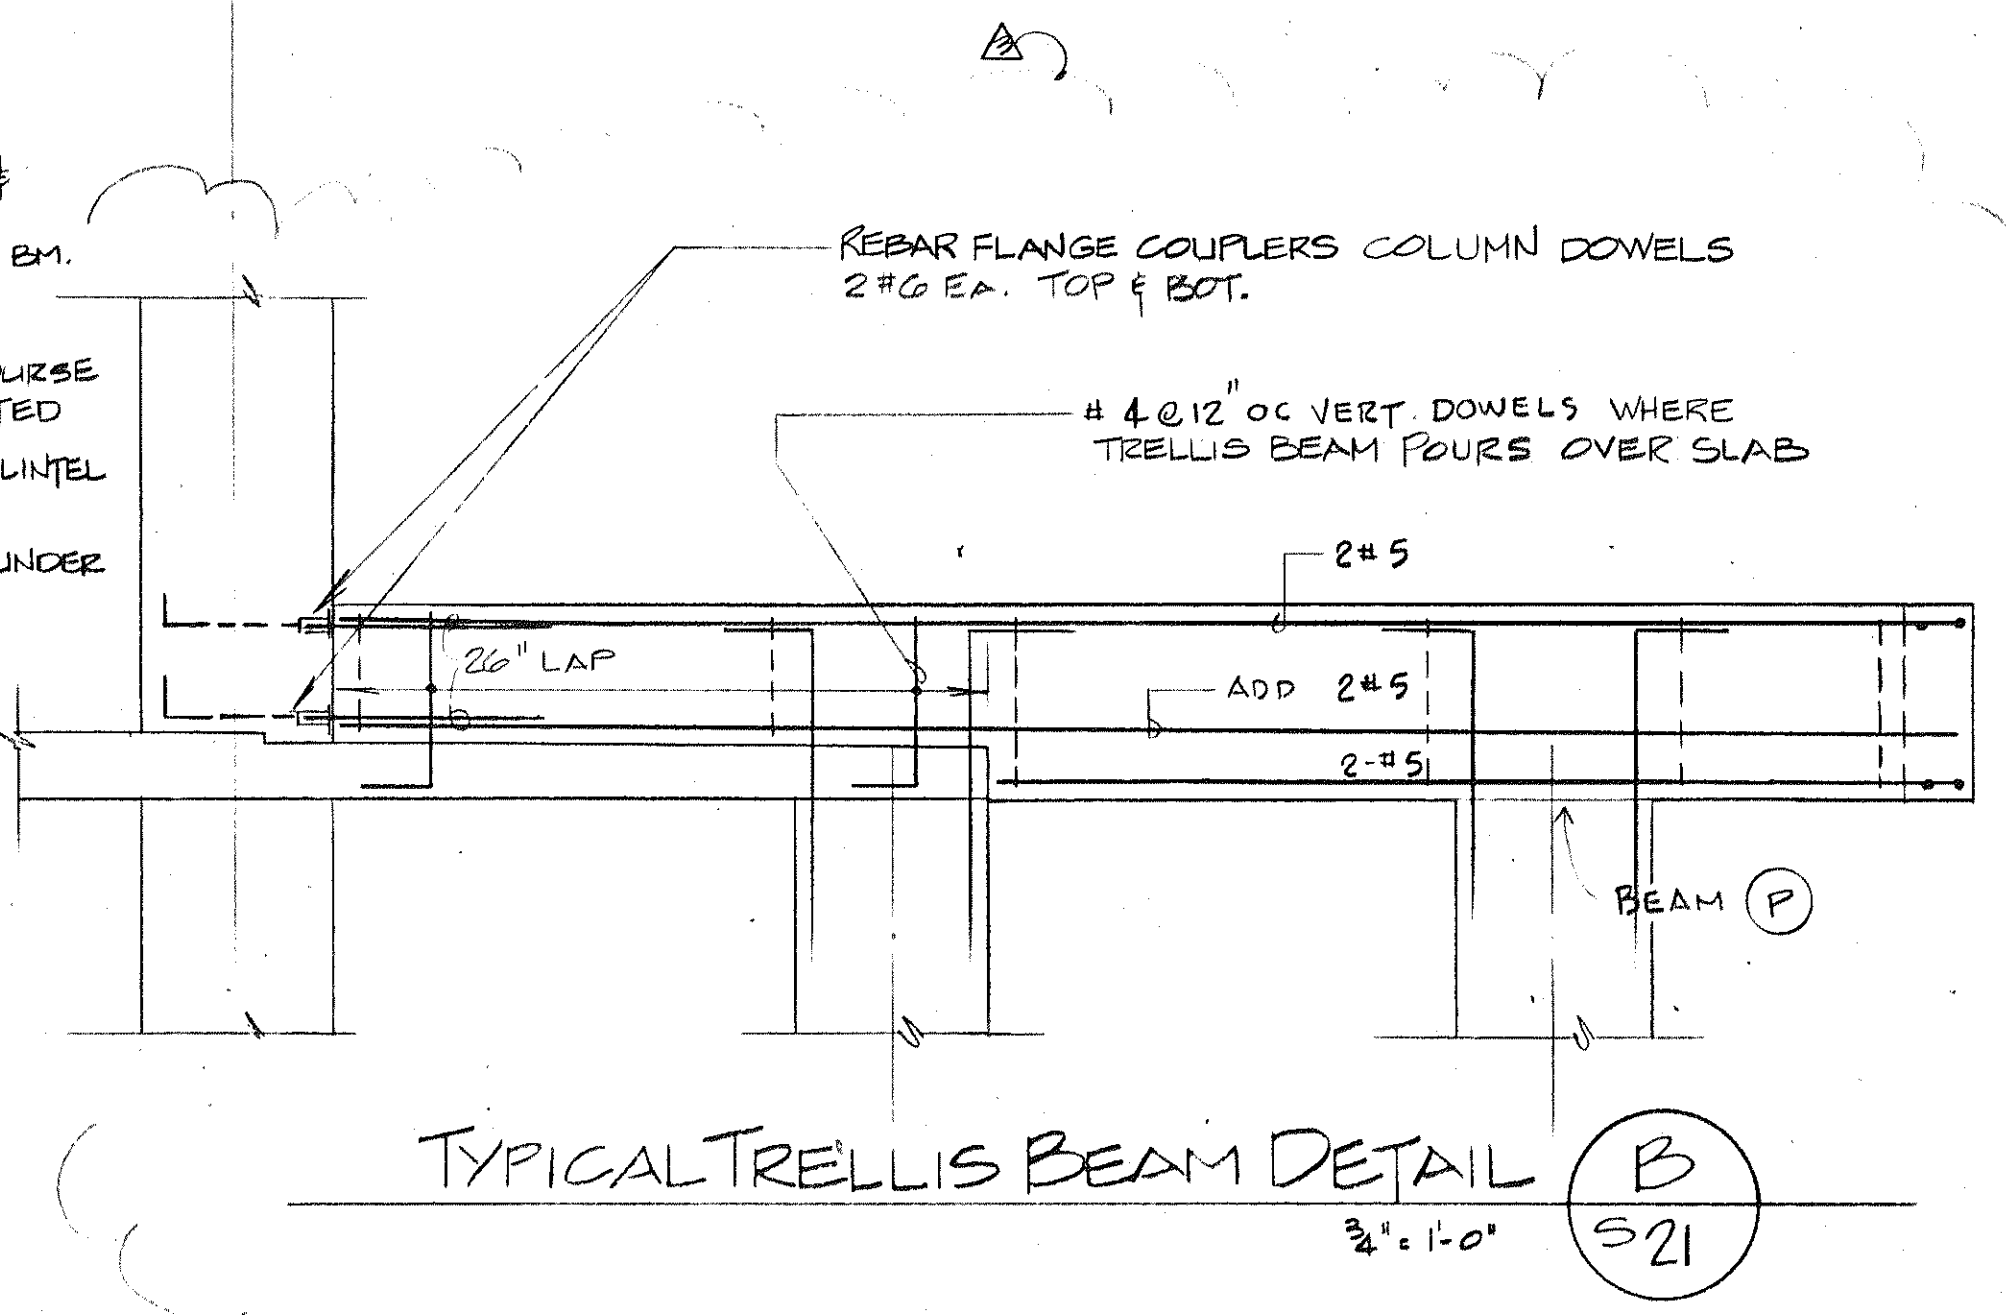


- LEGEND**
- ① 3/4" DAP OUT (STEP) TO OCCUR BEHIND WALLS & DOOR MULLIONS
  - ② SLOPE SLAB DOWN TO EXTERIOR FACE OF BUILDING
  - ③ TRANSFER BEAM
  - ④ 8" CONG. SLABS
  - ⑤ 8 3/4" CONG. SLABS

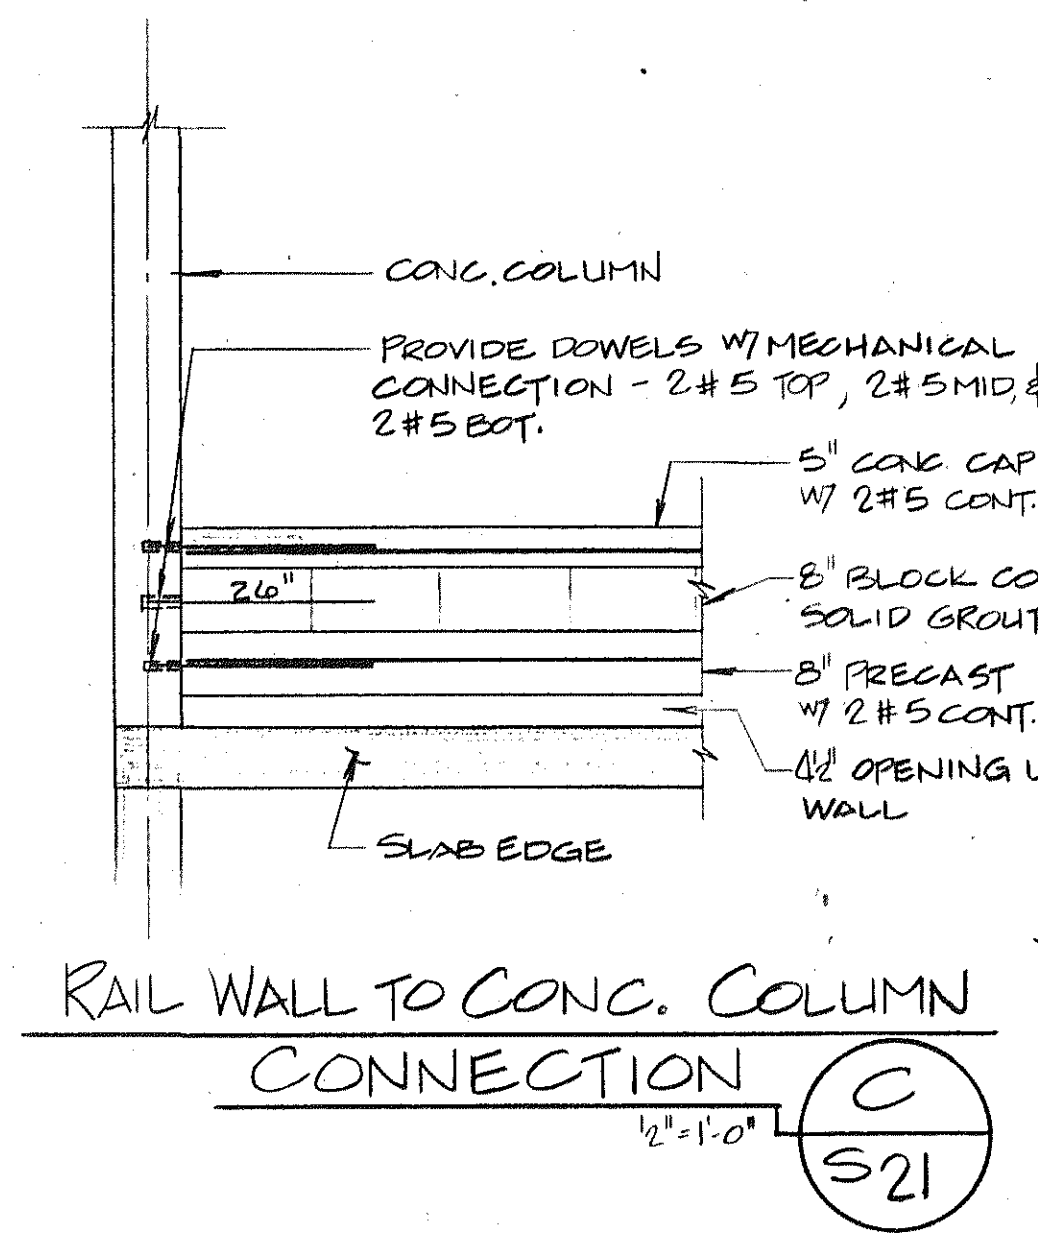

SECTION 1  
3/8" = 1'-0"  
S-21

SECTION 2  
3/8" = 1'-0"  
S-21

SECTION 3  
3/8" = 1'-0"  
S-21

SECTIONS & DETAILS

REVISIONS

NO.	DATE	DESCRIPTION
1	10-87	REVISED
2	1-4-88	REVISED
3	11-1-88	REVISED

SHEET  
OF 24