


SUNSET BEA
 SOLAR
 # 2 SECTION
 BLDG. # 2 SECTION

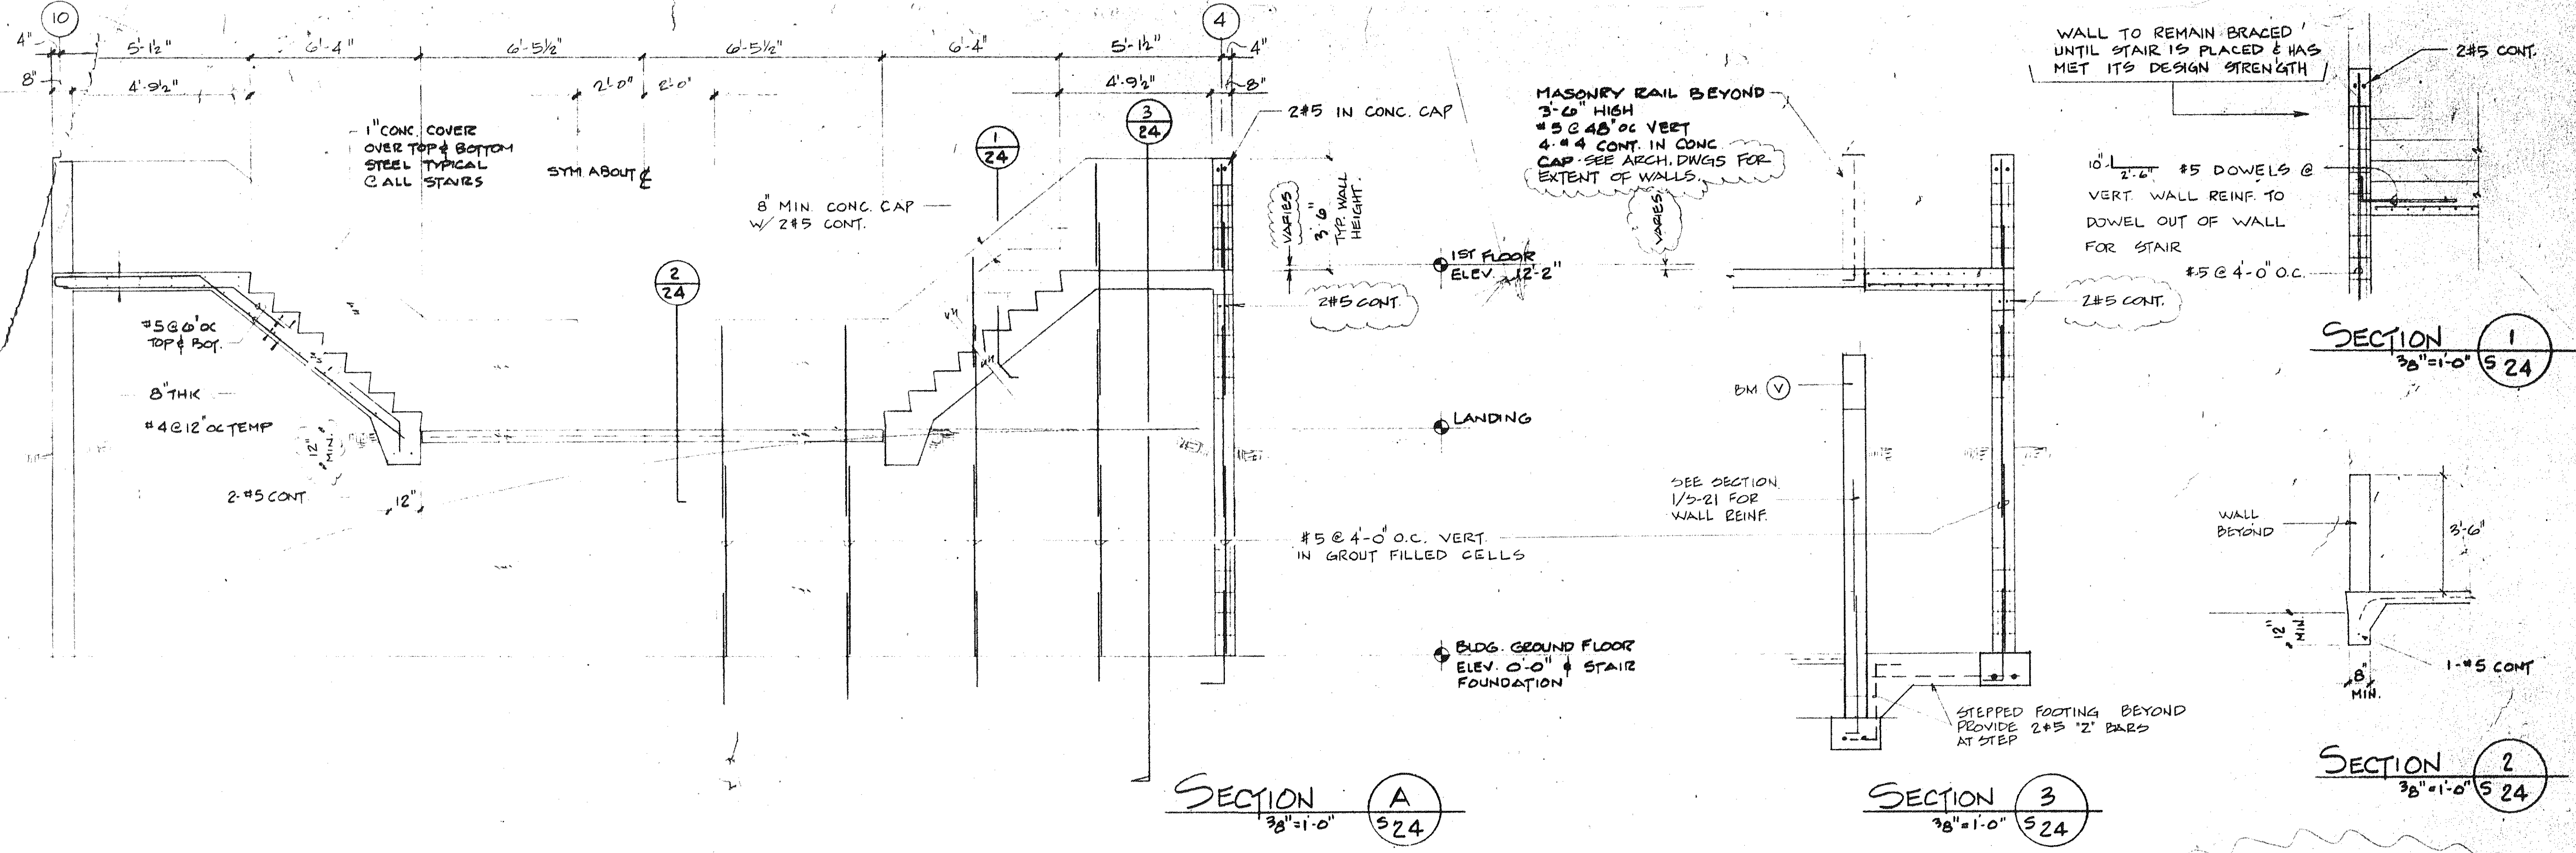

(NOTE: SEE FOUNDATION FOR FIG. SIZE)

NOTE:
 ALL WALLS TO BE BRACED UNTIL BEARING SLABS ARE IN PLACE & WALLS TO BE BACK-FILLED ON EACH SIDE SIMULTANEOUSLY.

