SLAB NOTES
SLAB THICKNESS = 8" (EXCEPT WHERE NOTED ON TOP STEEL SHT.)

CONCRETE STRENGTH = 4000 P.S.I.

REINFORCING STEEL
GRADE = A615-60
PLACEMENT NOTES & DETAILS = SHT. #S-14
(+) BARS ARE ADD BARS & ARE IN ADDITION TO GRID REINF. SHOWN ON PLAN

REFERENCE NOTES
COLUMN SCHEDULE = SHT. #S-15
SHEARWALL SCHEDULE = SHT. #S-16
BEAM SCHEDULE = SHT. #S-17
NON-LOAD BEARING WALL REINF. NOTES = SHT #S-14

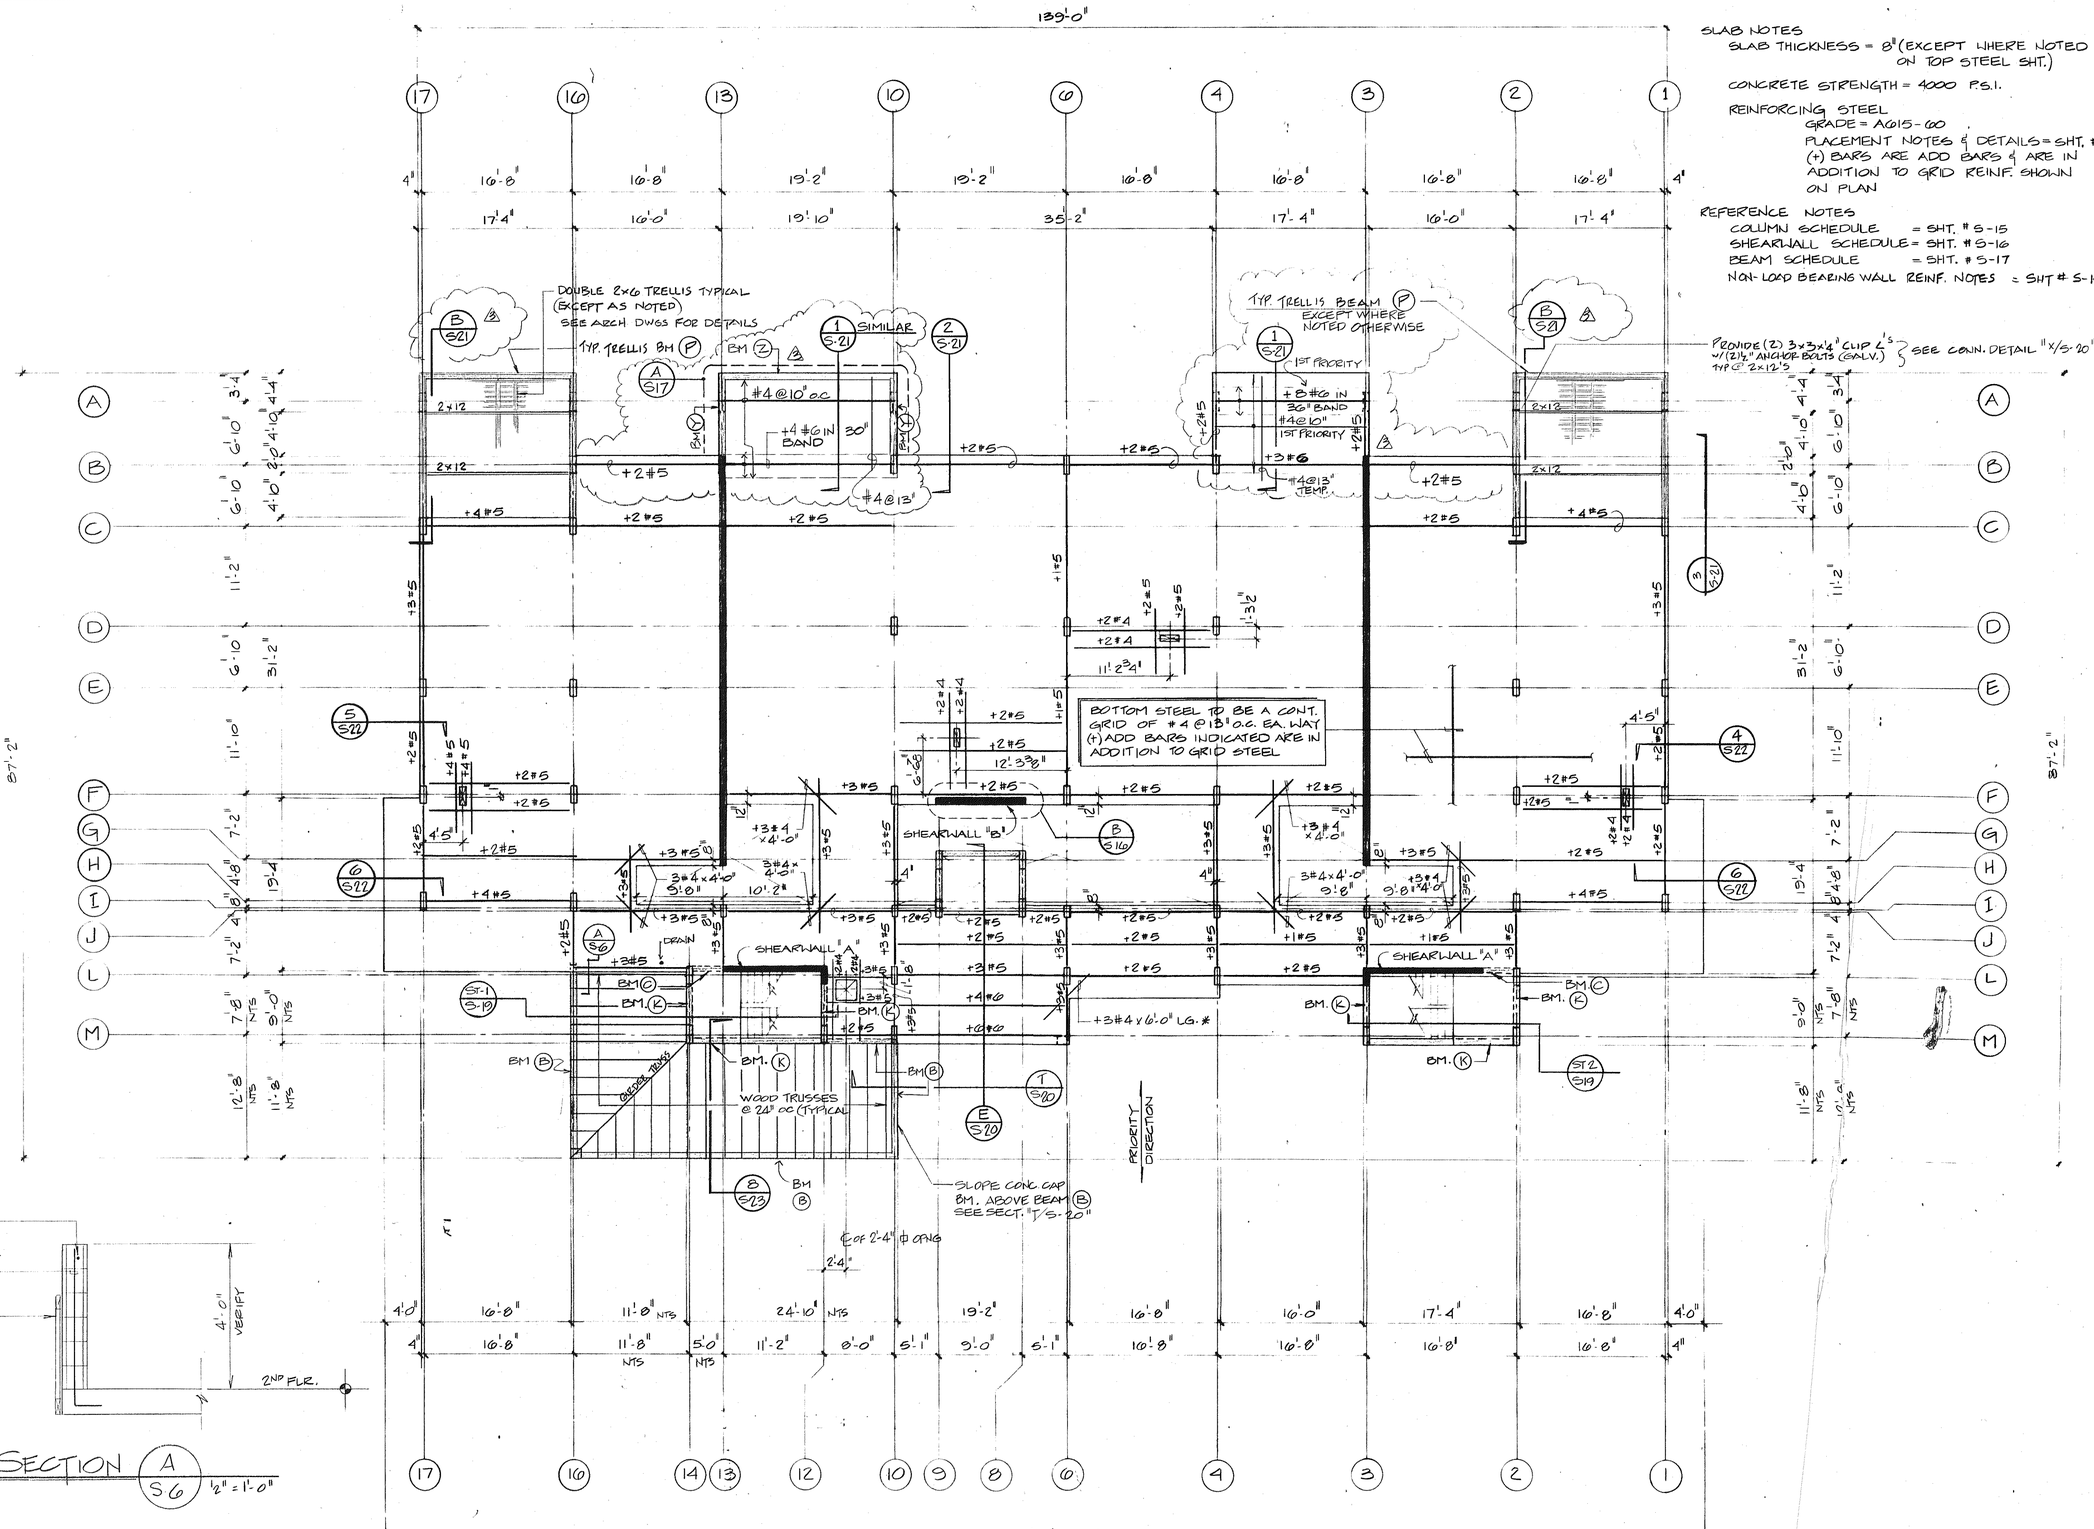

SUNSET BEACH OF LONGBOAT KEY

BLDG.- #2 SECOND FLOOR BOTTOM STEEL PLAN 1/8" = 1'-0"

ARVIDA CORPORATION · EDWARD J SEIBERT AIA ARCHITECT & PLANNER PA · THE SWA GROUP
BRABHAM KUHNS DEBAY CONSULTING ENGINEERS · OLSEN WHITE & ASSOCIATES STRUCTURAL ENGINEERS · BENNETT & BISHOP INC CONSULTING ENGINEERS & SURVEYORS

ISSUED	12-10-82
REVISED	1-4-83
	11-11-83

SHEET S.6 OF