

LEGEND

CHANGE IN PRIORITY BAR PLACEMENT

- ① FIRST PRIORITY
- ② SECOND PRIORITY
- ③ THIRD PRIORITY

SLAB STEPS AND SLOPES
(SEE ARCHITECTURAL DRAWINGS FOR EXACT LOCATIONS)

- ④ 3/4" DAP OUT
- ⑤ 3/4" STEP AT WALL LINE AND SLOPE SLAB TO EDGE

SLAB THICKNESS IN INCHES
(SEE ARCHITECTURAL DRAWINGS FOR SLOPE DETAILS)

5-1/2	6-3/4	7-1/2
6	7	7-3/4
6-1/2	7-1/4	8

SLAB THICKNESSES SHOWN ARE MINIMUM DIMENSIONS.

SLAB NOTES

SLAB THICKNESS = 8" (EXCEPT WHERE NOTED ON TOP STEEL SHT.)


CONCRETE STRENGTH = 4000 P.S.I.

REINFORCING STEEL

GRADE = A015-00
 PLACEMENT NOTES & DETAILS = SHT. #5-14
 (+) BARS ARE ADD BARS & ARE IN ADDITION TO GRID REIN. SHOWN ON PLAN

REFERENCE NOTES

COLUMN SCHEDULE = SHT. #5-15
 SHEARWALL SCHEDULE = SHT. #5-16
 BEAM SCHEDULE = SHT. #5-17

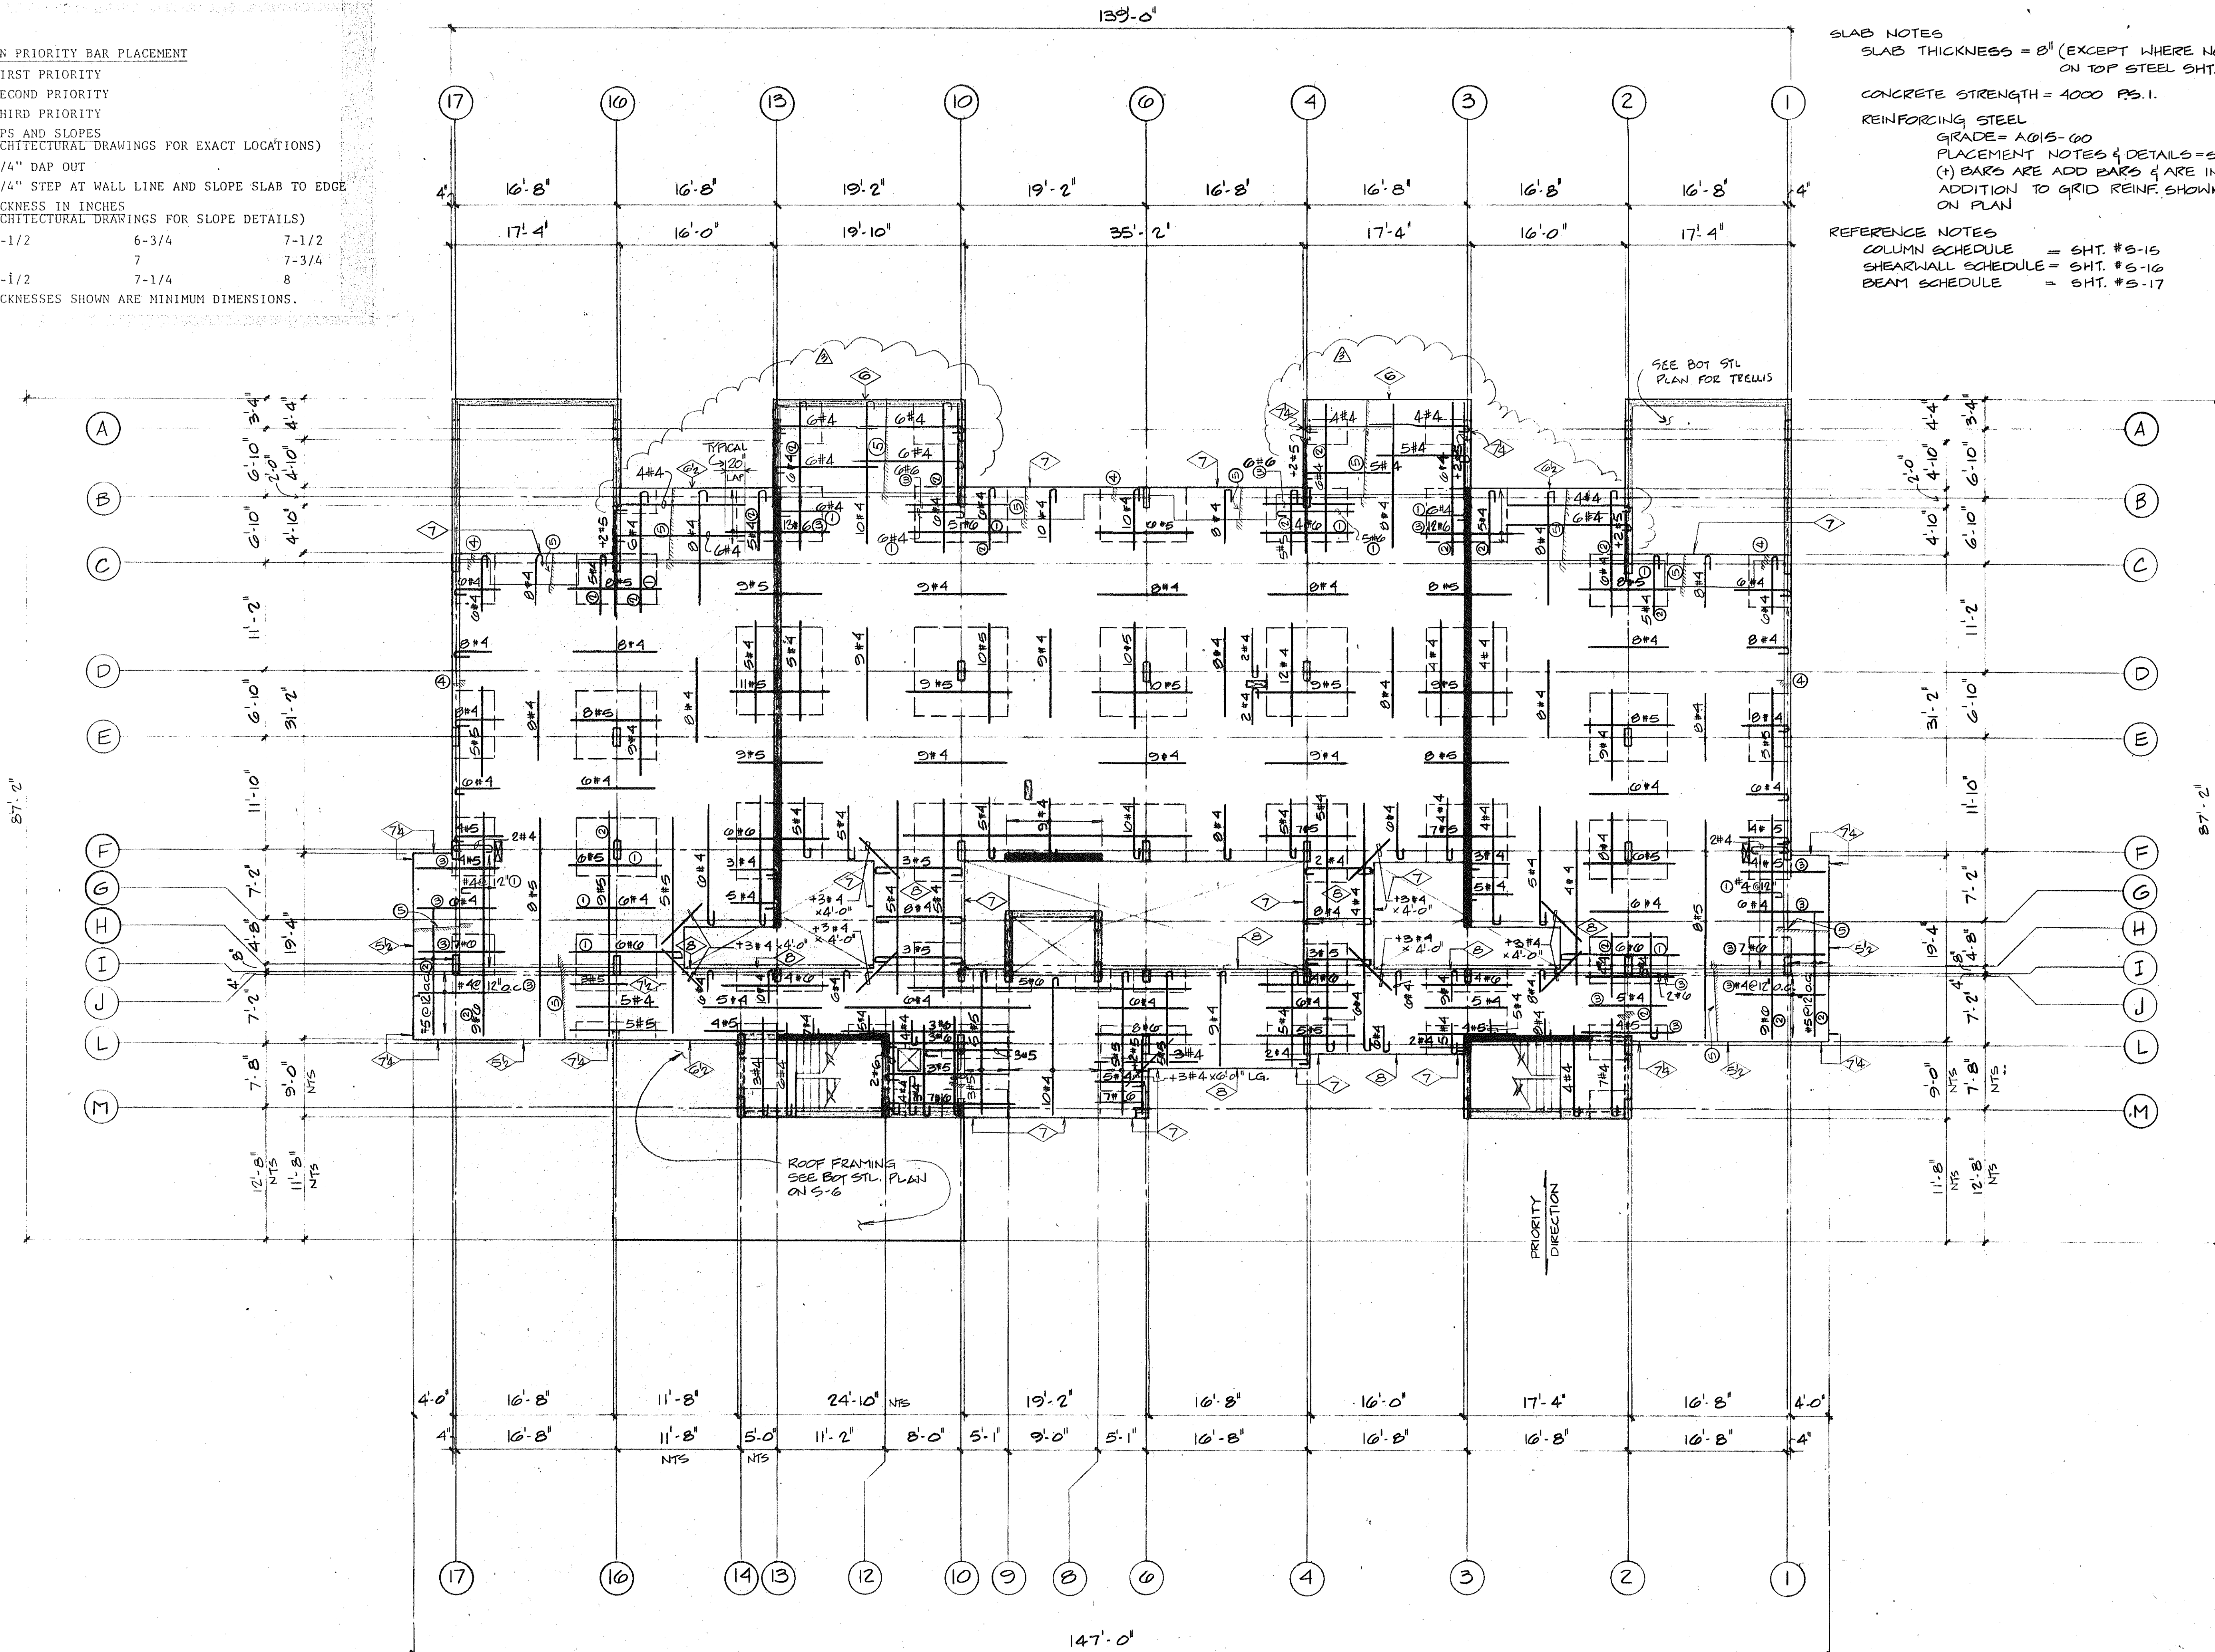

ISSUED	12-10-82
REVISED	1-4-83
	11-11-83