



UNIT "A" AND "A1" WATER RISER

n.t.s.

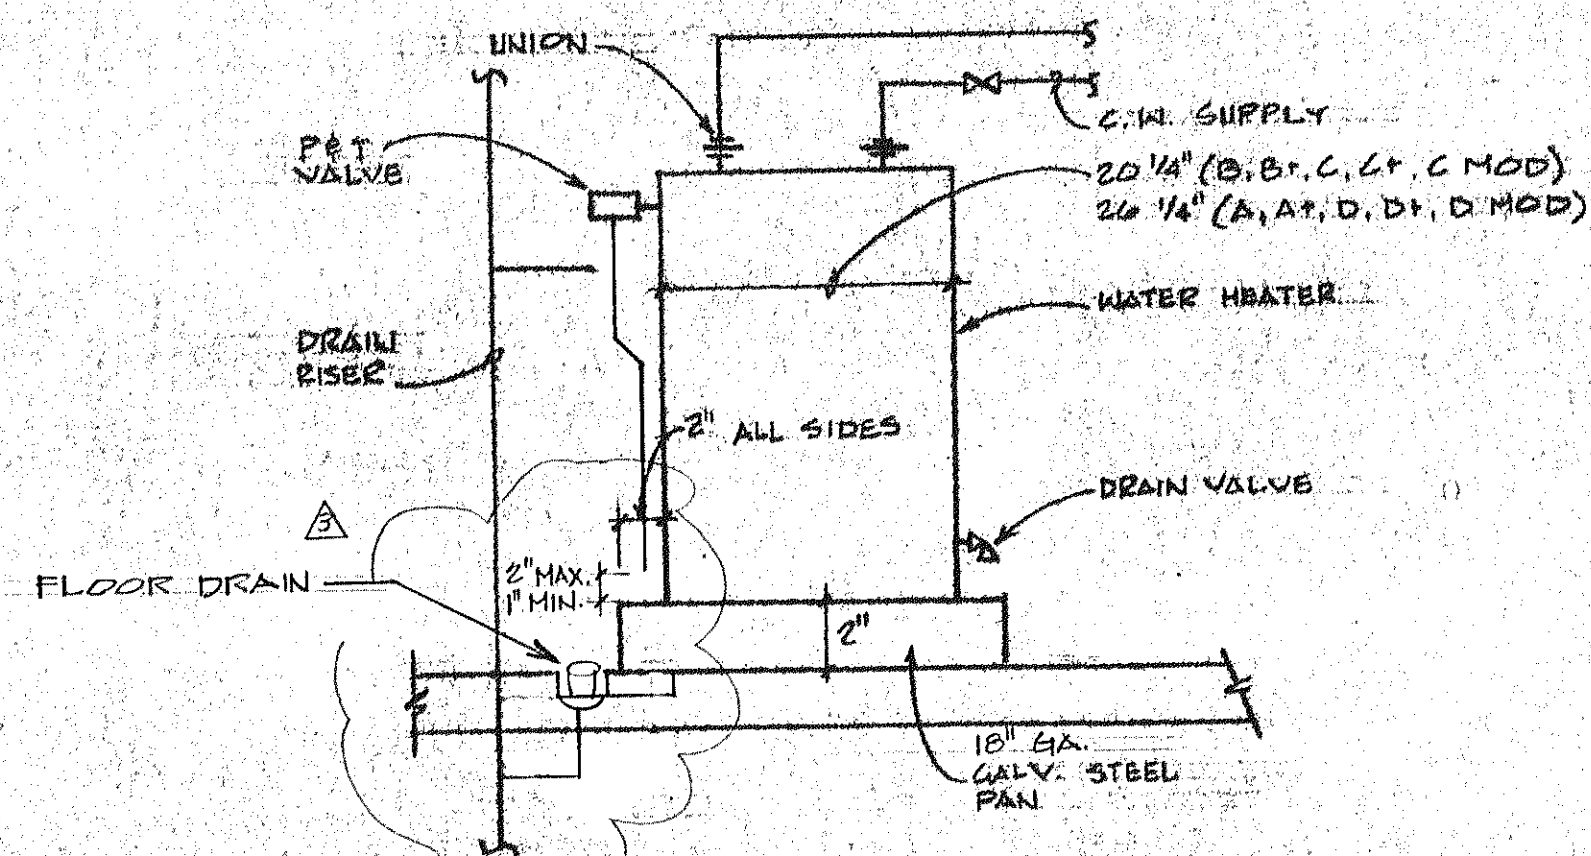


WATER HEATER DETAIL

WATER HEATERS SHALL BE 40 GAL.
 4.5 KW @ 208 VOLT
 "RHEEM" 668-40D (B, B1, C, L1, C MOD)
 "RHEEM" 668-40D (A, A1, D, D1, D MOD)

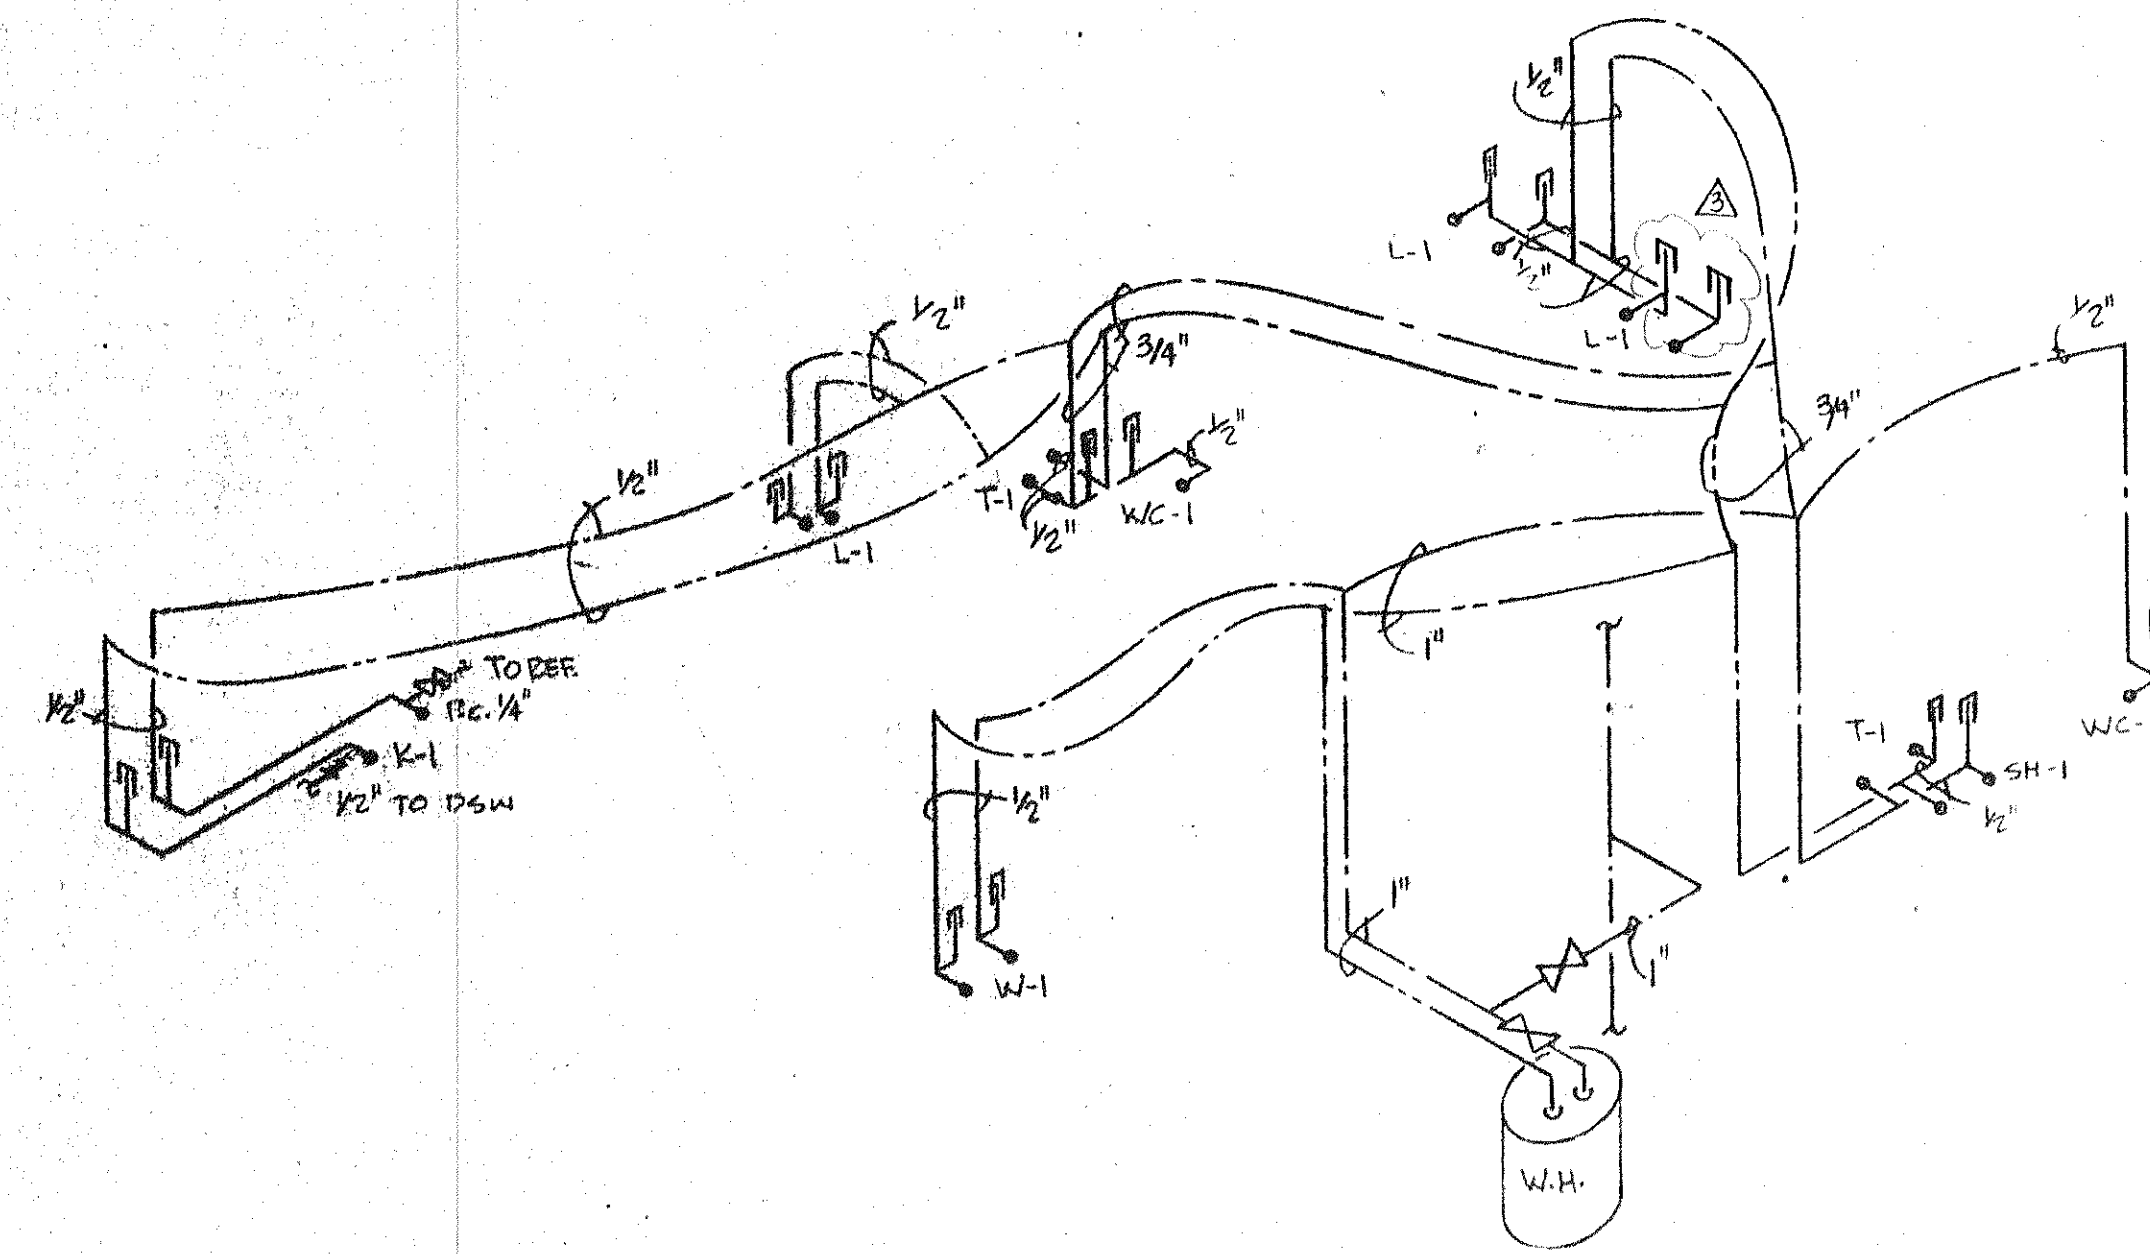


UNIT "D" WATER RISER

n.t.s.

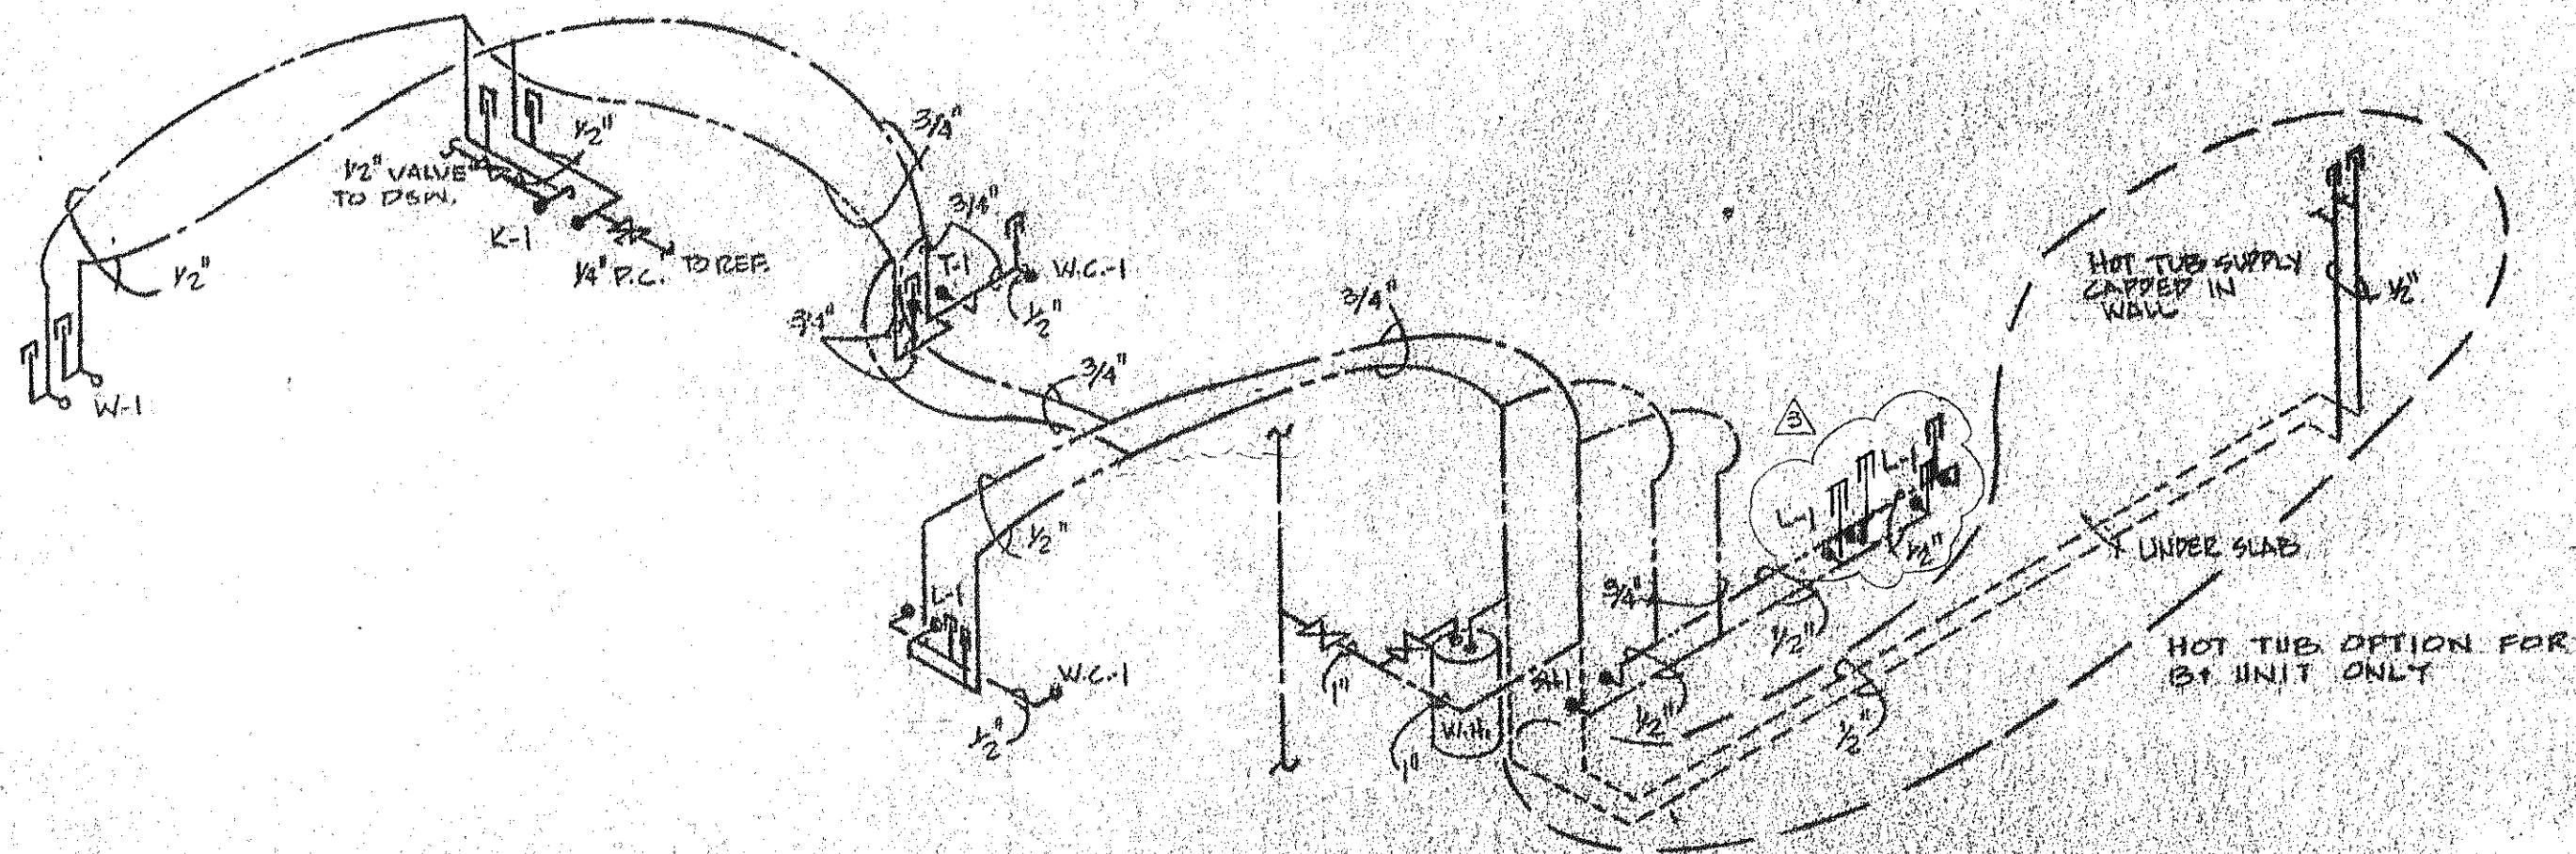


UNIT "B" AND "B1" WATER RISER

n.t.s.

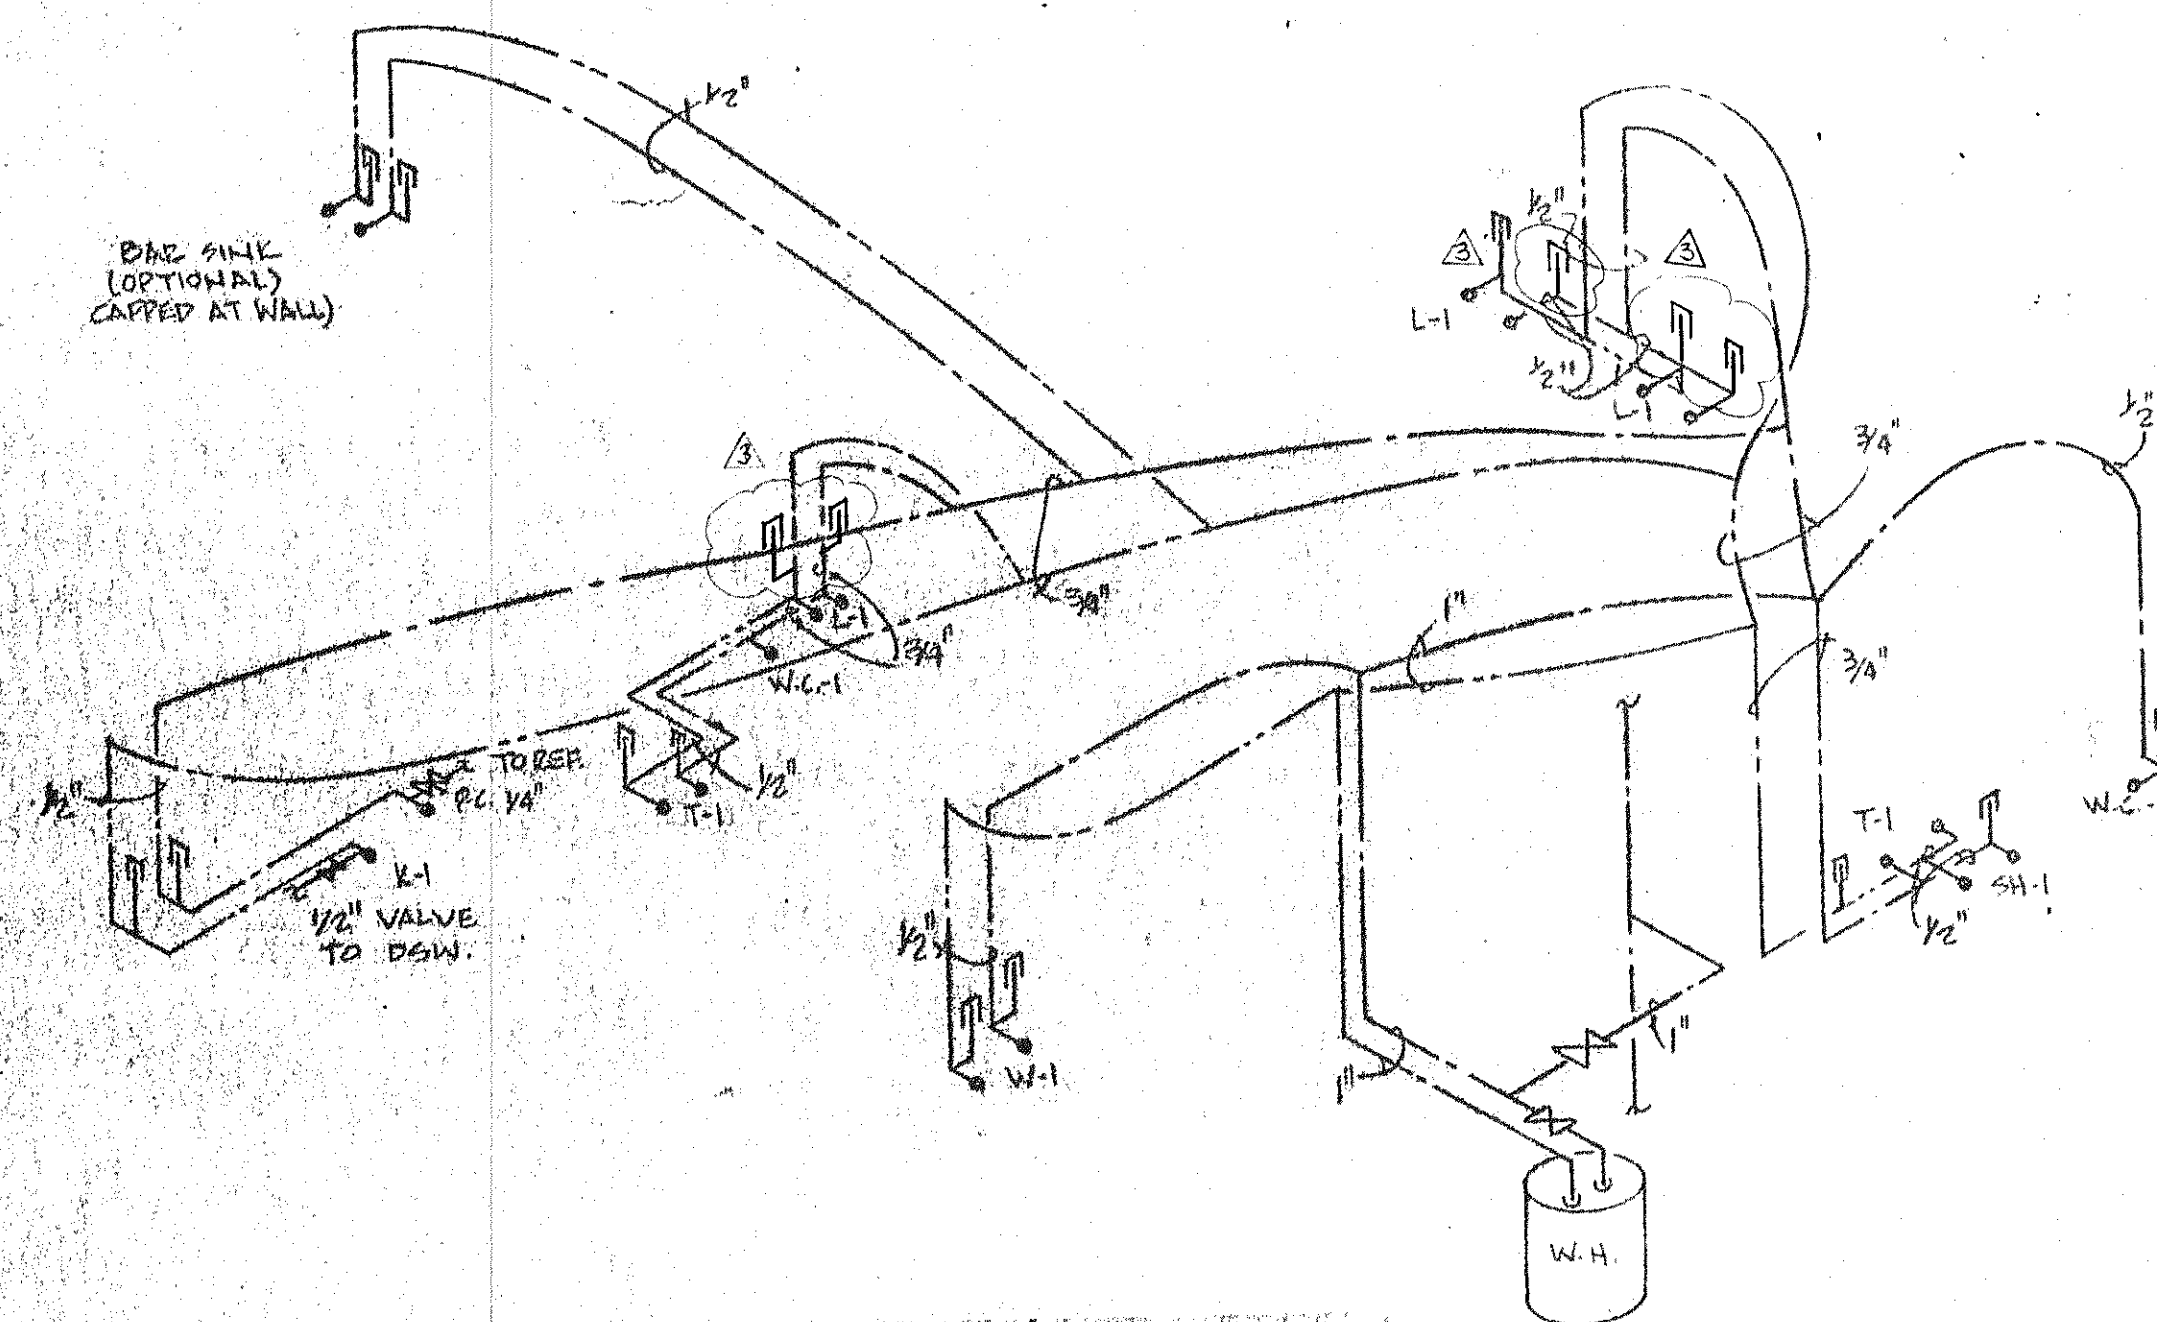


UNIT "D MOD" WATER RISER

n.t.s.

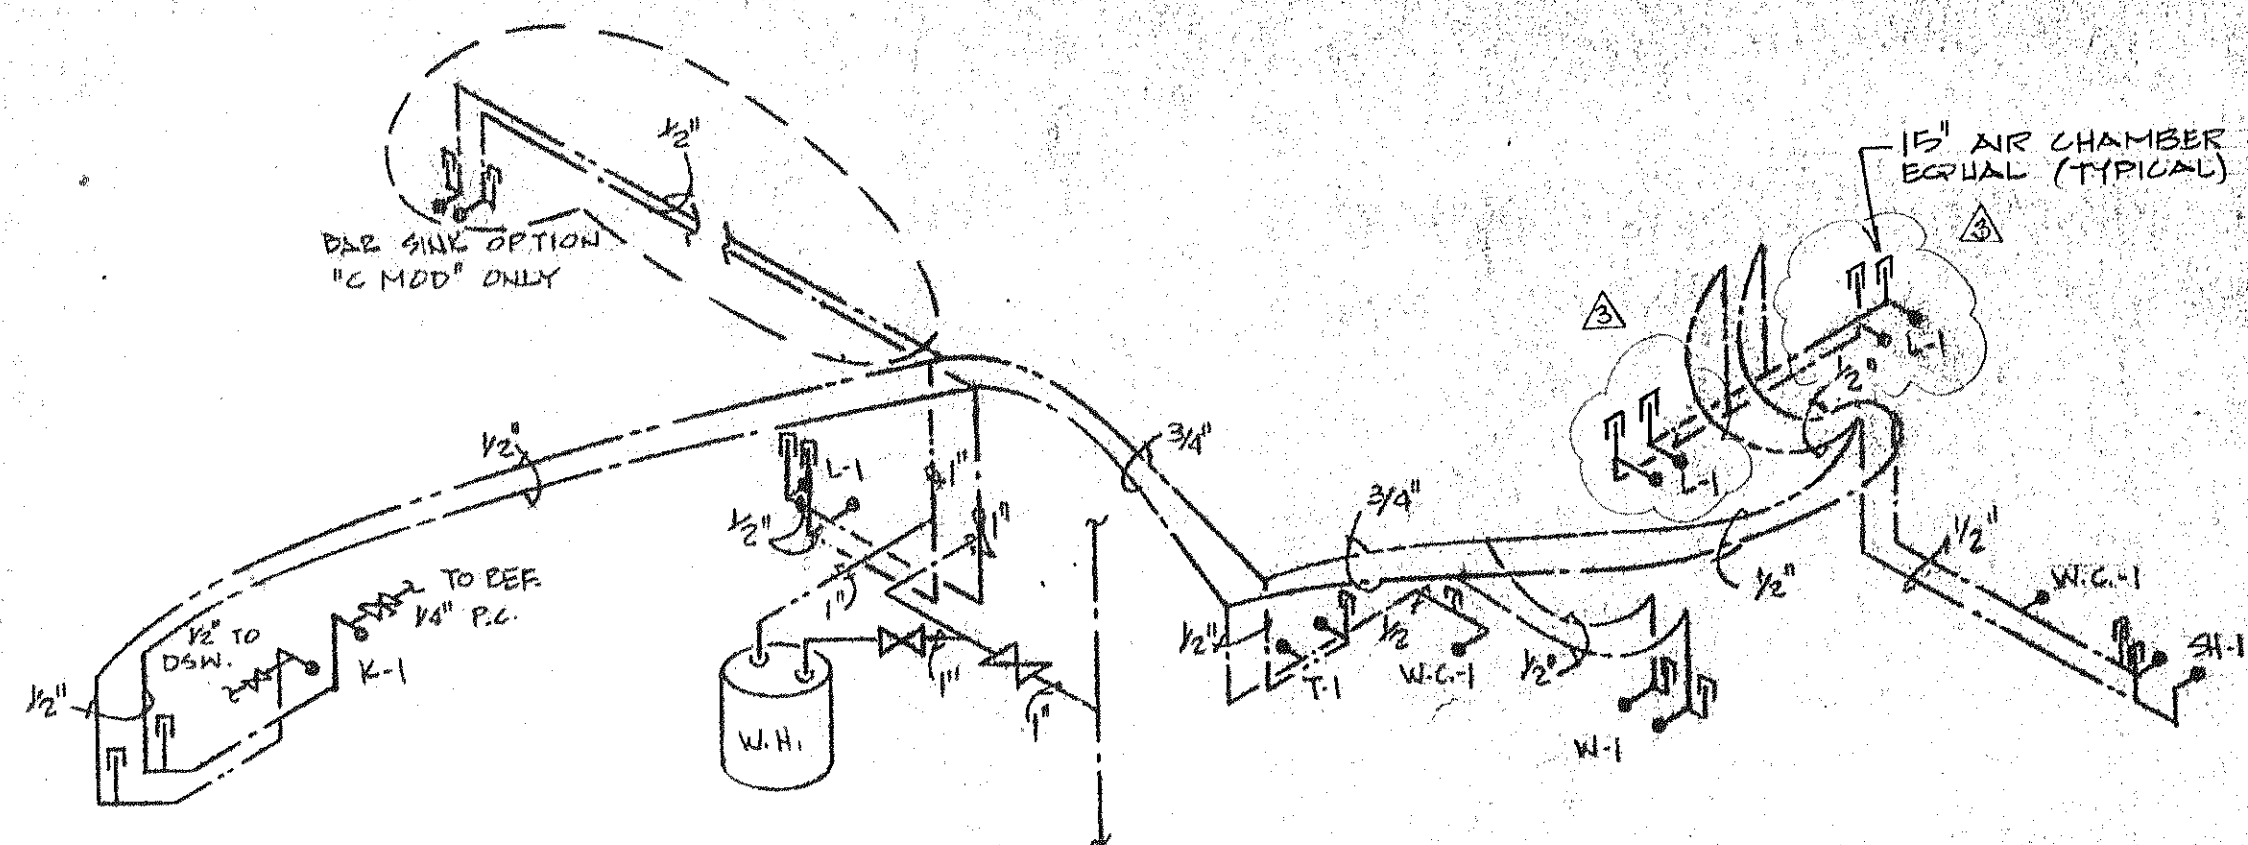

UNIT "C", "C1" AND "C MOD" WATER RISER

n.t.s.

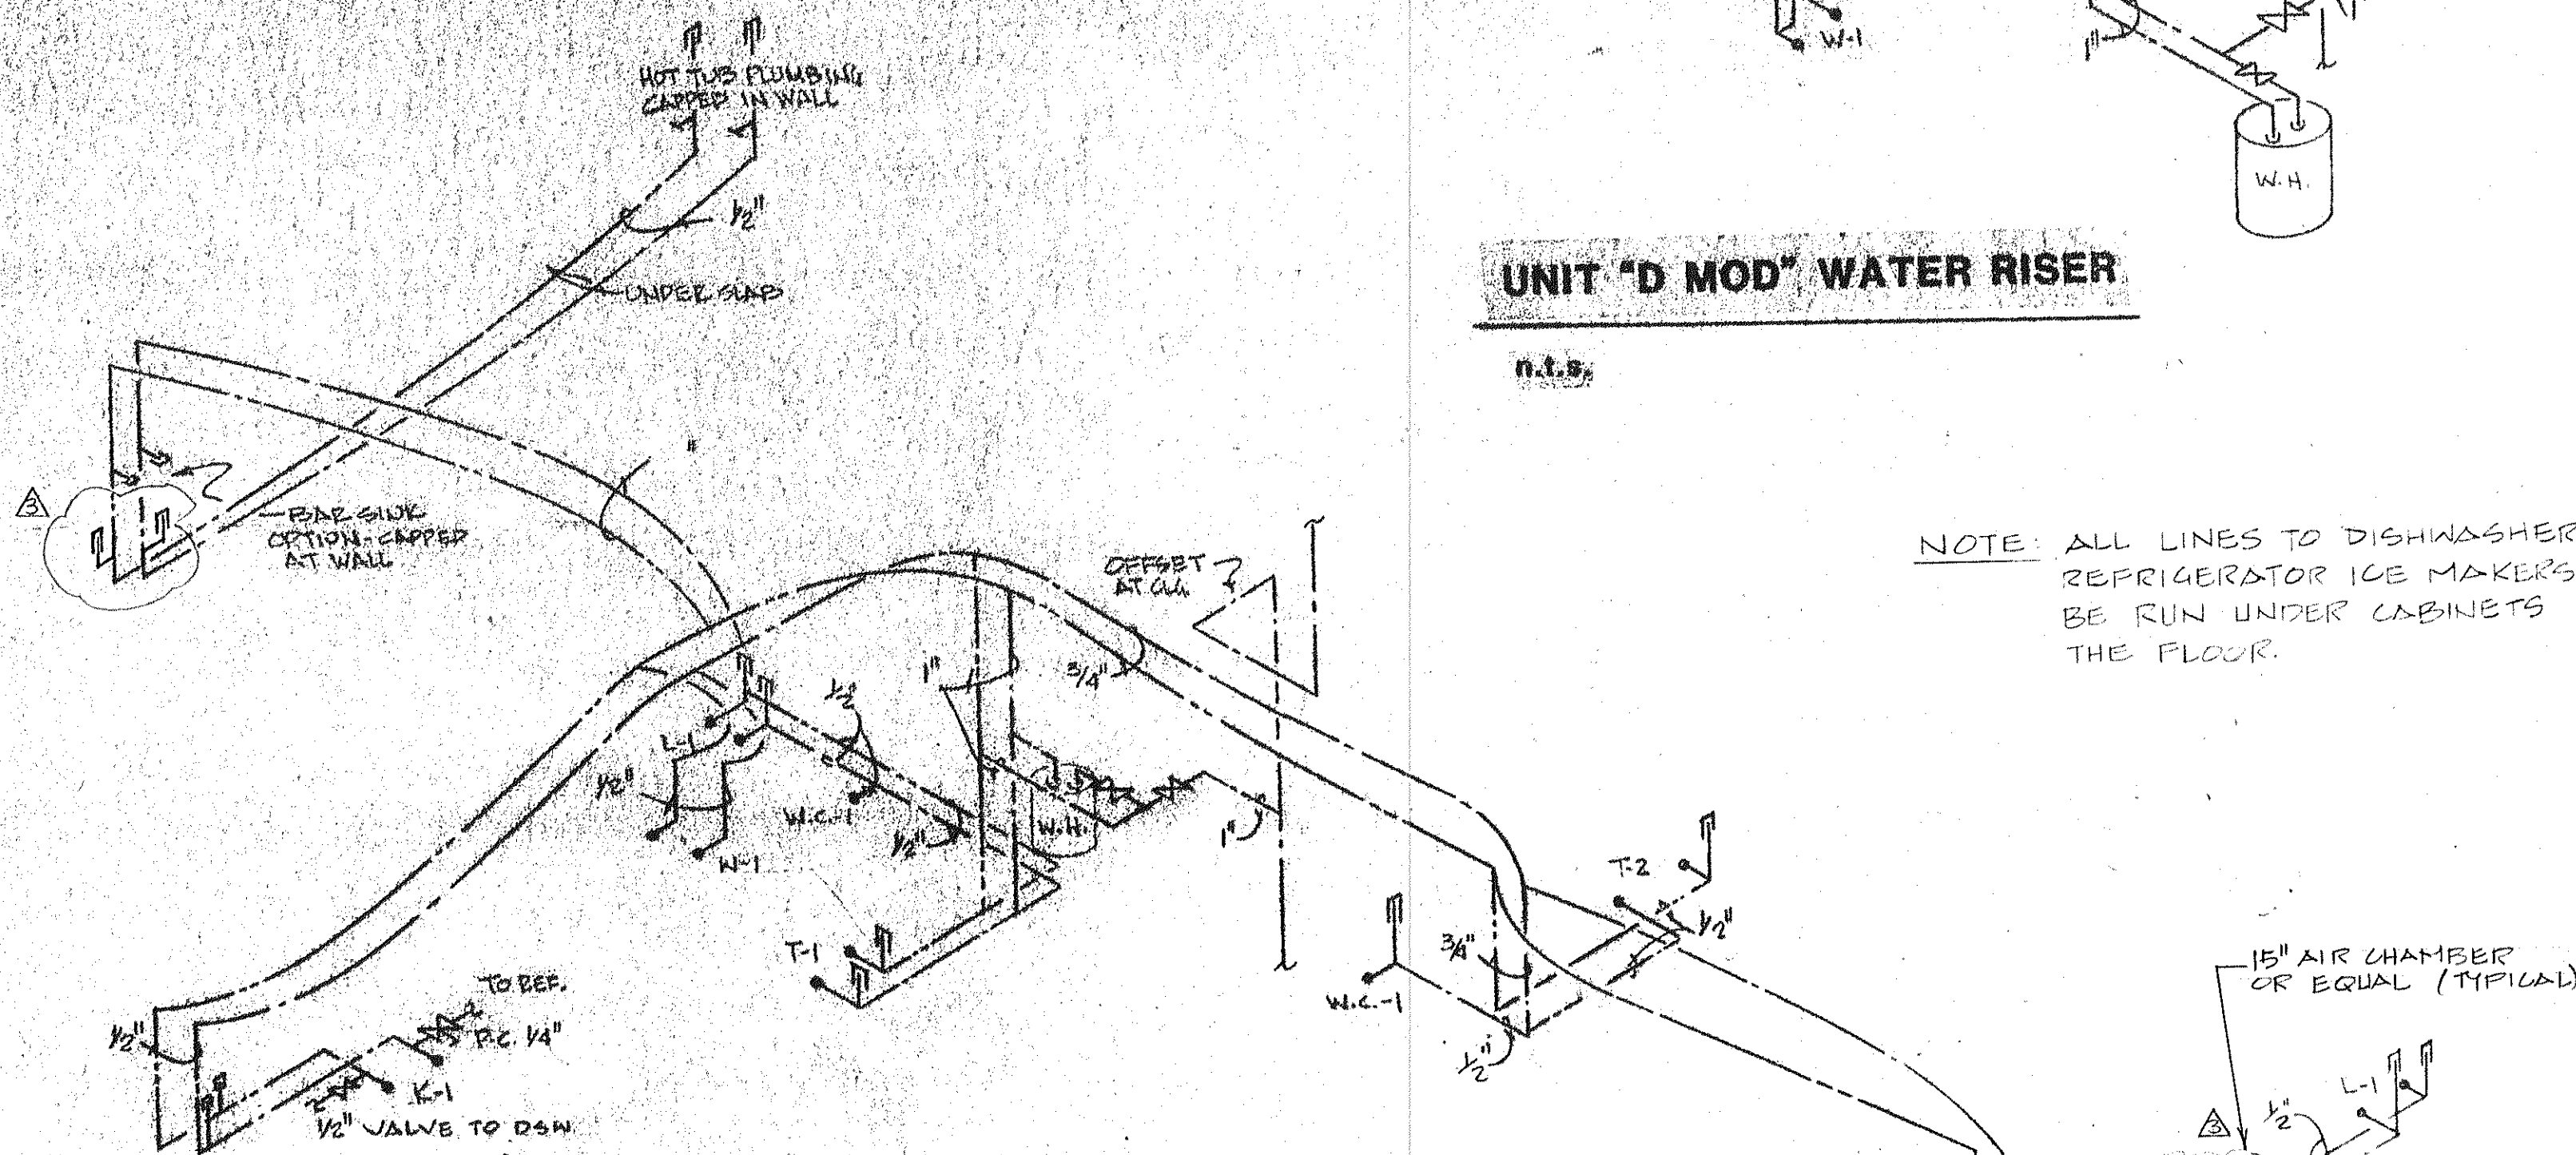


n.t.s.

NOTE: ALL LINES TO DISHWASHERS AND REFRIGERATOR ICE MAKERS SHOULD BE RUN UNDER CABINETS AND ABOVE THE FLOOR.