


UNIT 'A' LEFT - AIR CONDITIONING

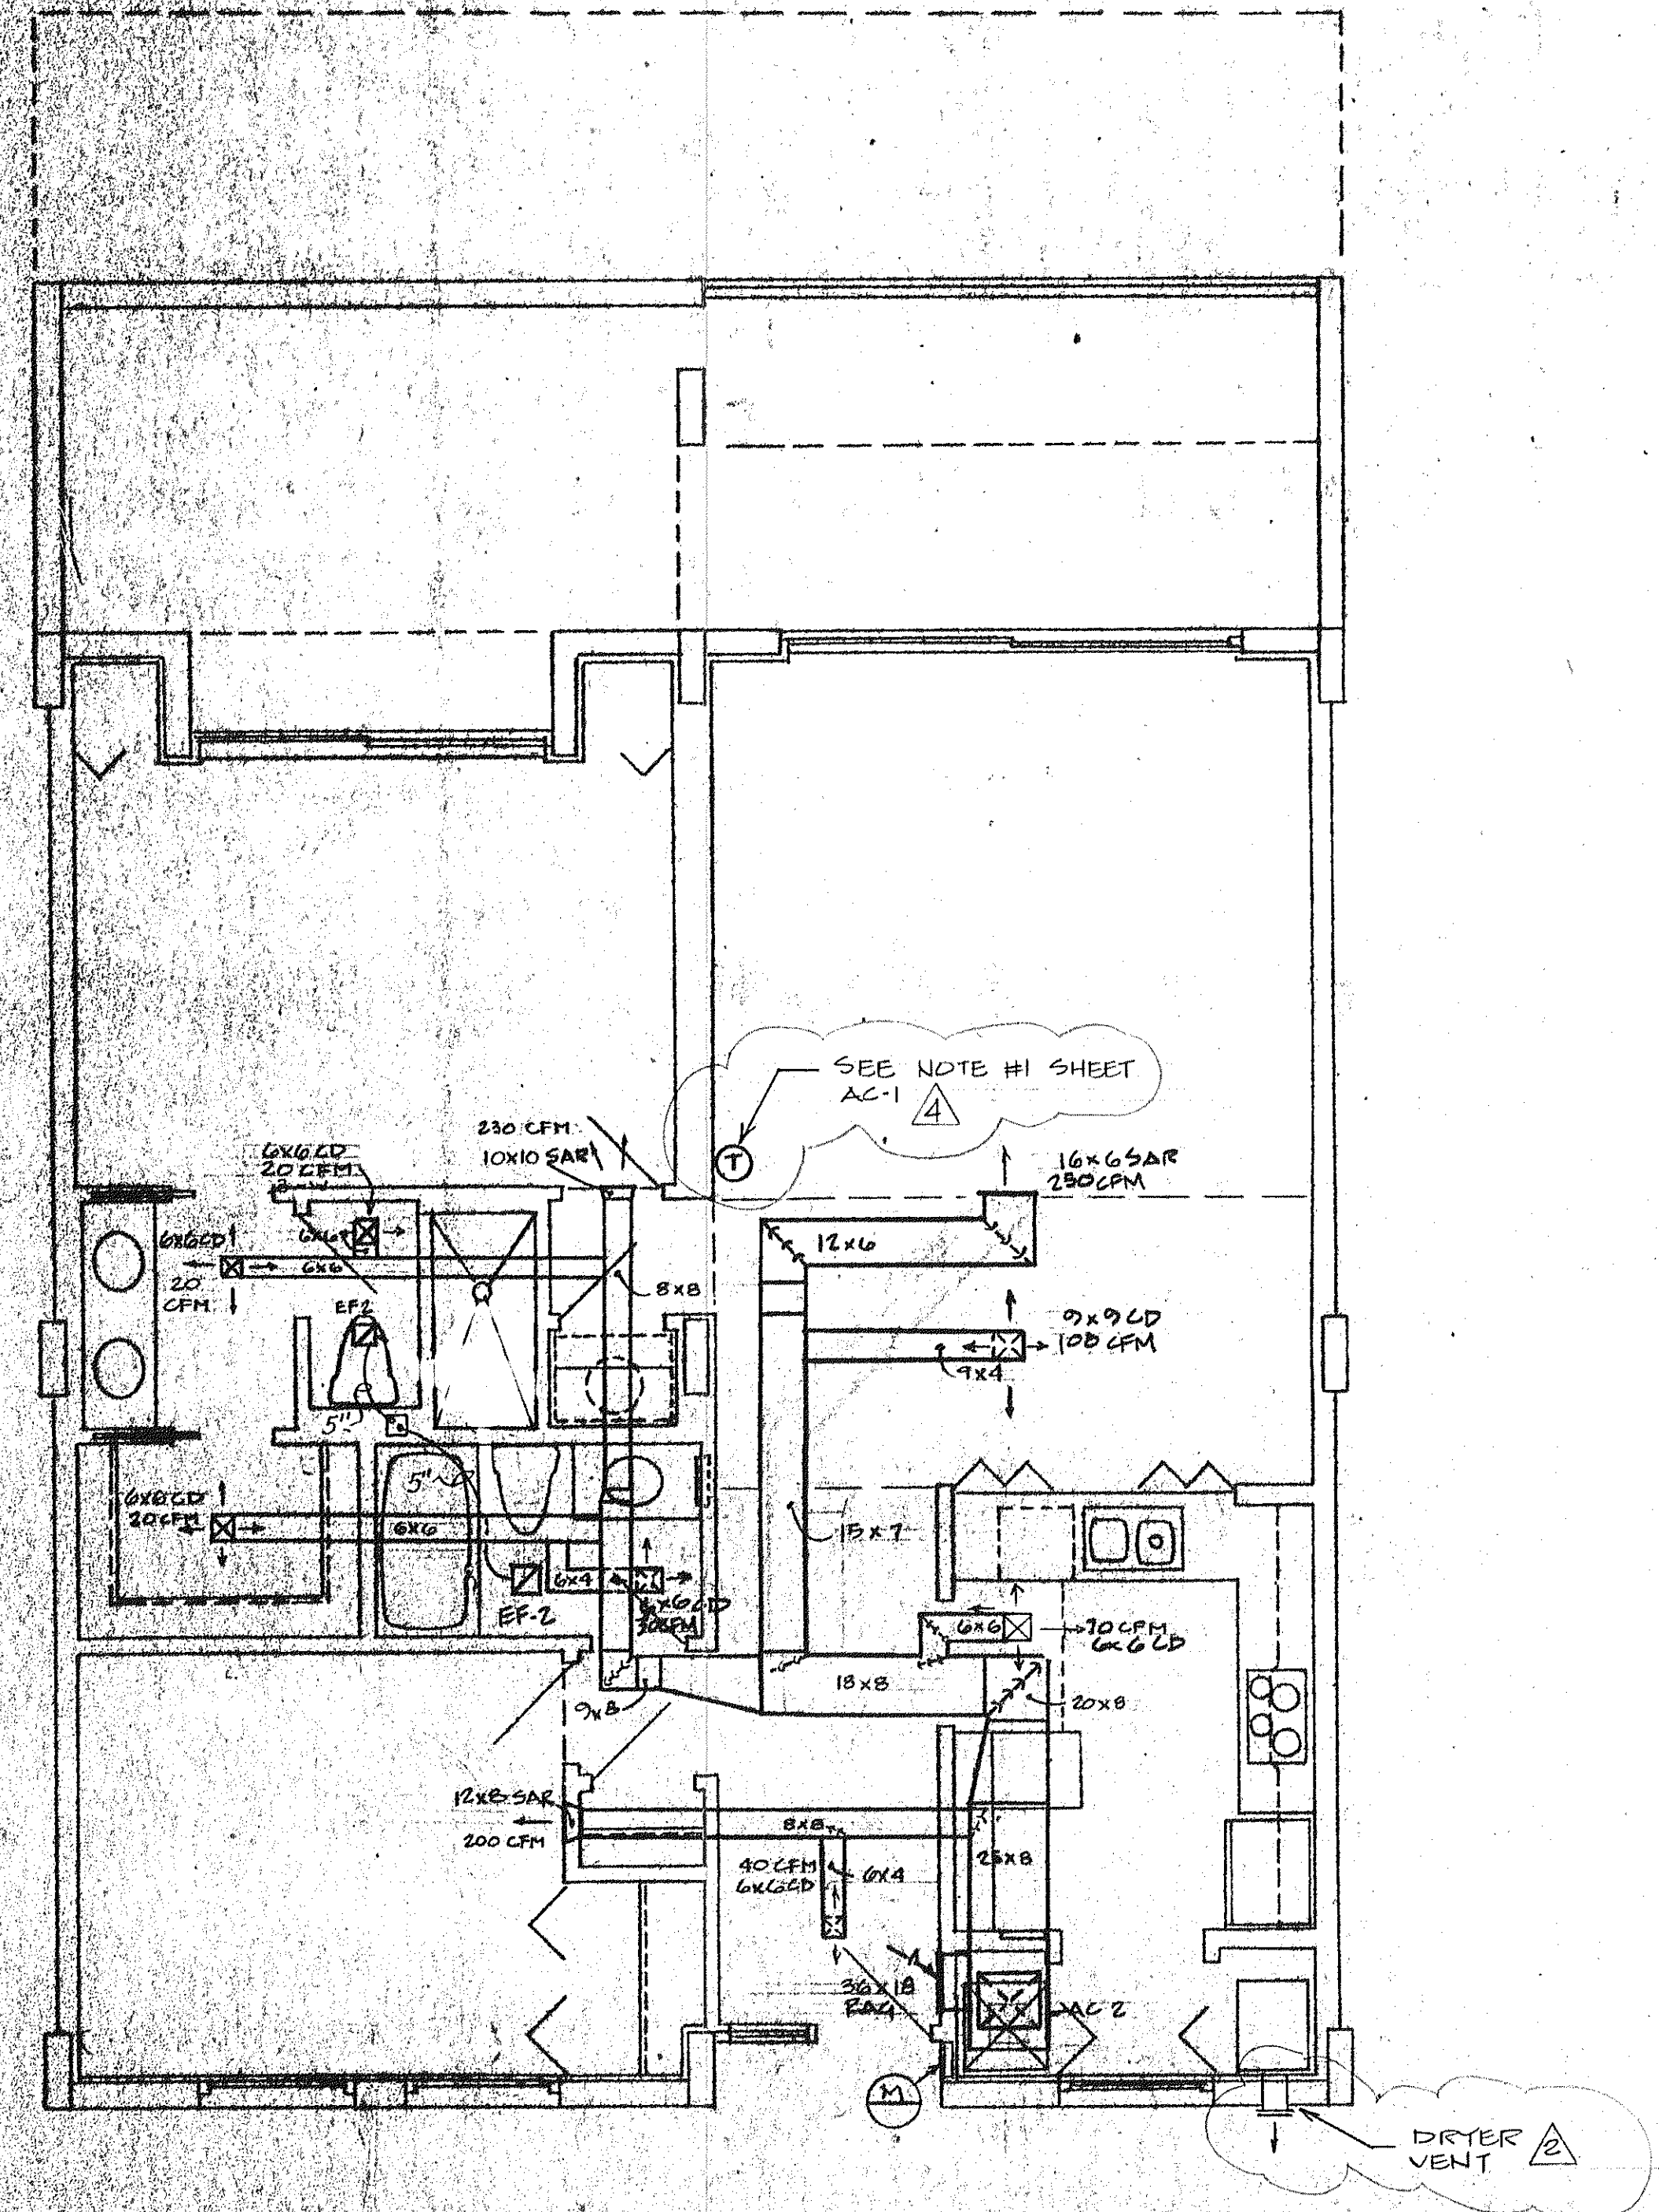

UNIT 'A' RIGHT - AIR CONDITIONING