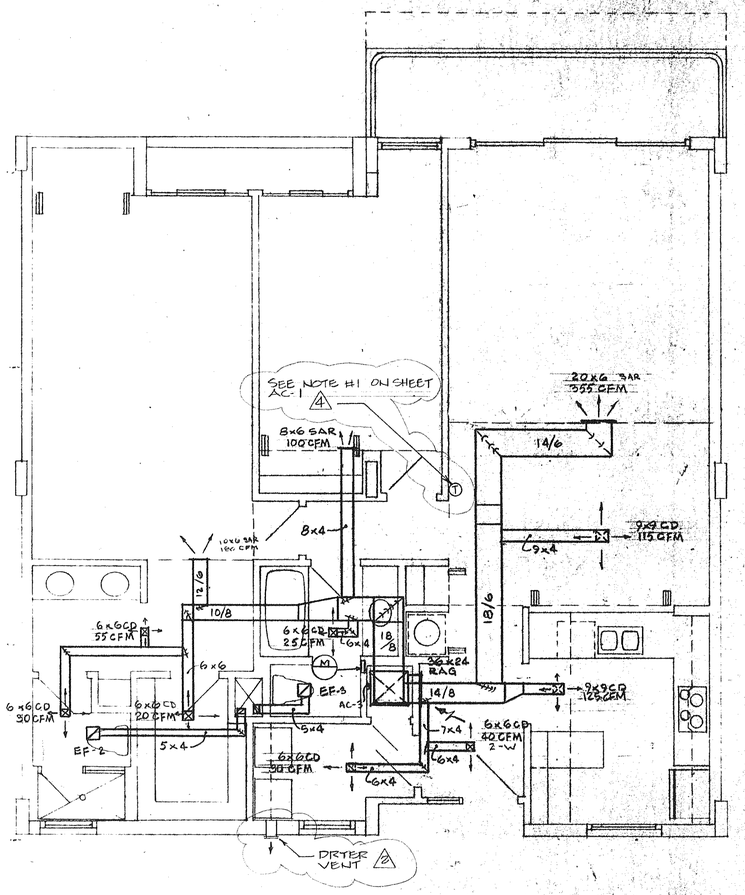

UNIT "C" LEFT AIR CONDITIONING

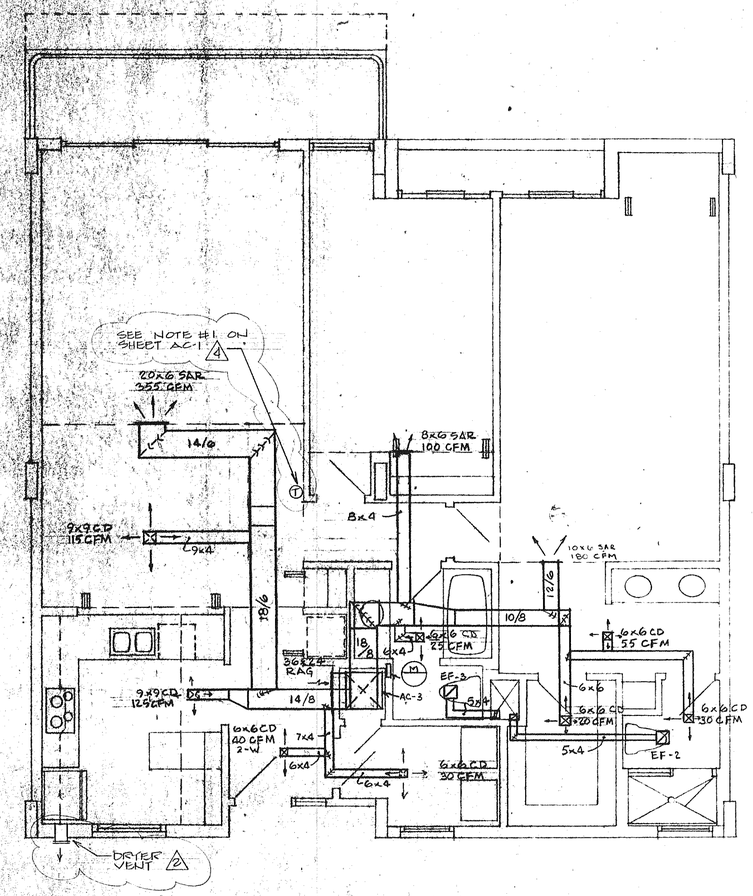

UNIT "C" RIGHT AIR CONDITIONING

SUNSET BEACH OF LONG BOAT KEY

ARVICA CORPORATION · EDWARD J. SEIBERT AIA ARCHITECT & PLANNER PA · THE SWA GROUP
BRABHAM KUHNS DEBAY CONSULTING ENGINEERS · BENNETT & BISHOP CONSULTING ENGINEERS & SURVEYORS · OLSEN WHITE & ASSOCIATES STRUCTURAL ENGINEERS

ISSUED
4-1-83

REVISED
1 DEVELOPMENT 7-20-83
2 AGENCY REVIEW 8-15-83

SHEET
AC-3
BLDG. 3
OF