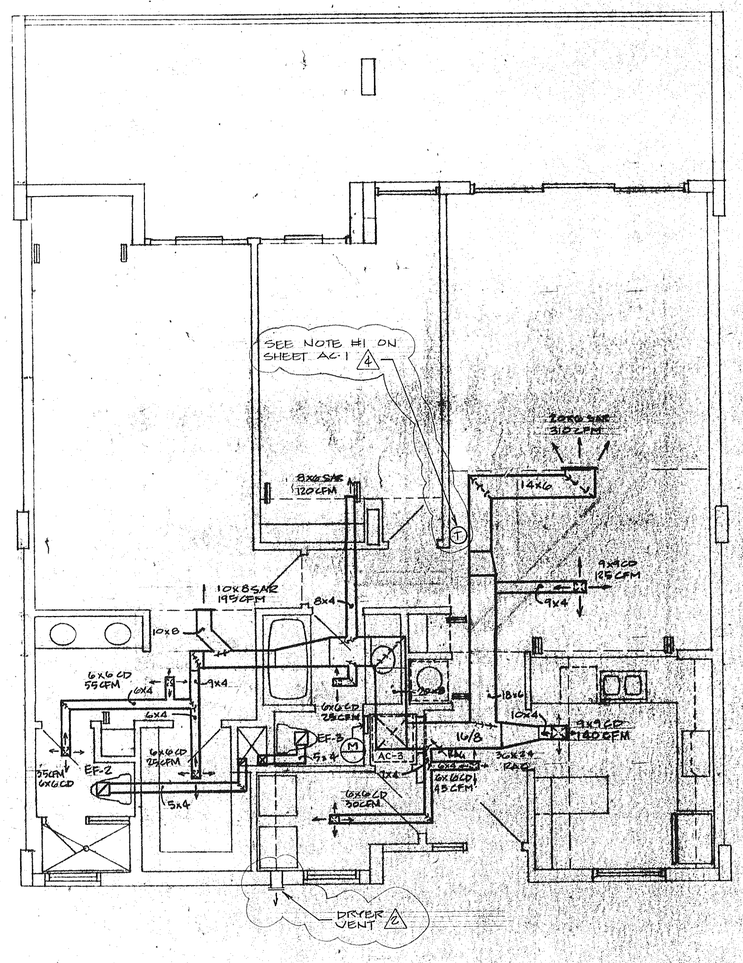

UNIT "C" • LEFT- AIR CONDITIONING

scale: 1/4" = 1'-0"

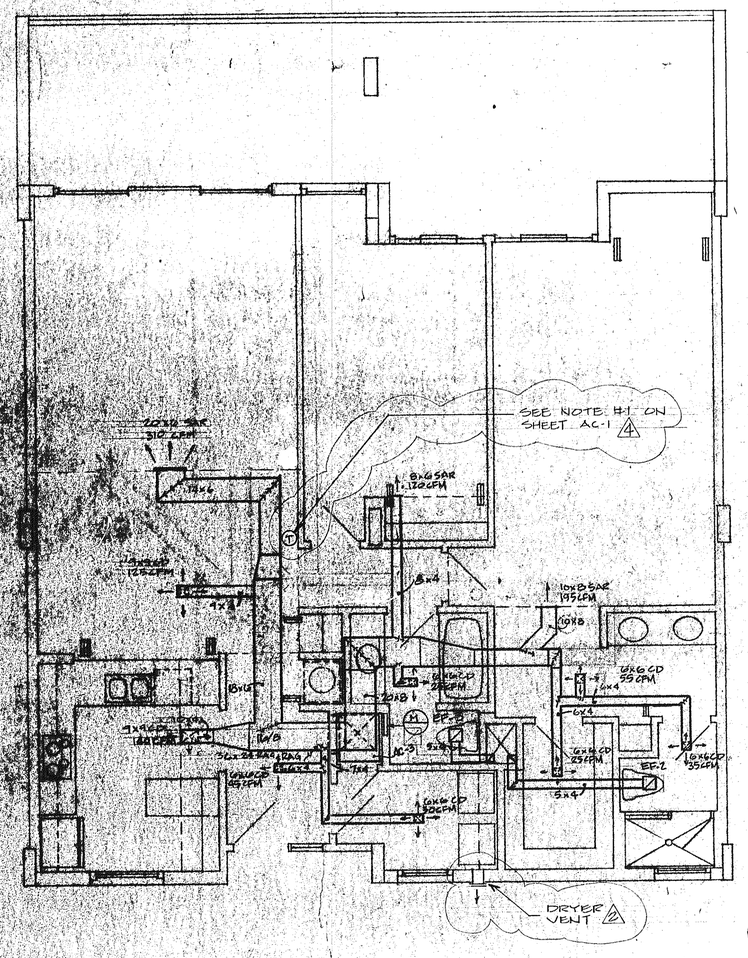

UNIT "C" • RIGHT- AIR CONDITIONING

scale: 1/4" = 1'-0"

SUNSET BEACH
OF LONG BOAT KEY

ARVIDA CORPORATION · EDWARD J. SEIBERT AIA ARCHITECT & PLANNER PA · THE SWA GROUP
BRABHAM, KUHNS, DEBAY CONSULTING ENGINEERS · OLSEN, WHITE & ASSOCIATES STRUCTURAL ENGINEERS · BENNETT & BISHOP CONSULTING ENGINEERS & SURVEYORS

ISSUED
9-1-73

REVISED
2 DEVELOPMENT 1-20-75
4 ACCESSIBILITY 6-25-75

SHEET
AC-4
BLDG. 3
OF