


UNIT "C" MOD LEFT - AIR CONDITIONING

scale 1/4" = 1'-0"

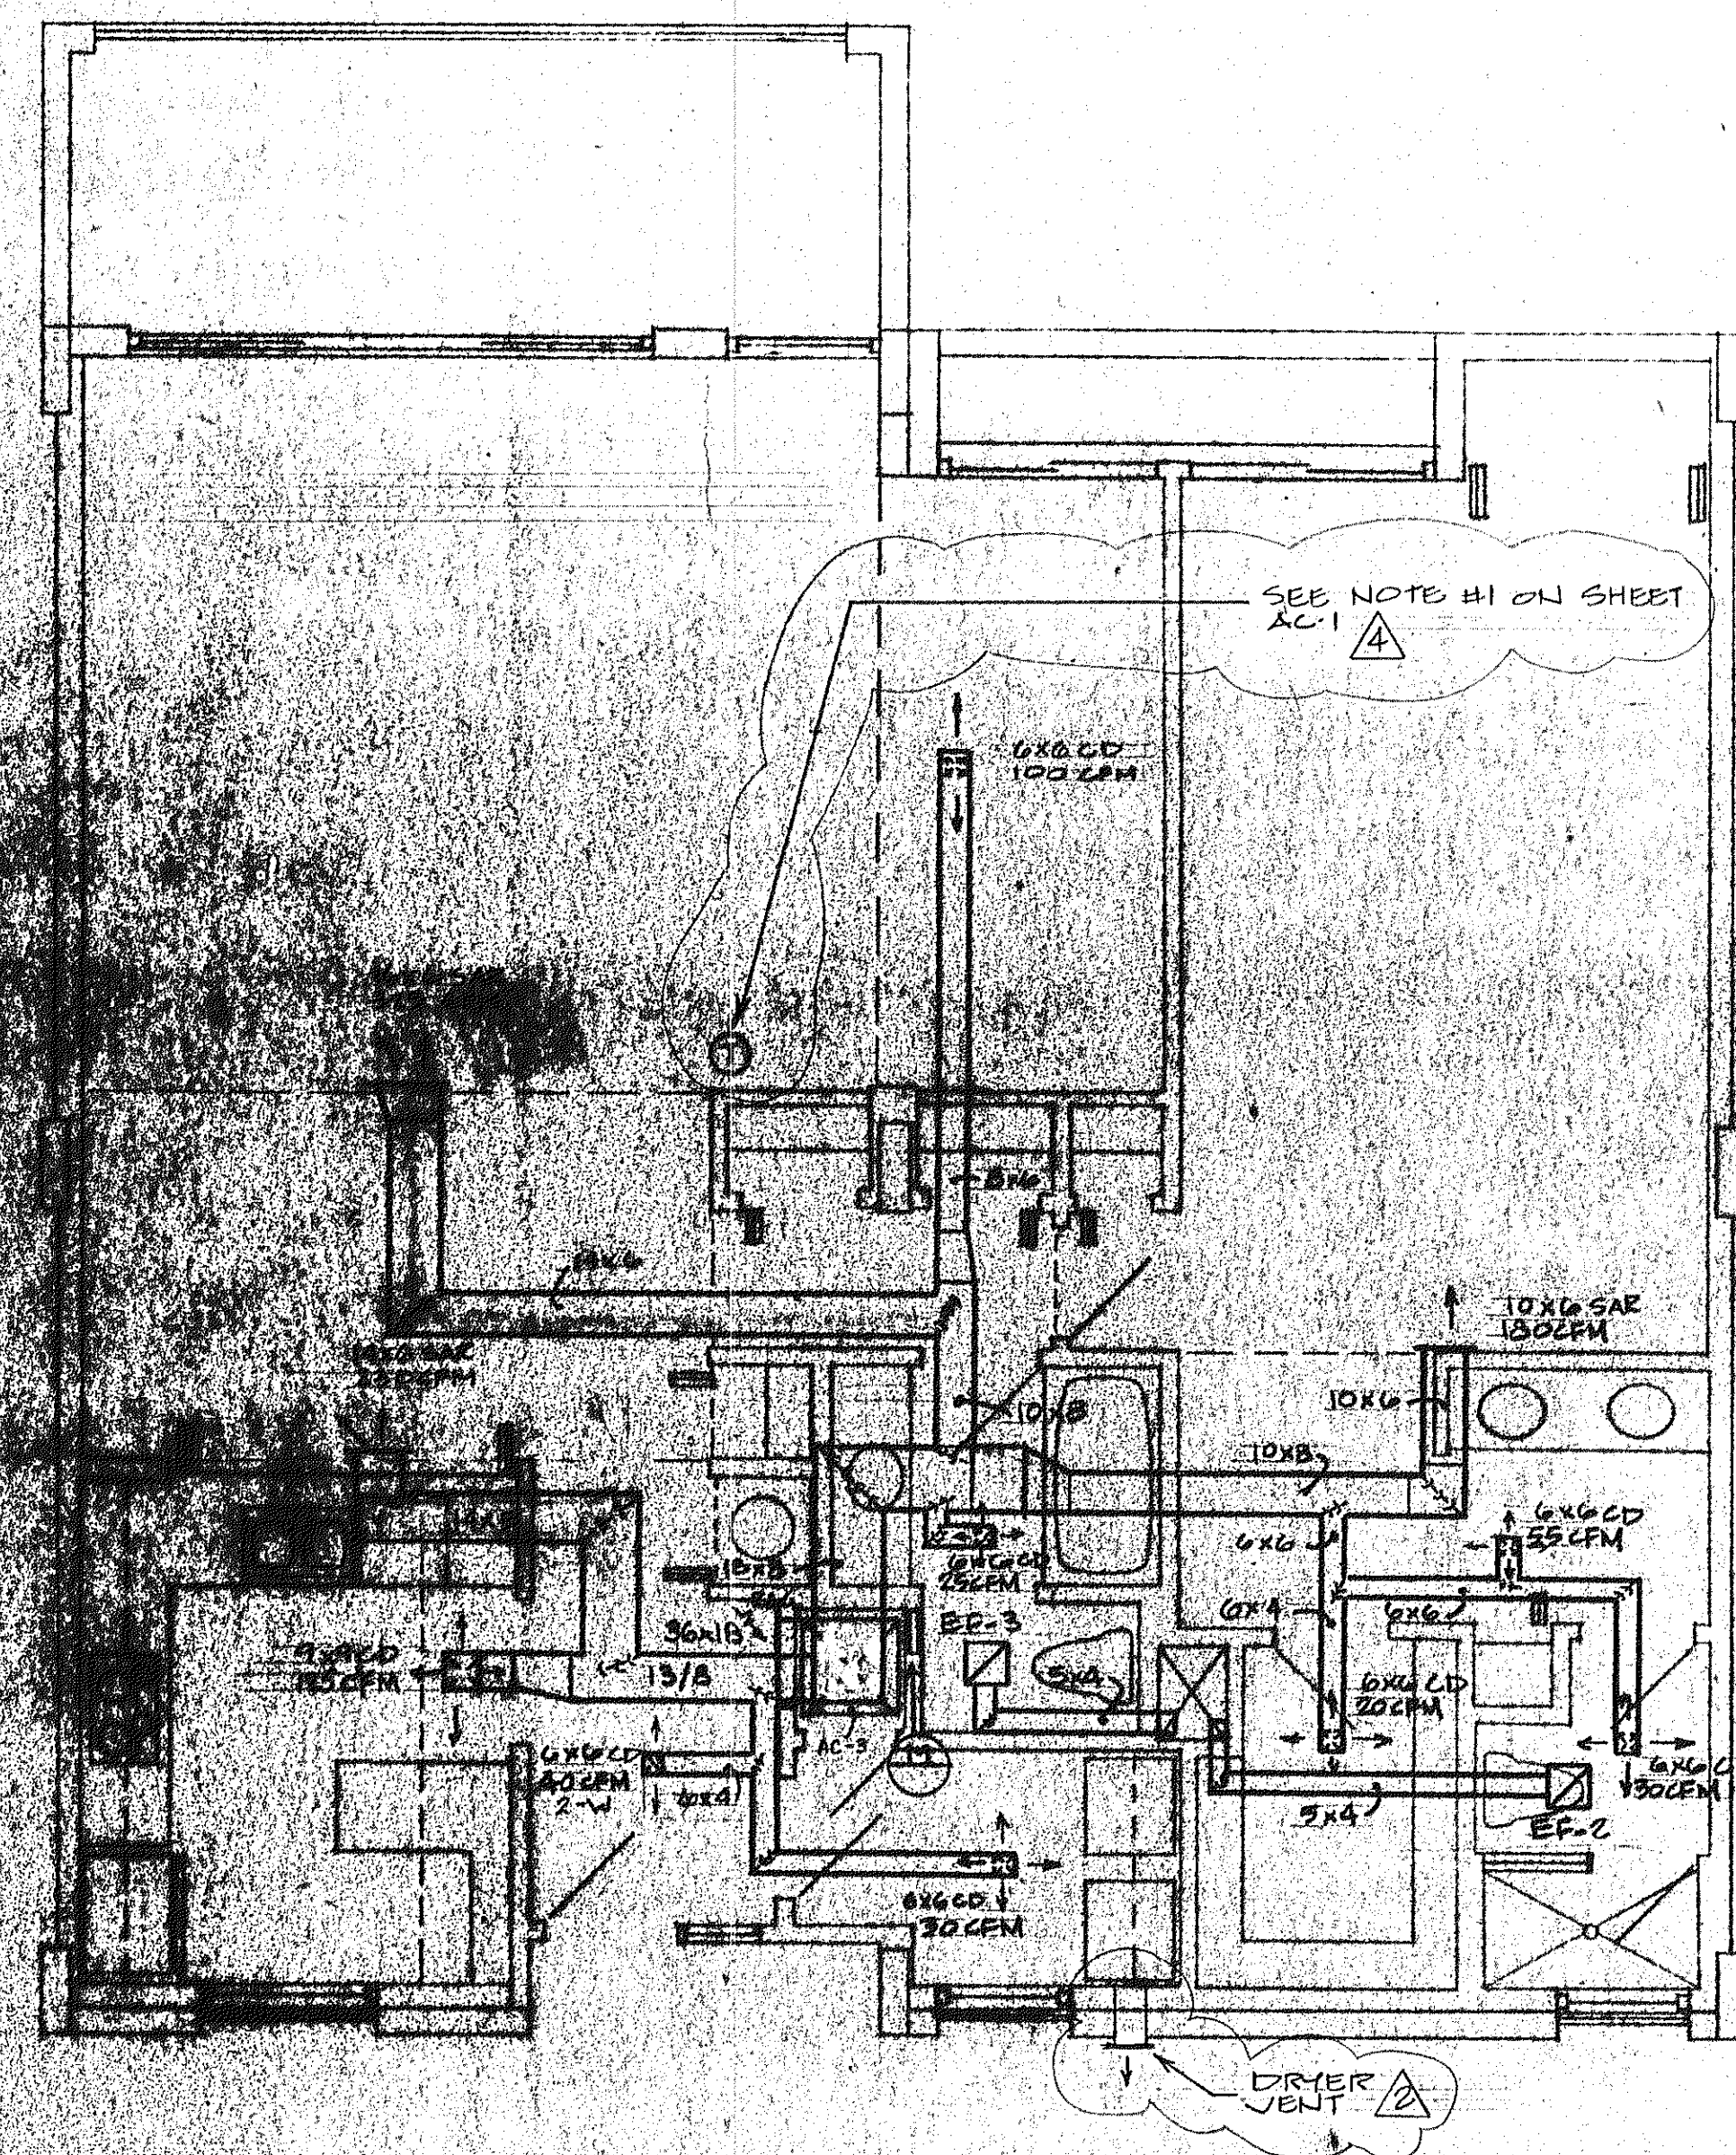

UNIT "C" MOD RIGHT - AIR CONDITIONING

scale 1/4" = 1'-0"