


**UNIT "D" LEFT - AIR CONDITIONING**

scale 1/4" = 1'-0"

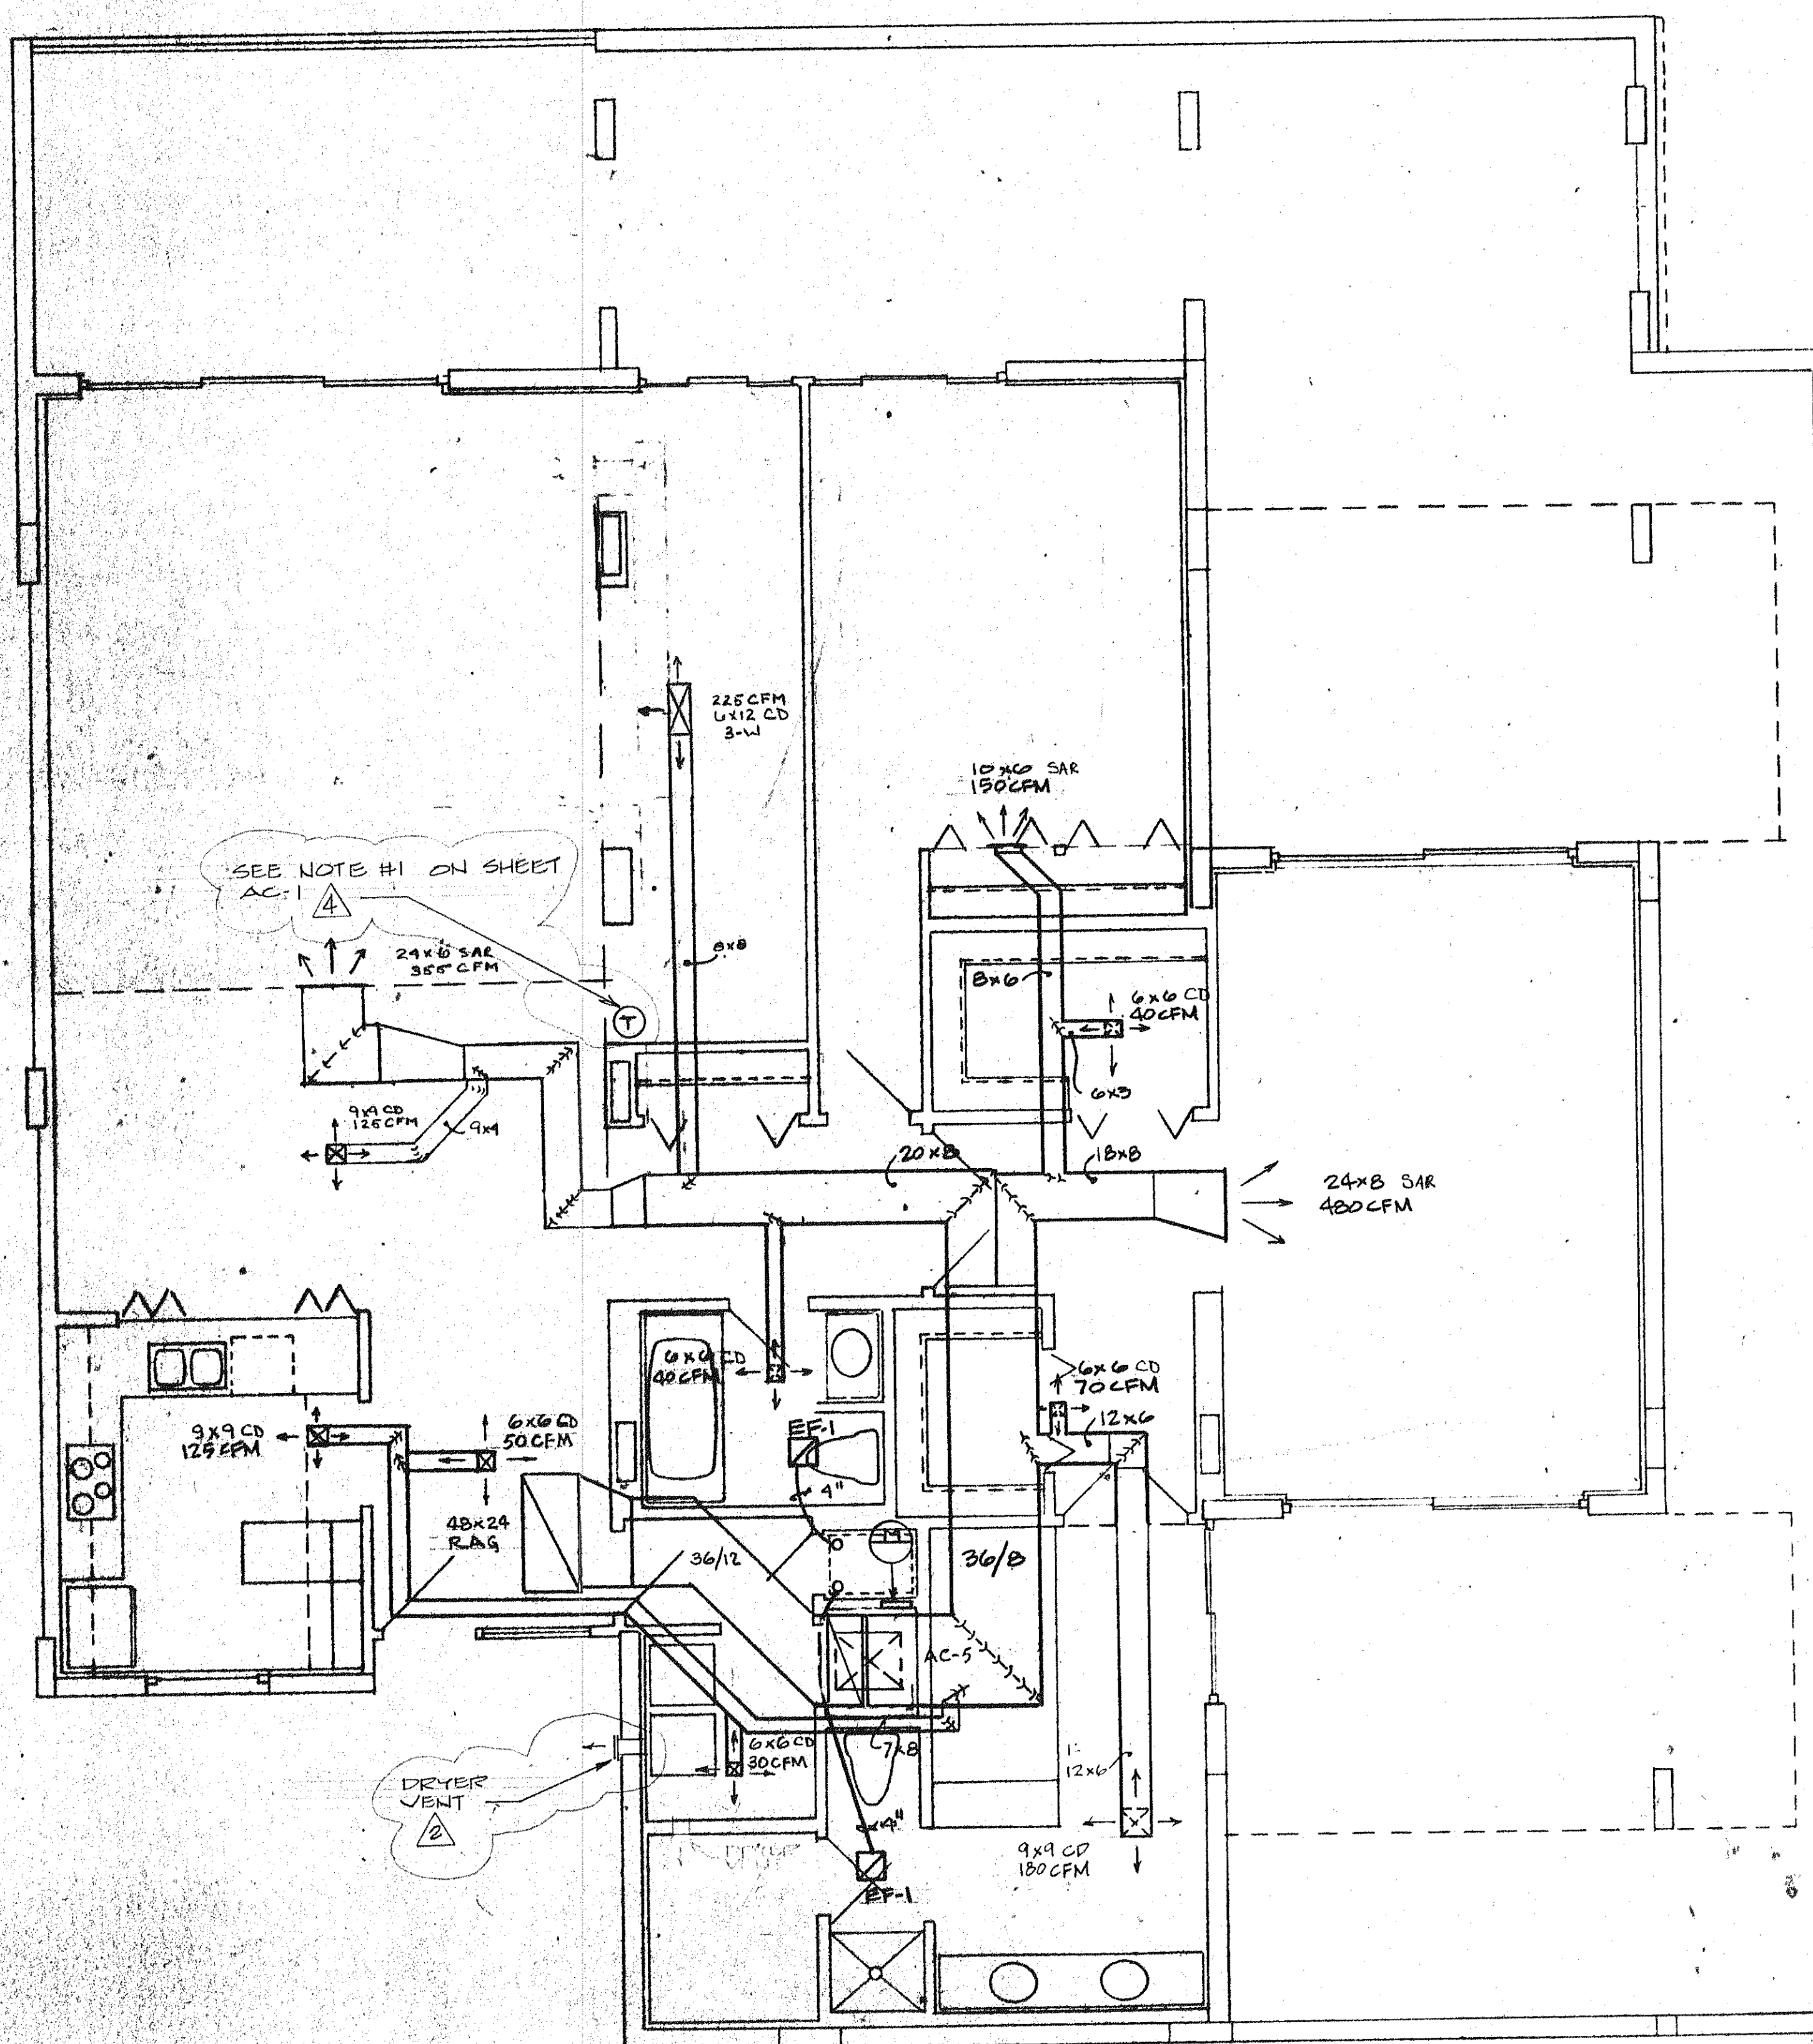

**UNIT D RIGHT - AIR CONDITIONING**

scale 1/4" = 1'-0"