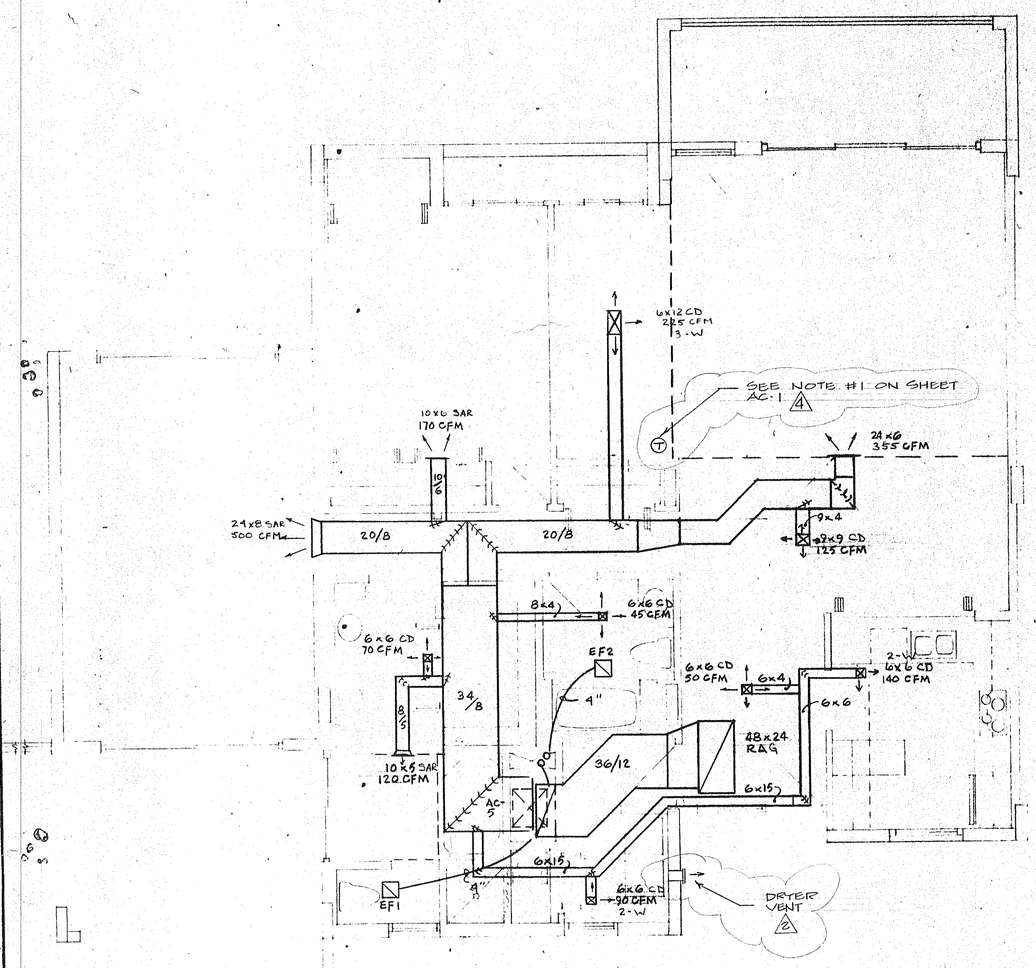

UNIT "D" non. LEFT AIR CONDITIONING

scale: 1/4" 1'-0"

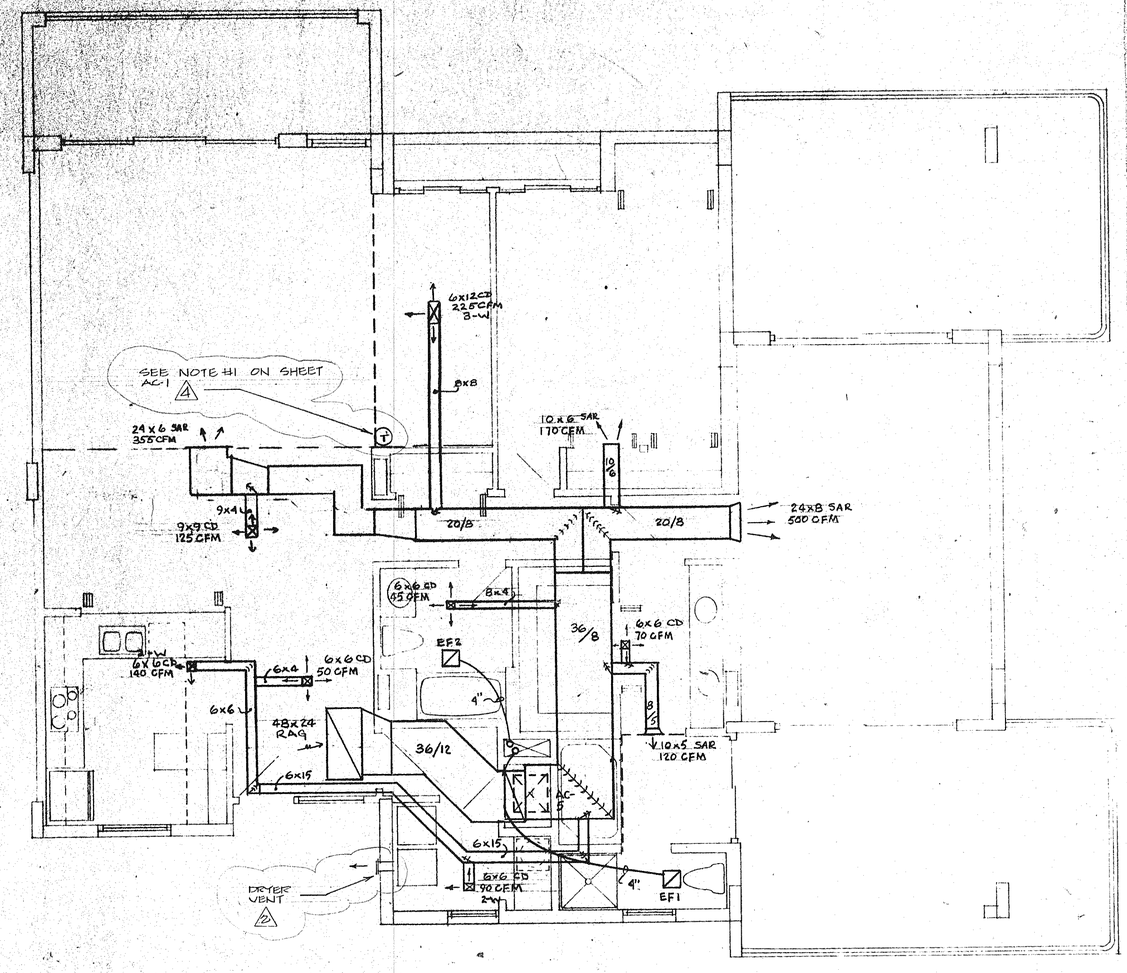

UNIT "D" non. RIGHT AIR CONDITIONING

scale: 1/4" 1'-0"

SUNSET BEACH
OF LONGBOAT KEY

ARVIDA CORPO
BRABHAM KUHT

T. EDWARD J. SEIBERT AIA ARCHITECT & PLANNER PA : THE SWA GROUP
CONSULTING ENGINEERS : OLSEN WHITE & ASSOCIATES STRUCTURAL ENGINEERS : BENNETT & BISHOP INC CONSULTING ENGINEERS & SURVEYORS

ISSUED
4-1-82

REVISED
DRYER VENT
7-20-83
AS-BUILT
OCT 1 1983

SHEET
AC-8
BLDG. 3
OF