


UNIT 'A' LEFT AIR CONDITIONING

Scale 1/4" = 1'-0"

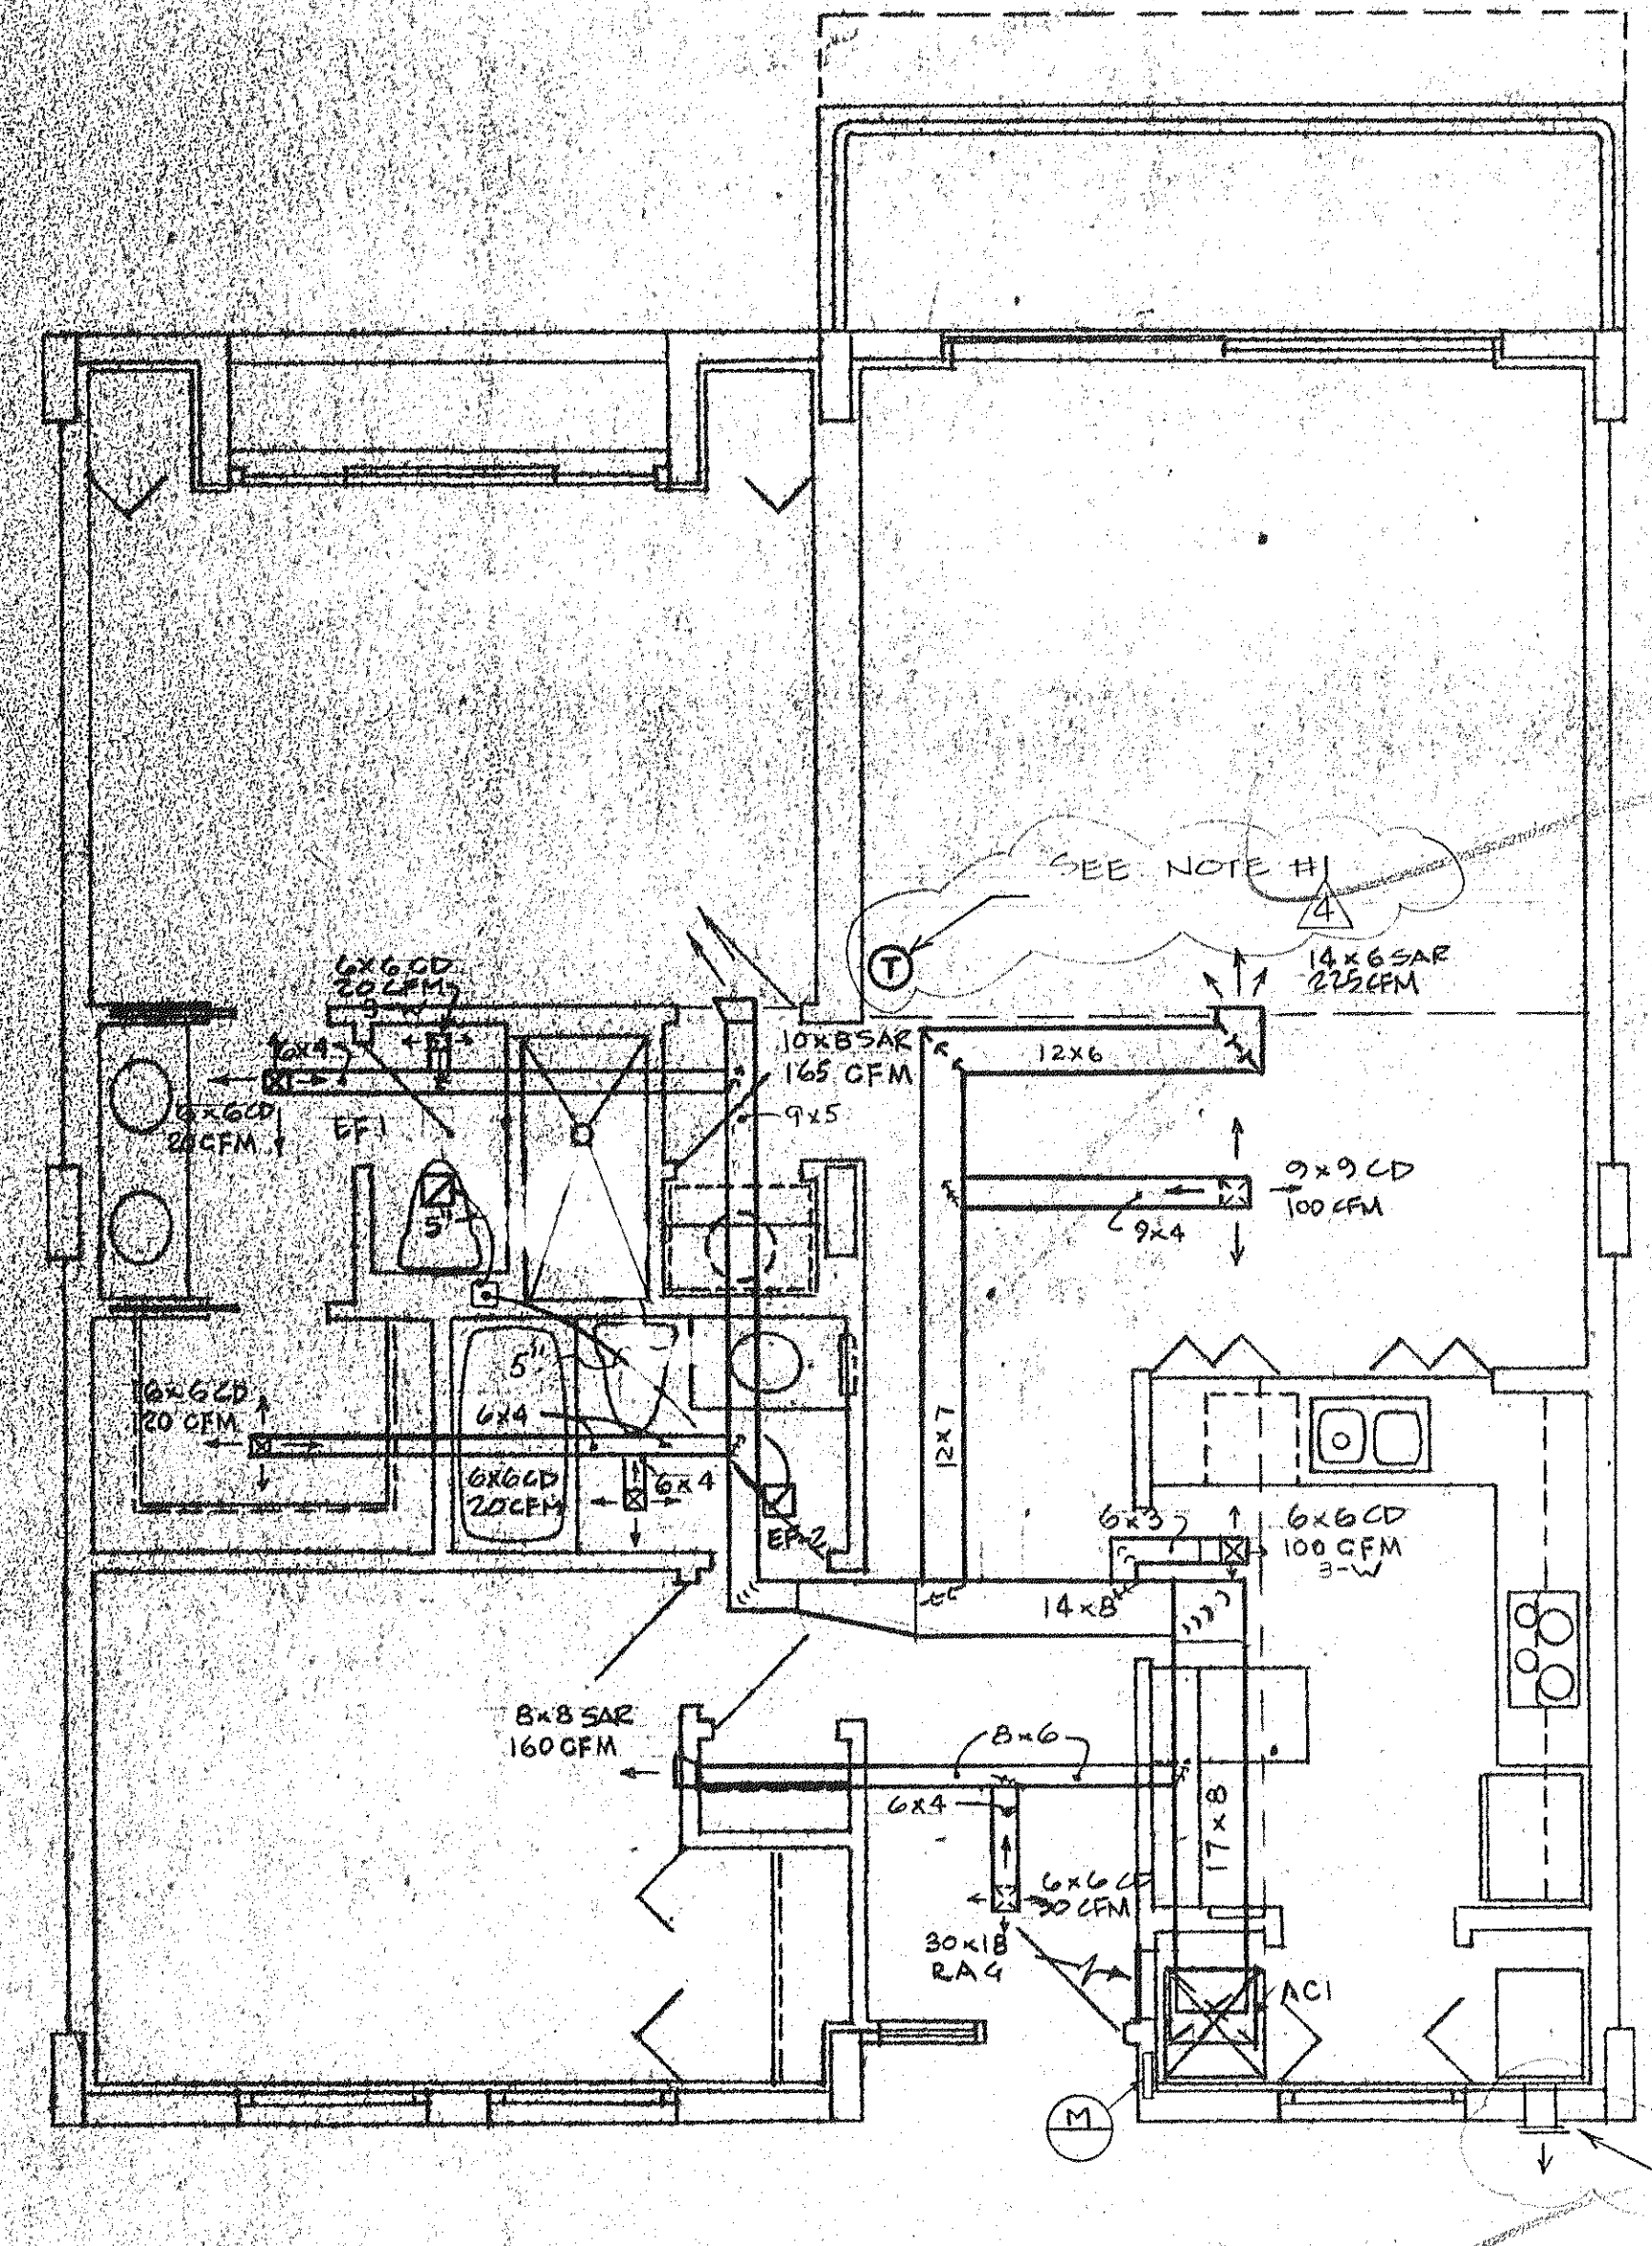

UNIT 'A' RIGHT AIR CONDITIONING

NOTE #1: ALL THERMOSTATS ARE TO BE MOUNTED 48" ABOVE FIN FLOOR

ARVEX CORPORATION, EDWARD J. SEIBERT, AIA, ARCHITECT & PLANNER, P.A., THE SWA GROUP
 BRADY W. KILPATRICK, DEBBY CONSULTING ENGINEERS, OLSEN WHITE & ASSOCIATES, STRUCTURAL ENGINEERS

ISSUED	4-10-83
REVISED	7-20-83
BY	EDS
DATE	7-20-83
BY	EDS
DATE	7-20-83