


UNIT "C" LEFT AIR CONDITIONING

SCALE: 1/4" = 1'-0"

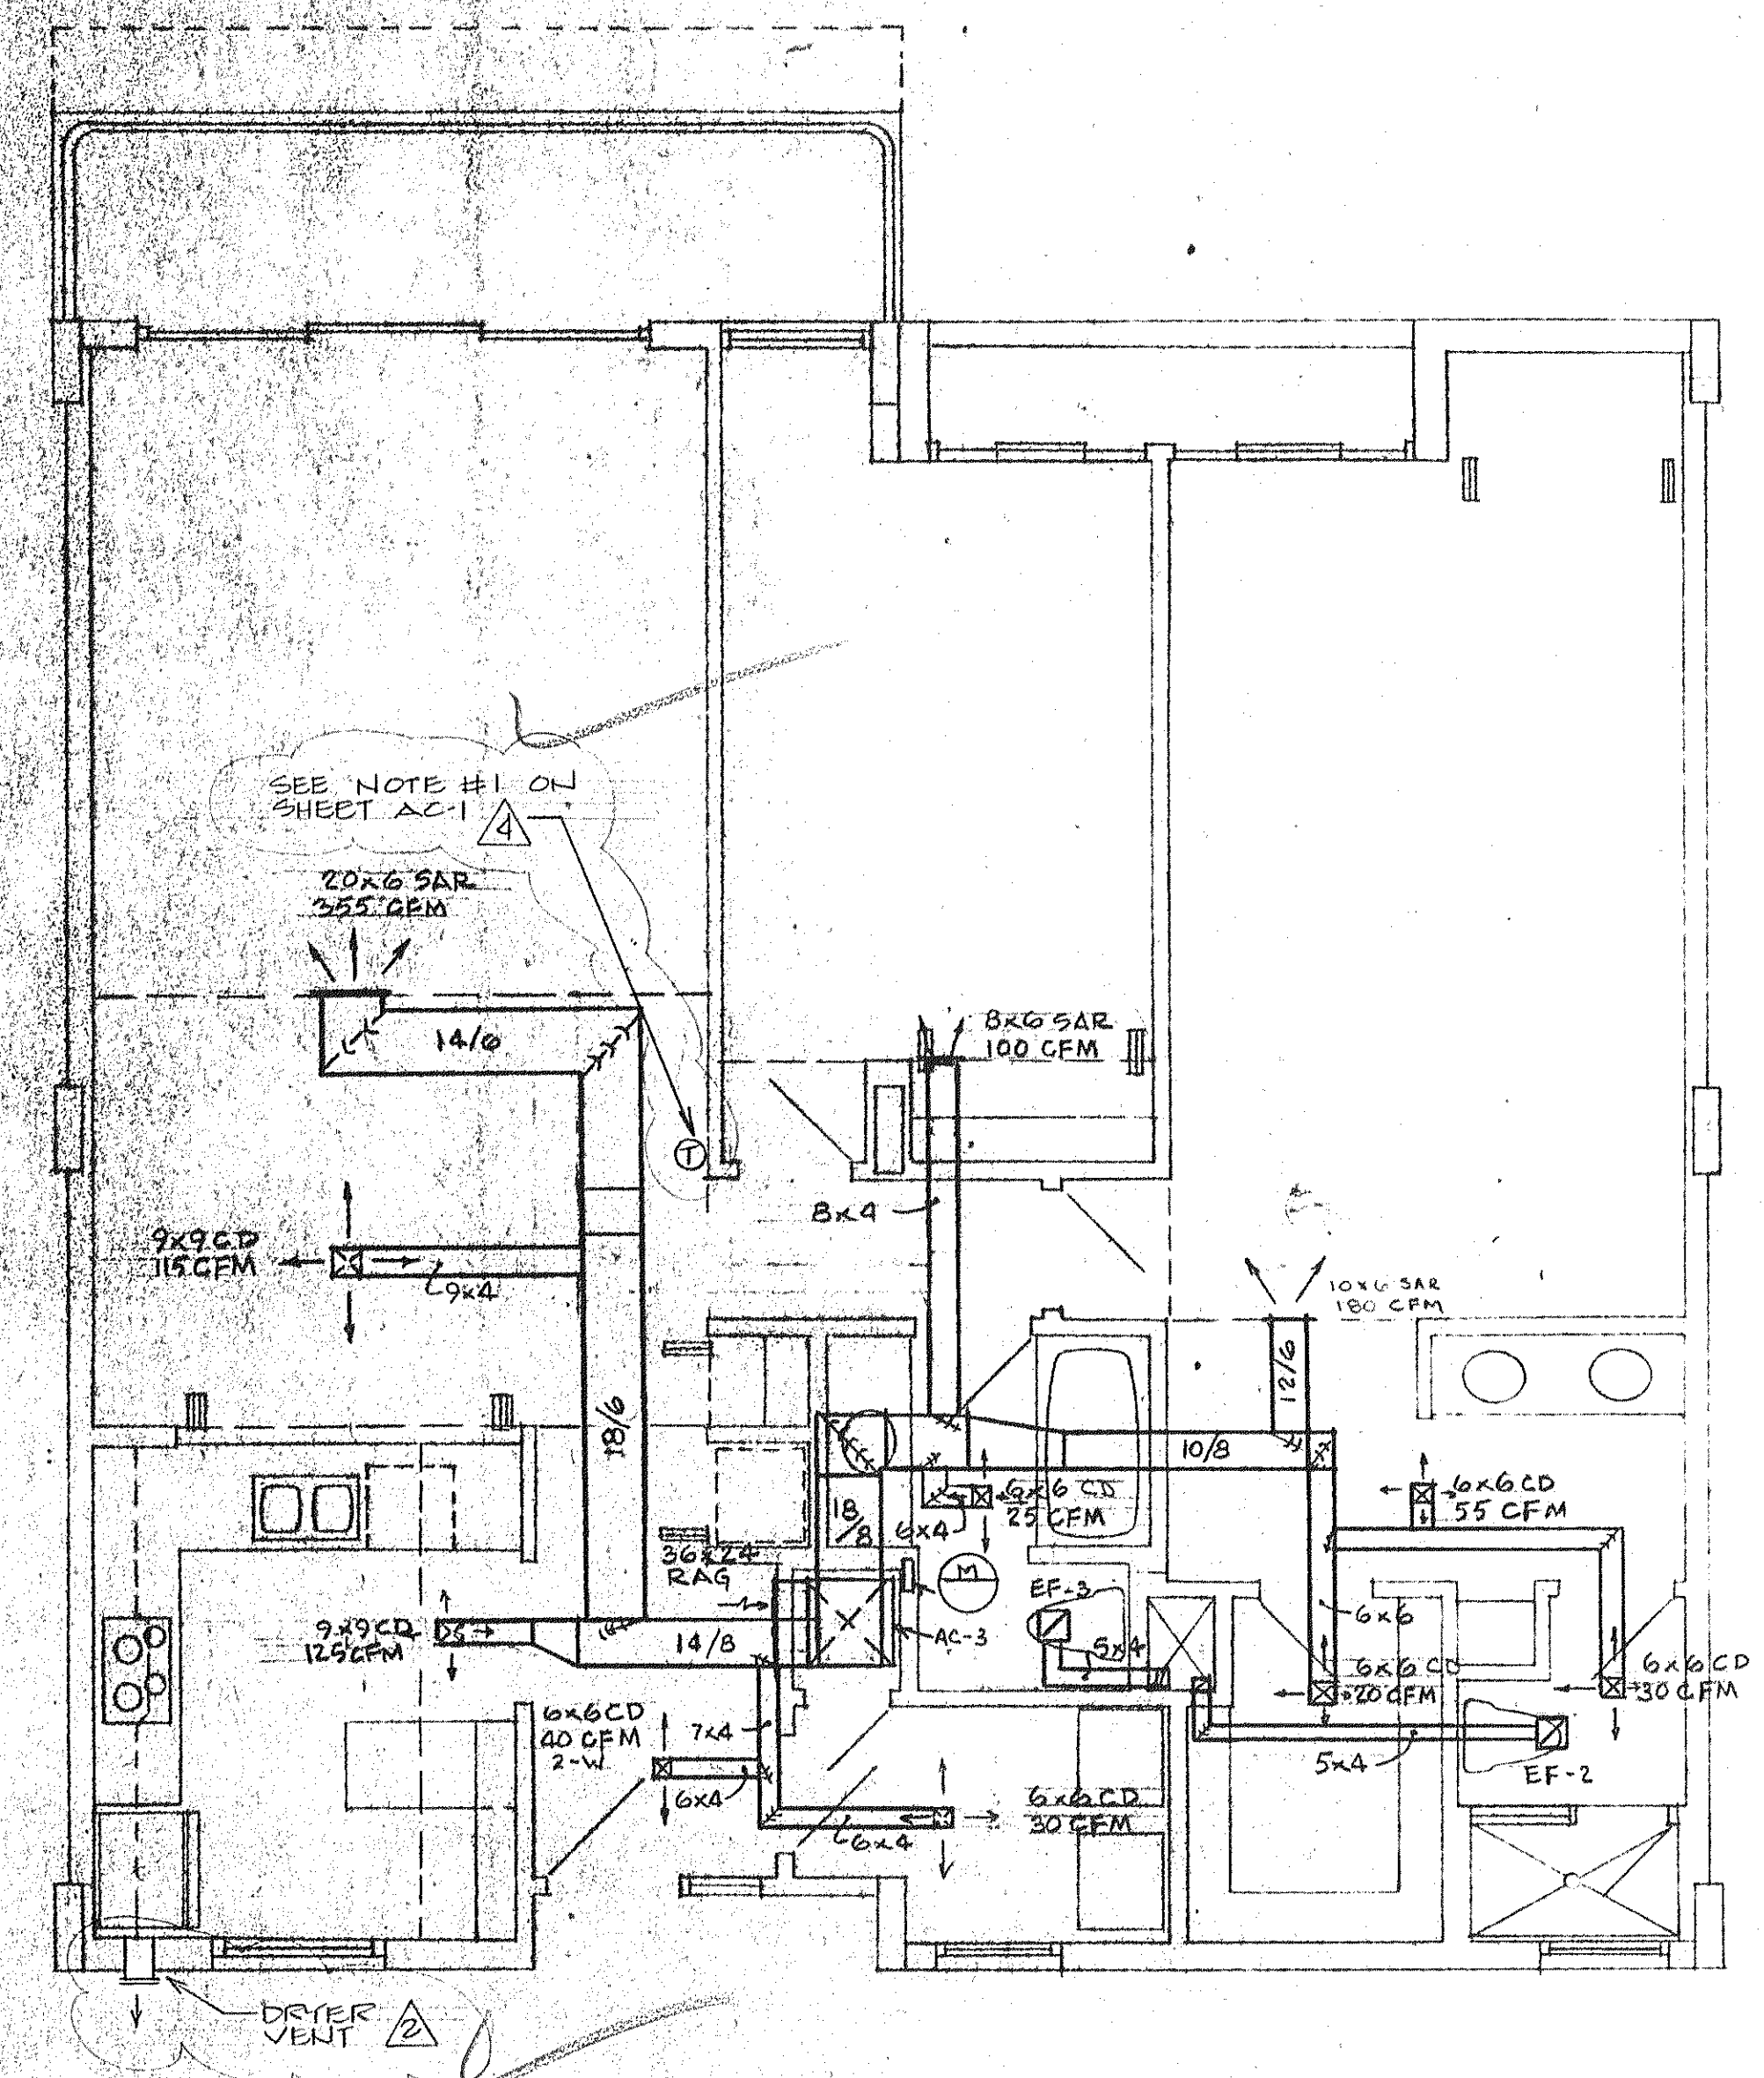

UNIT "C" RIGHT AIR CONDITIONING

SCALE: 1/4" = 1'-0"

ISSUED	4/1/73
REVISED	7/23/73
BY	WJ
DATE	7/23/73
BY	WJ
DATE	7/23/73
BY	WJ
DATE	7/23/73
SHEET	
AC-3	
BLDG. 3	
OF	