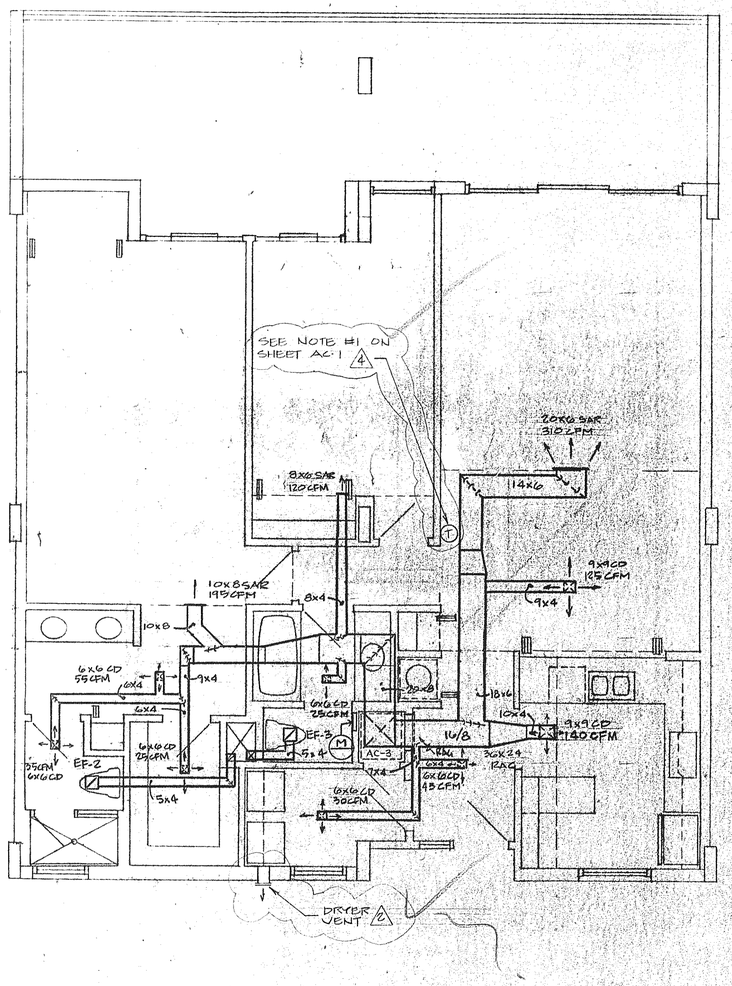

UNIT "C" • LEFT- AIR CONDITIONING

scale: 1/4" = 1'-0"

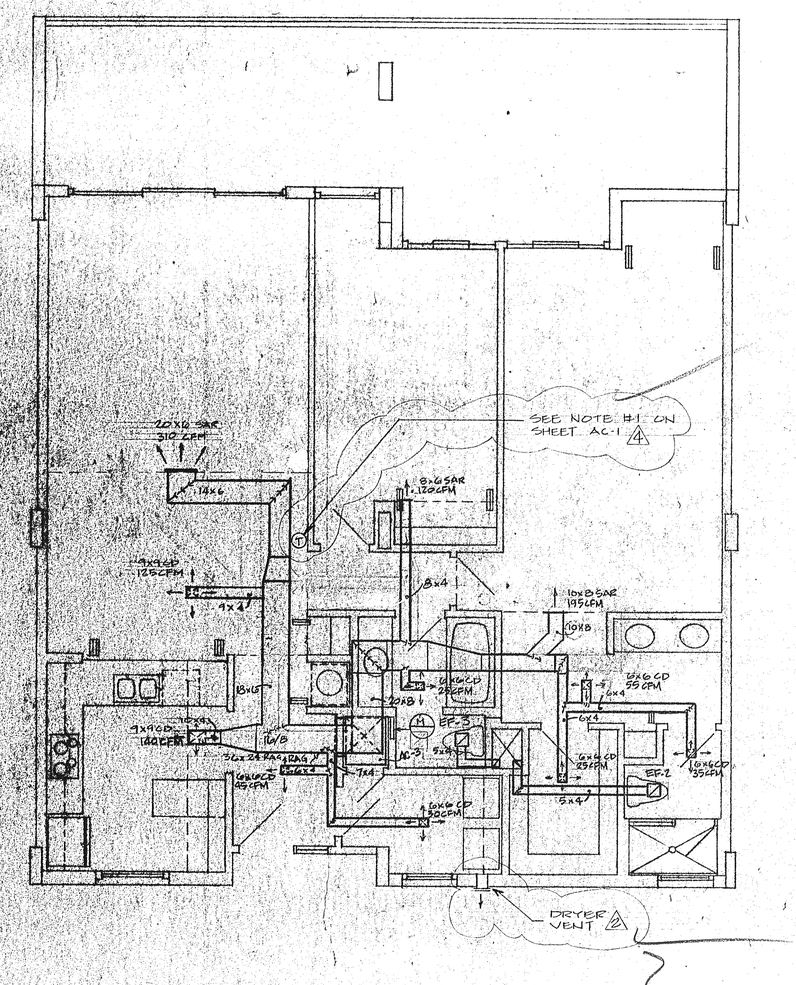

UNIT "C" • RIGHT- AIR CONDITIONING

scale: 1/4" = 1'-0"

SUNSET BEACH OF LONG BOAT KEY

ARVIDA CORPORATION · EDWARD J. SEIBERT AIA ARCHITECT & PLANNER PA · THE SWA GROUP
BRABHAM KUHNS DEBAY CONSULTING ENGINEERS · OLSEN WHITE & ASSOCIATES STRUCTURAL ENGINEERS · BENNETT & BISHOP, INC CONSULTING ENGINEERS & SURVEYORS

ISSUED

REVISED
2 DRYER VENT 7-20-83
4 ACCESSIBILITY RZTS 7-16-89

SHEET

AC-4

BLDG. 3

OF