


**UNIT "C" MOD LEFT - AIR CONDITIONING**

scale 1/4" : 1'-0"

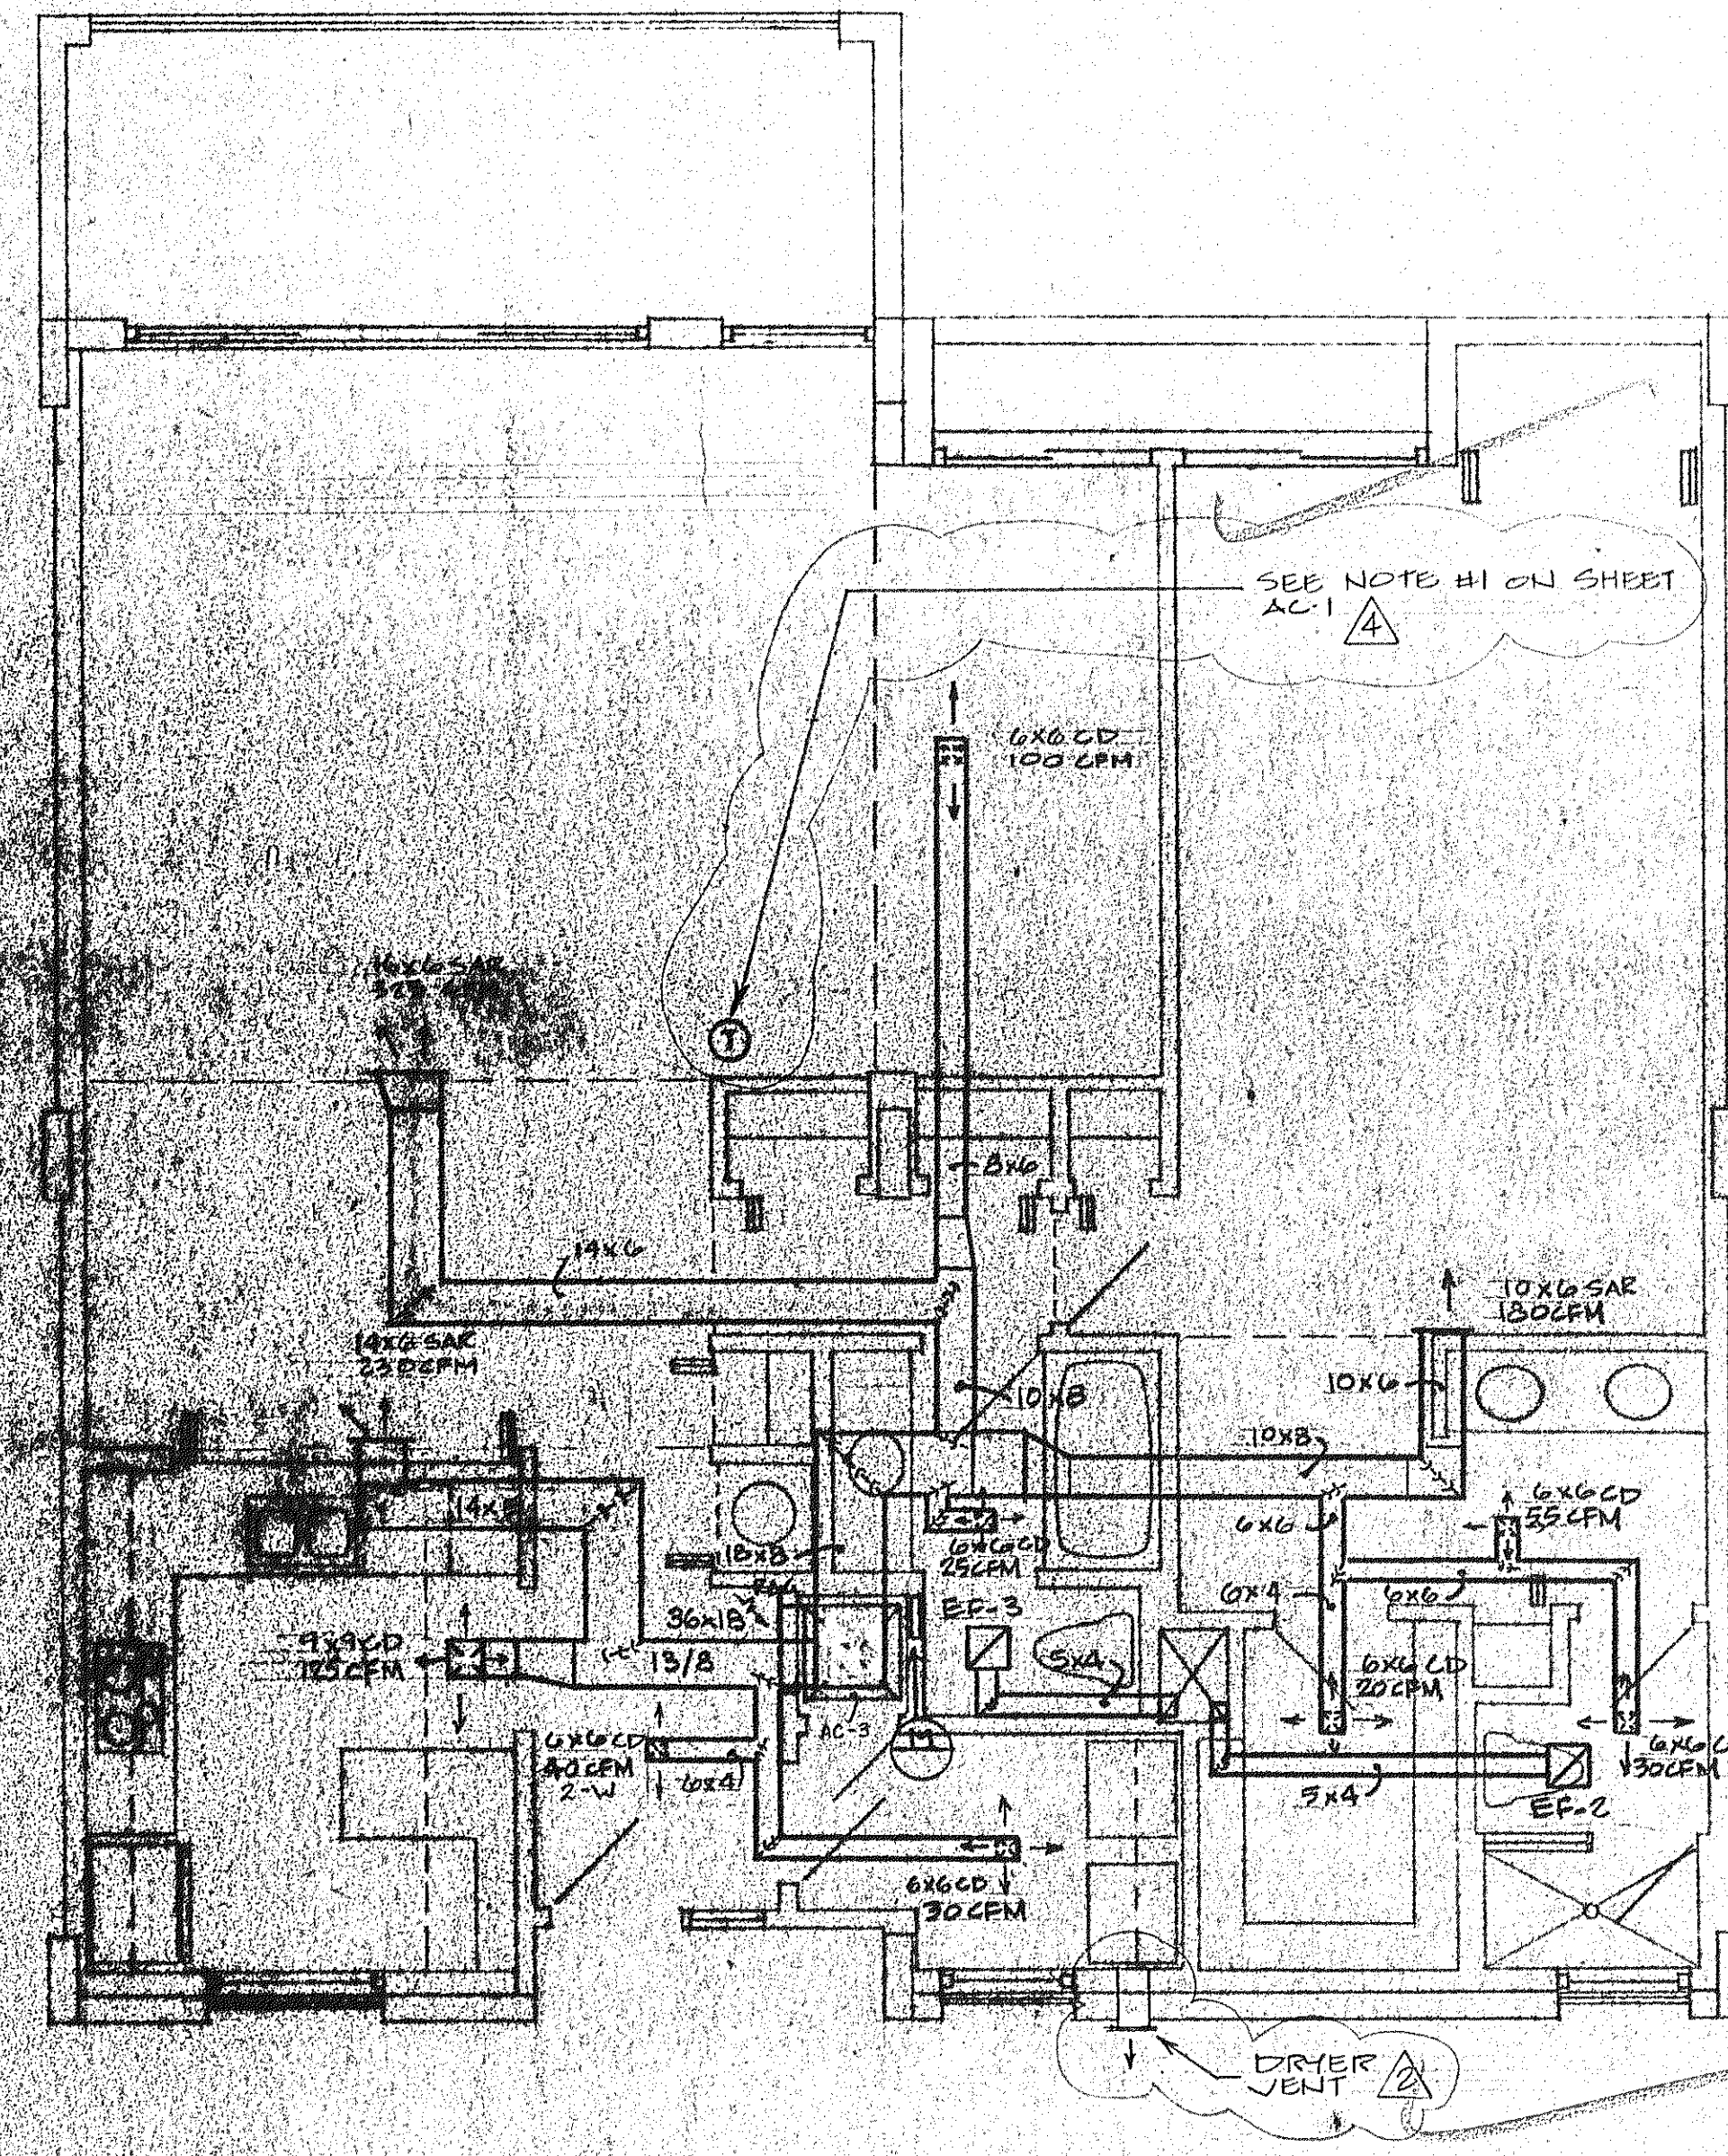

**UNIT "C" MOD RIGHT - AIR CONDITIONING**

scale 1/4" : 1'-0"

ISSUED	
REVISED	
ADDED	
DELETED	
CHANGED	
OTHER	
SHEET	
<b>AC-5</b>	
BLDG. 3	
OF	