


UNIT 'D' LEFT - AIR CONDITIONING
 00000 1/4" = 1'-0"

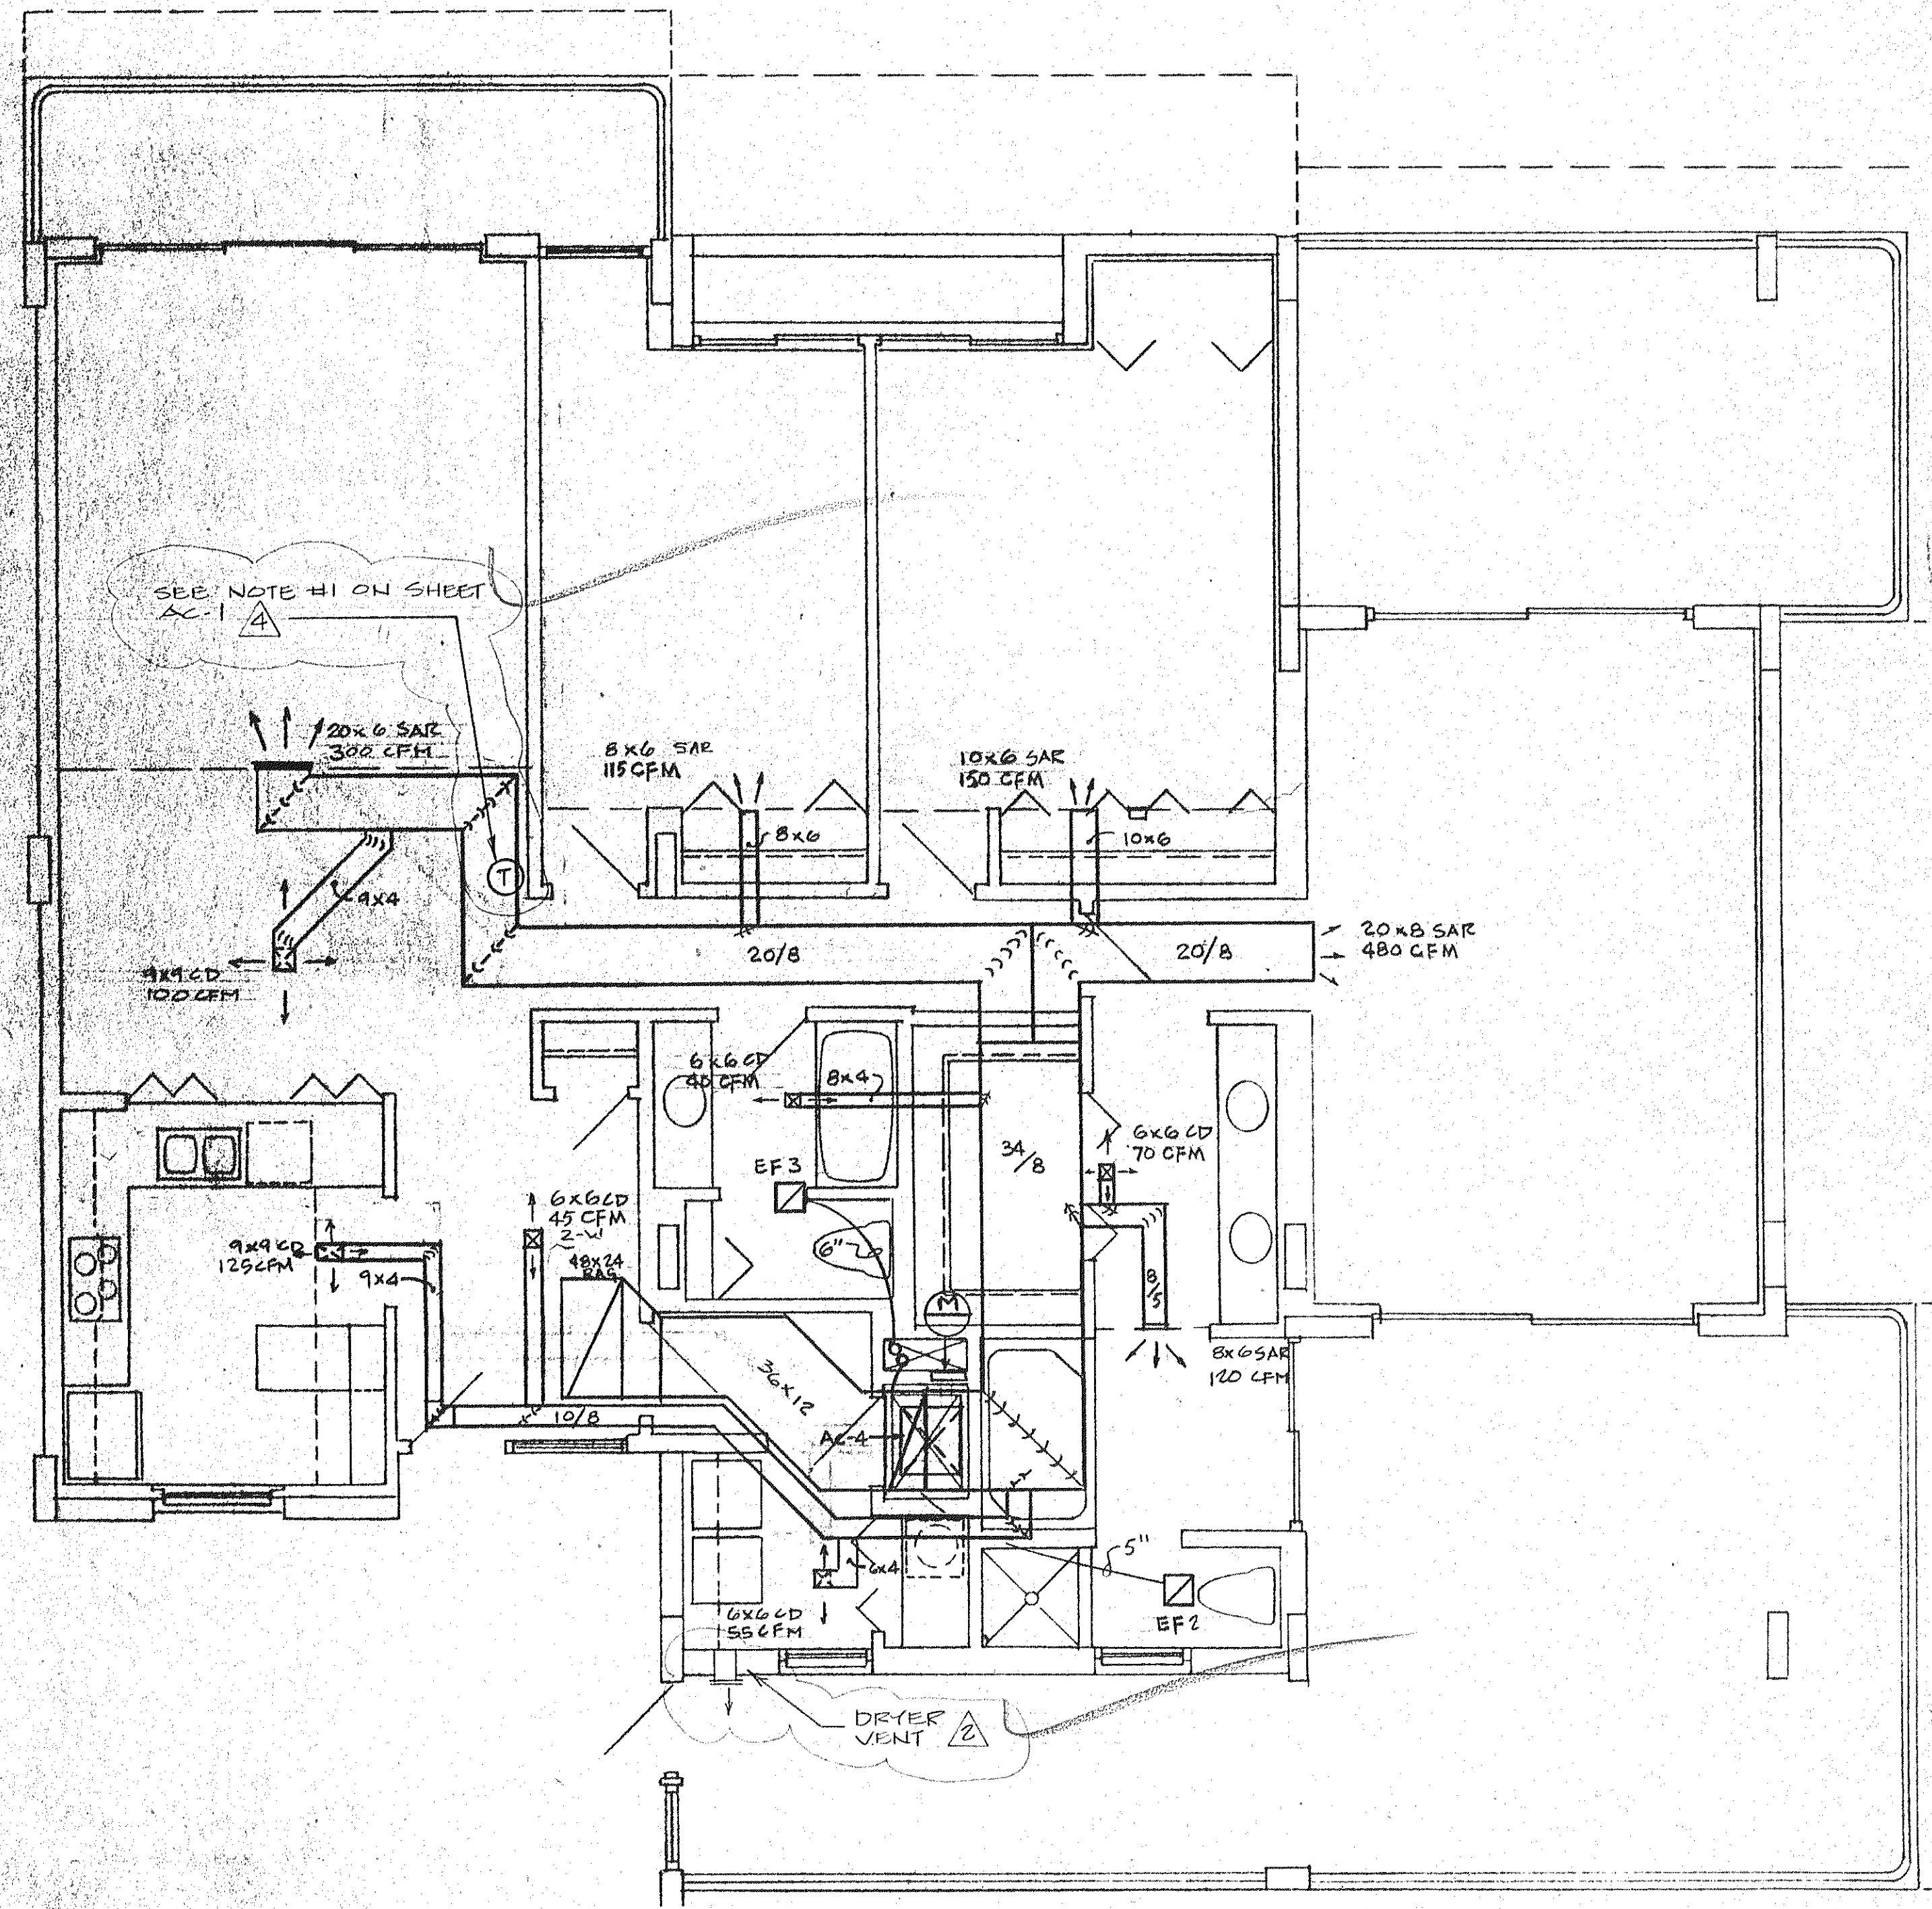

UNIT 'D' RIGHT - AIR CONDITIONING
 00000 1/4" = 1'-0"

SUNSET BEACH
 OFFICE BOAT KEY
 ARVADA CORPORATION, EDWARD J. SEBERT, AIA ARCHITECT & PLANNER, P.A., THE BWA GROUP
 EPY-SAM, KUMS, DEBBY CONSULTING ENGINEERS, OLSEN, WHITE & ASSOCIATES, STRUCTURAL ENGINEERS, BENNETT & BISHOP, INC. CONSULTING ENGINEERS & SURVEYORS

| | |
|---------|---------|
| ISSUED | 3-1-02 |
| REVISED | 6-25-02 |
| | 7-20-03 |
| | 8-15-03 |
| | 1-15-04 |

SHEET
AC-6
 BLDG. 3
 OF 3