


**UNIT "D" - LEFT - AIR CONDITIONING**

scale 1/4" = 1'-0"

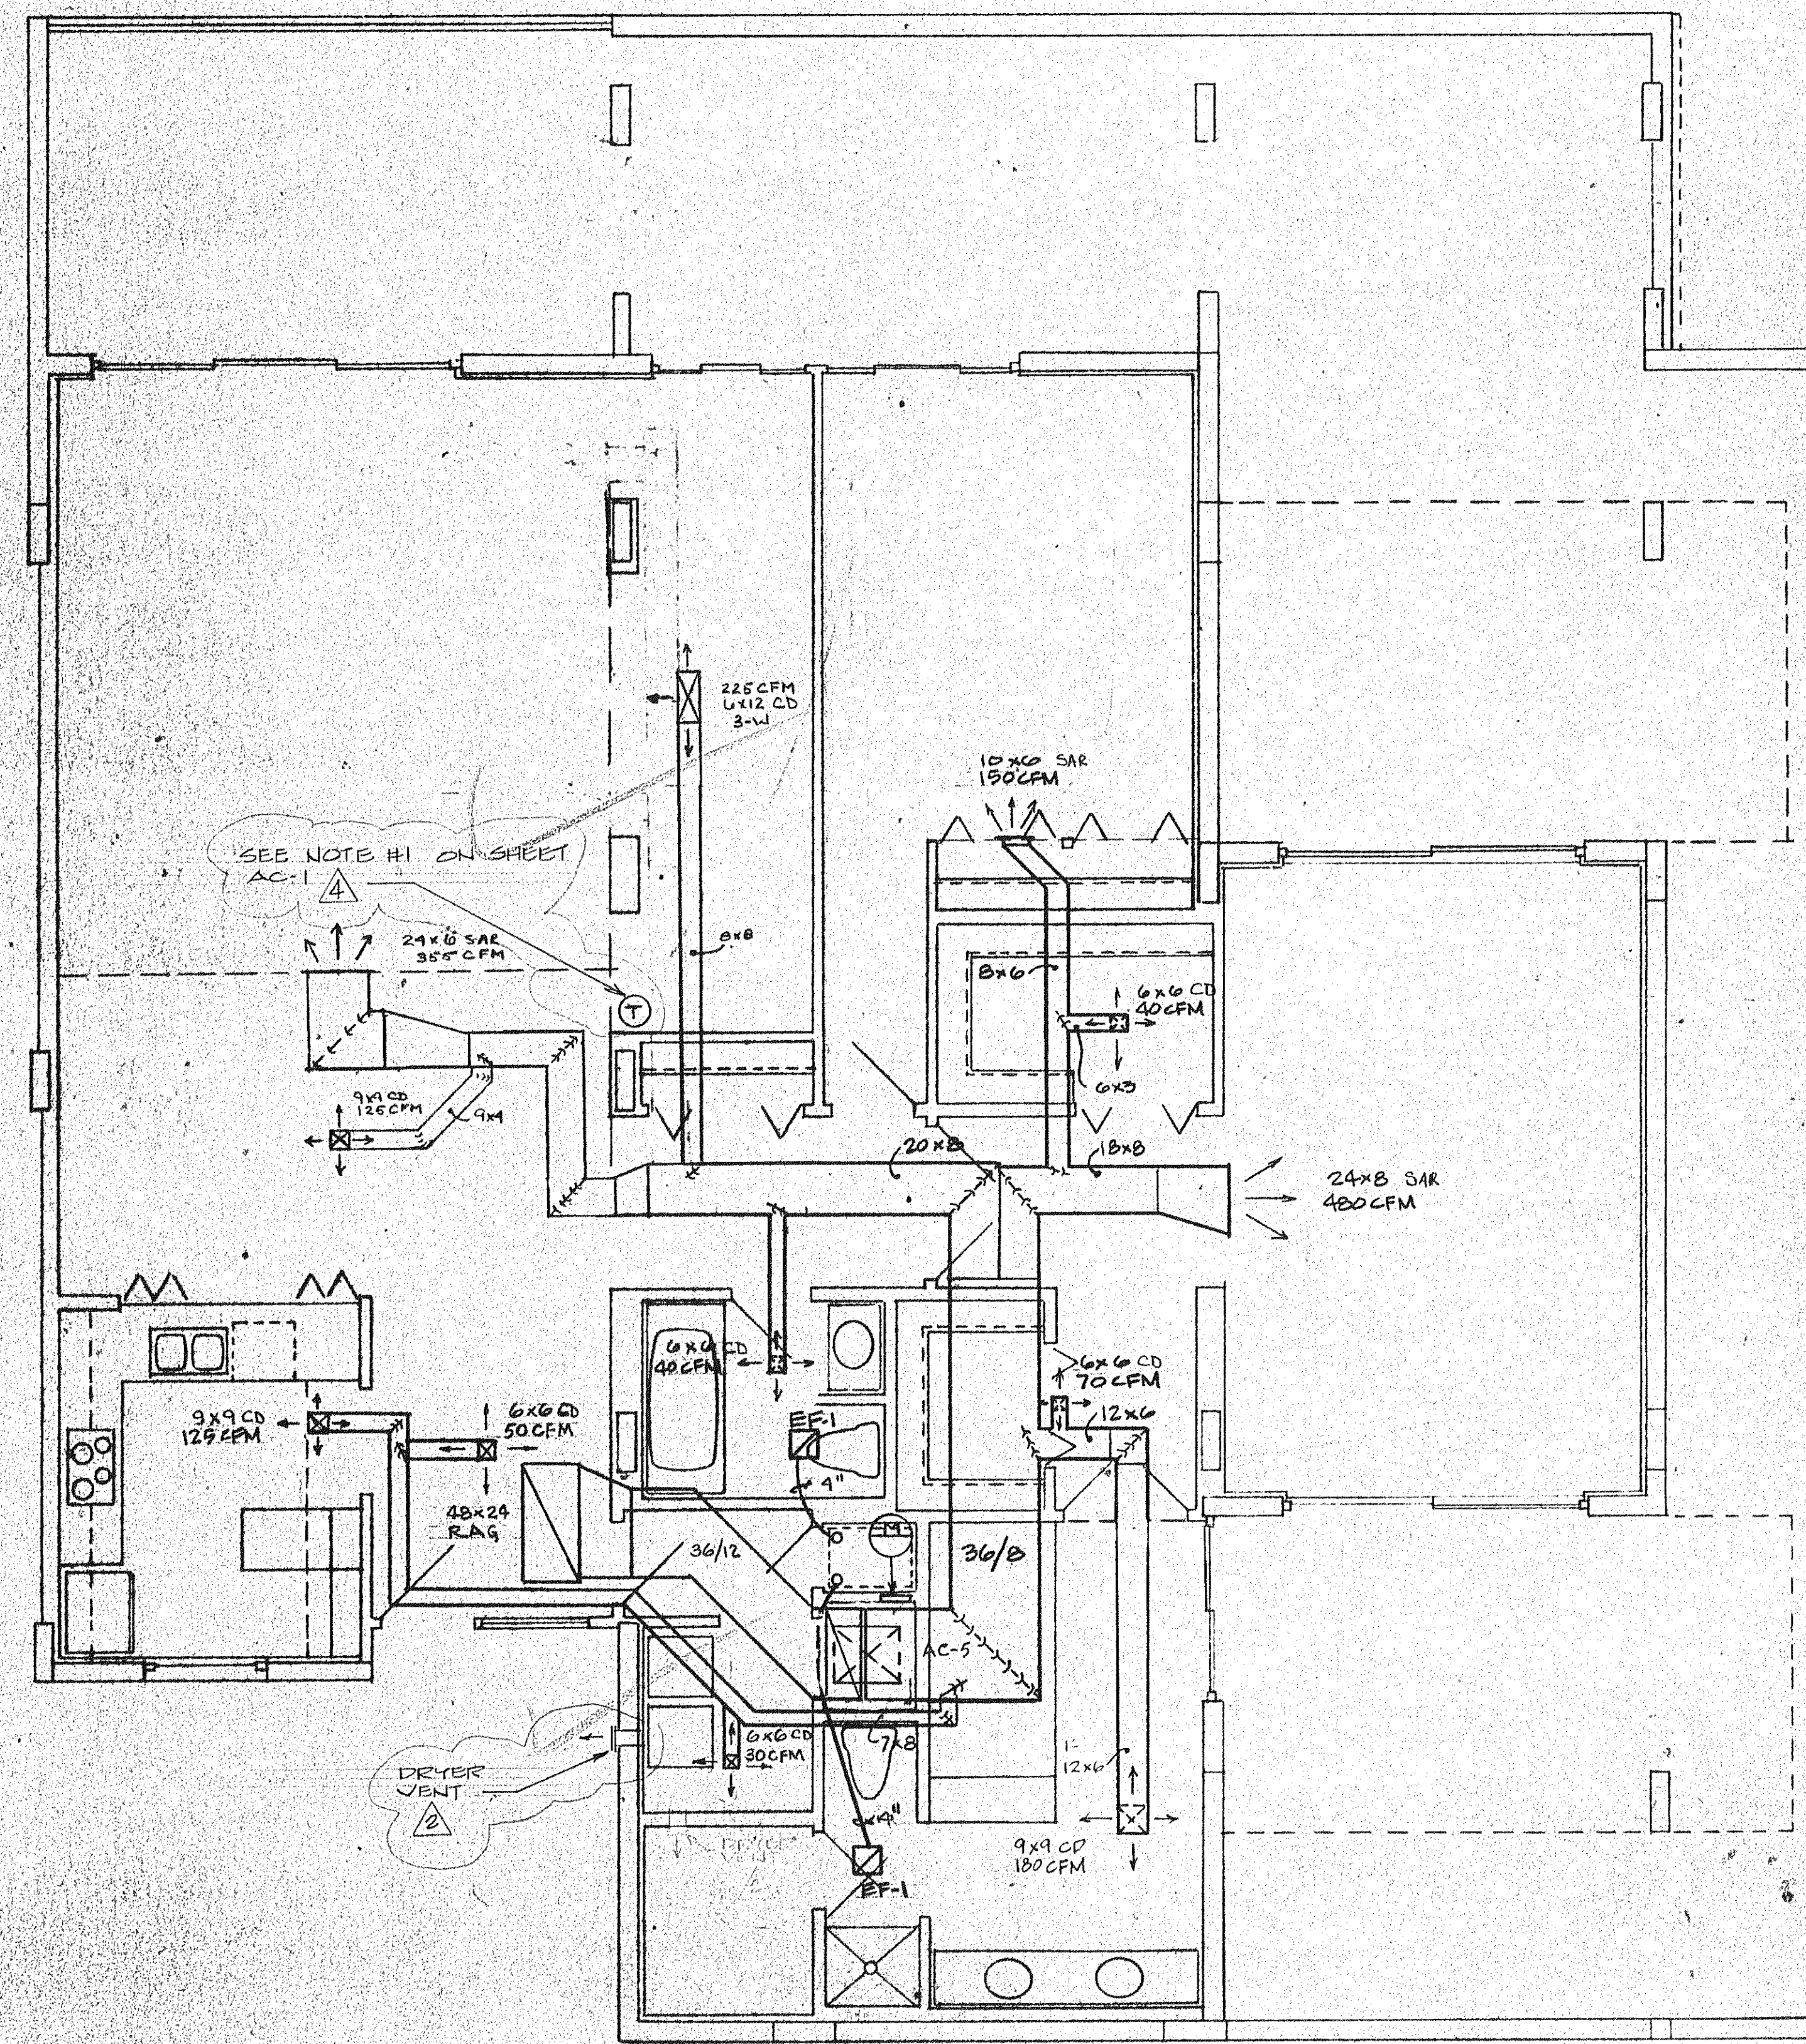

**UNIT D: RIGHT - AIR CONDITIONING**

scale 1/4" = 1'-0"

ISSUED	4-1-82
REVISED	2-15-83
REVISION	1-20-83
RESPONSIBILITY	RETS-115 83
SHEET	AC-7
BLDG.	3