


UNIT 'D' MOD. LEFT AIR CONDITIONING

SCALE: 1/4" = 1'-0"

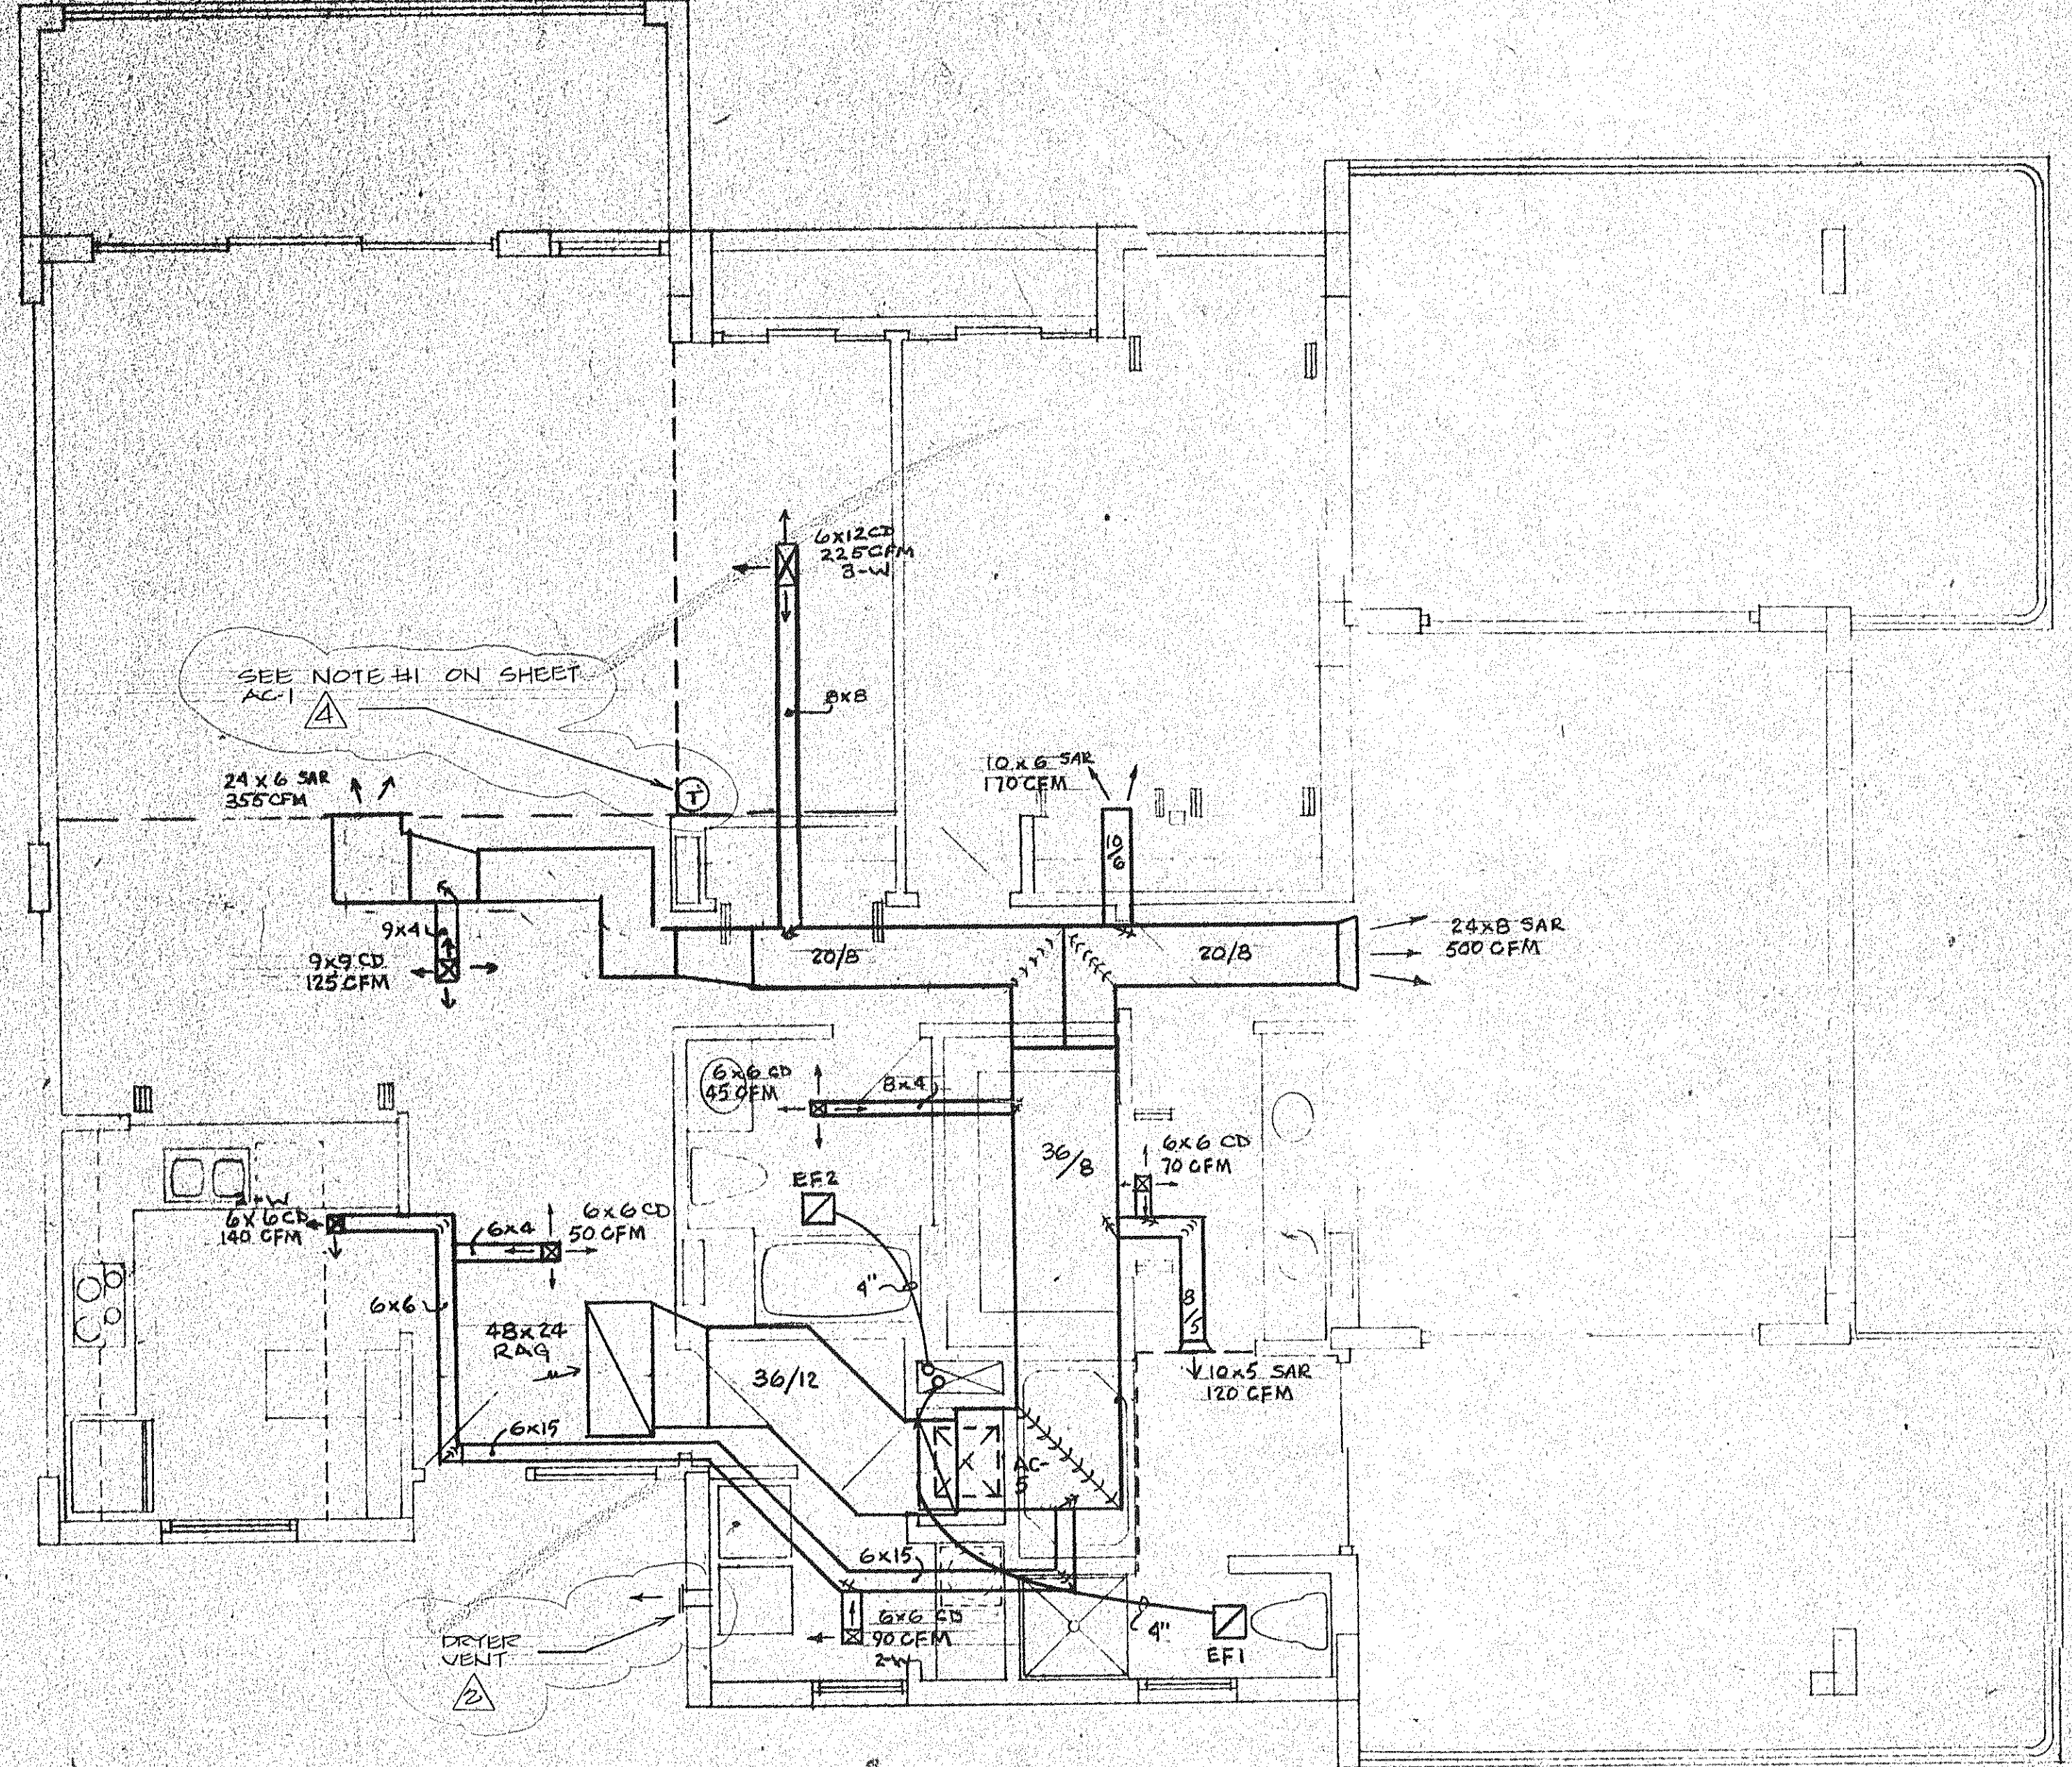

UNIT 'D' MOD. RIGHT AIR CONDITIONING

SCALE: 1/4" = 1'-0"

ISSUED	4-1-22
REVISED	DRYER VENT
7-20-22	
ACCURACY	
DATE	7-15-22
SHEET	
AC-1	
BLDG.	2