



LOCATION MAP

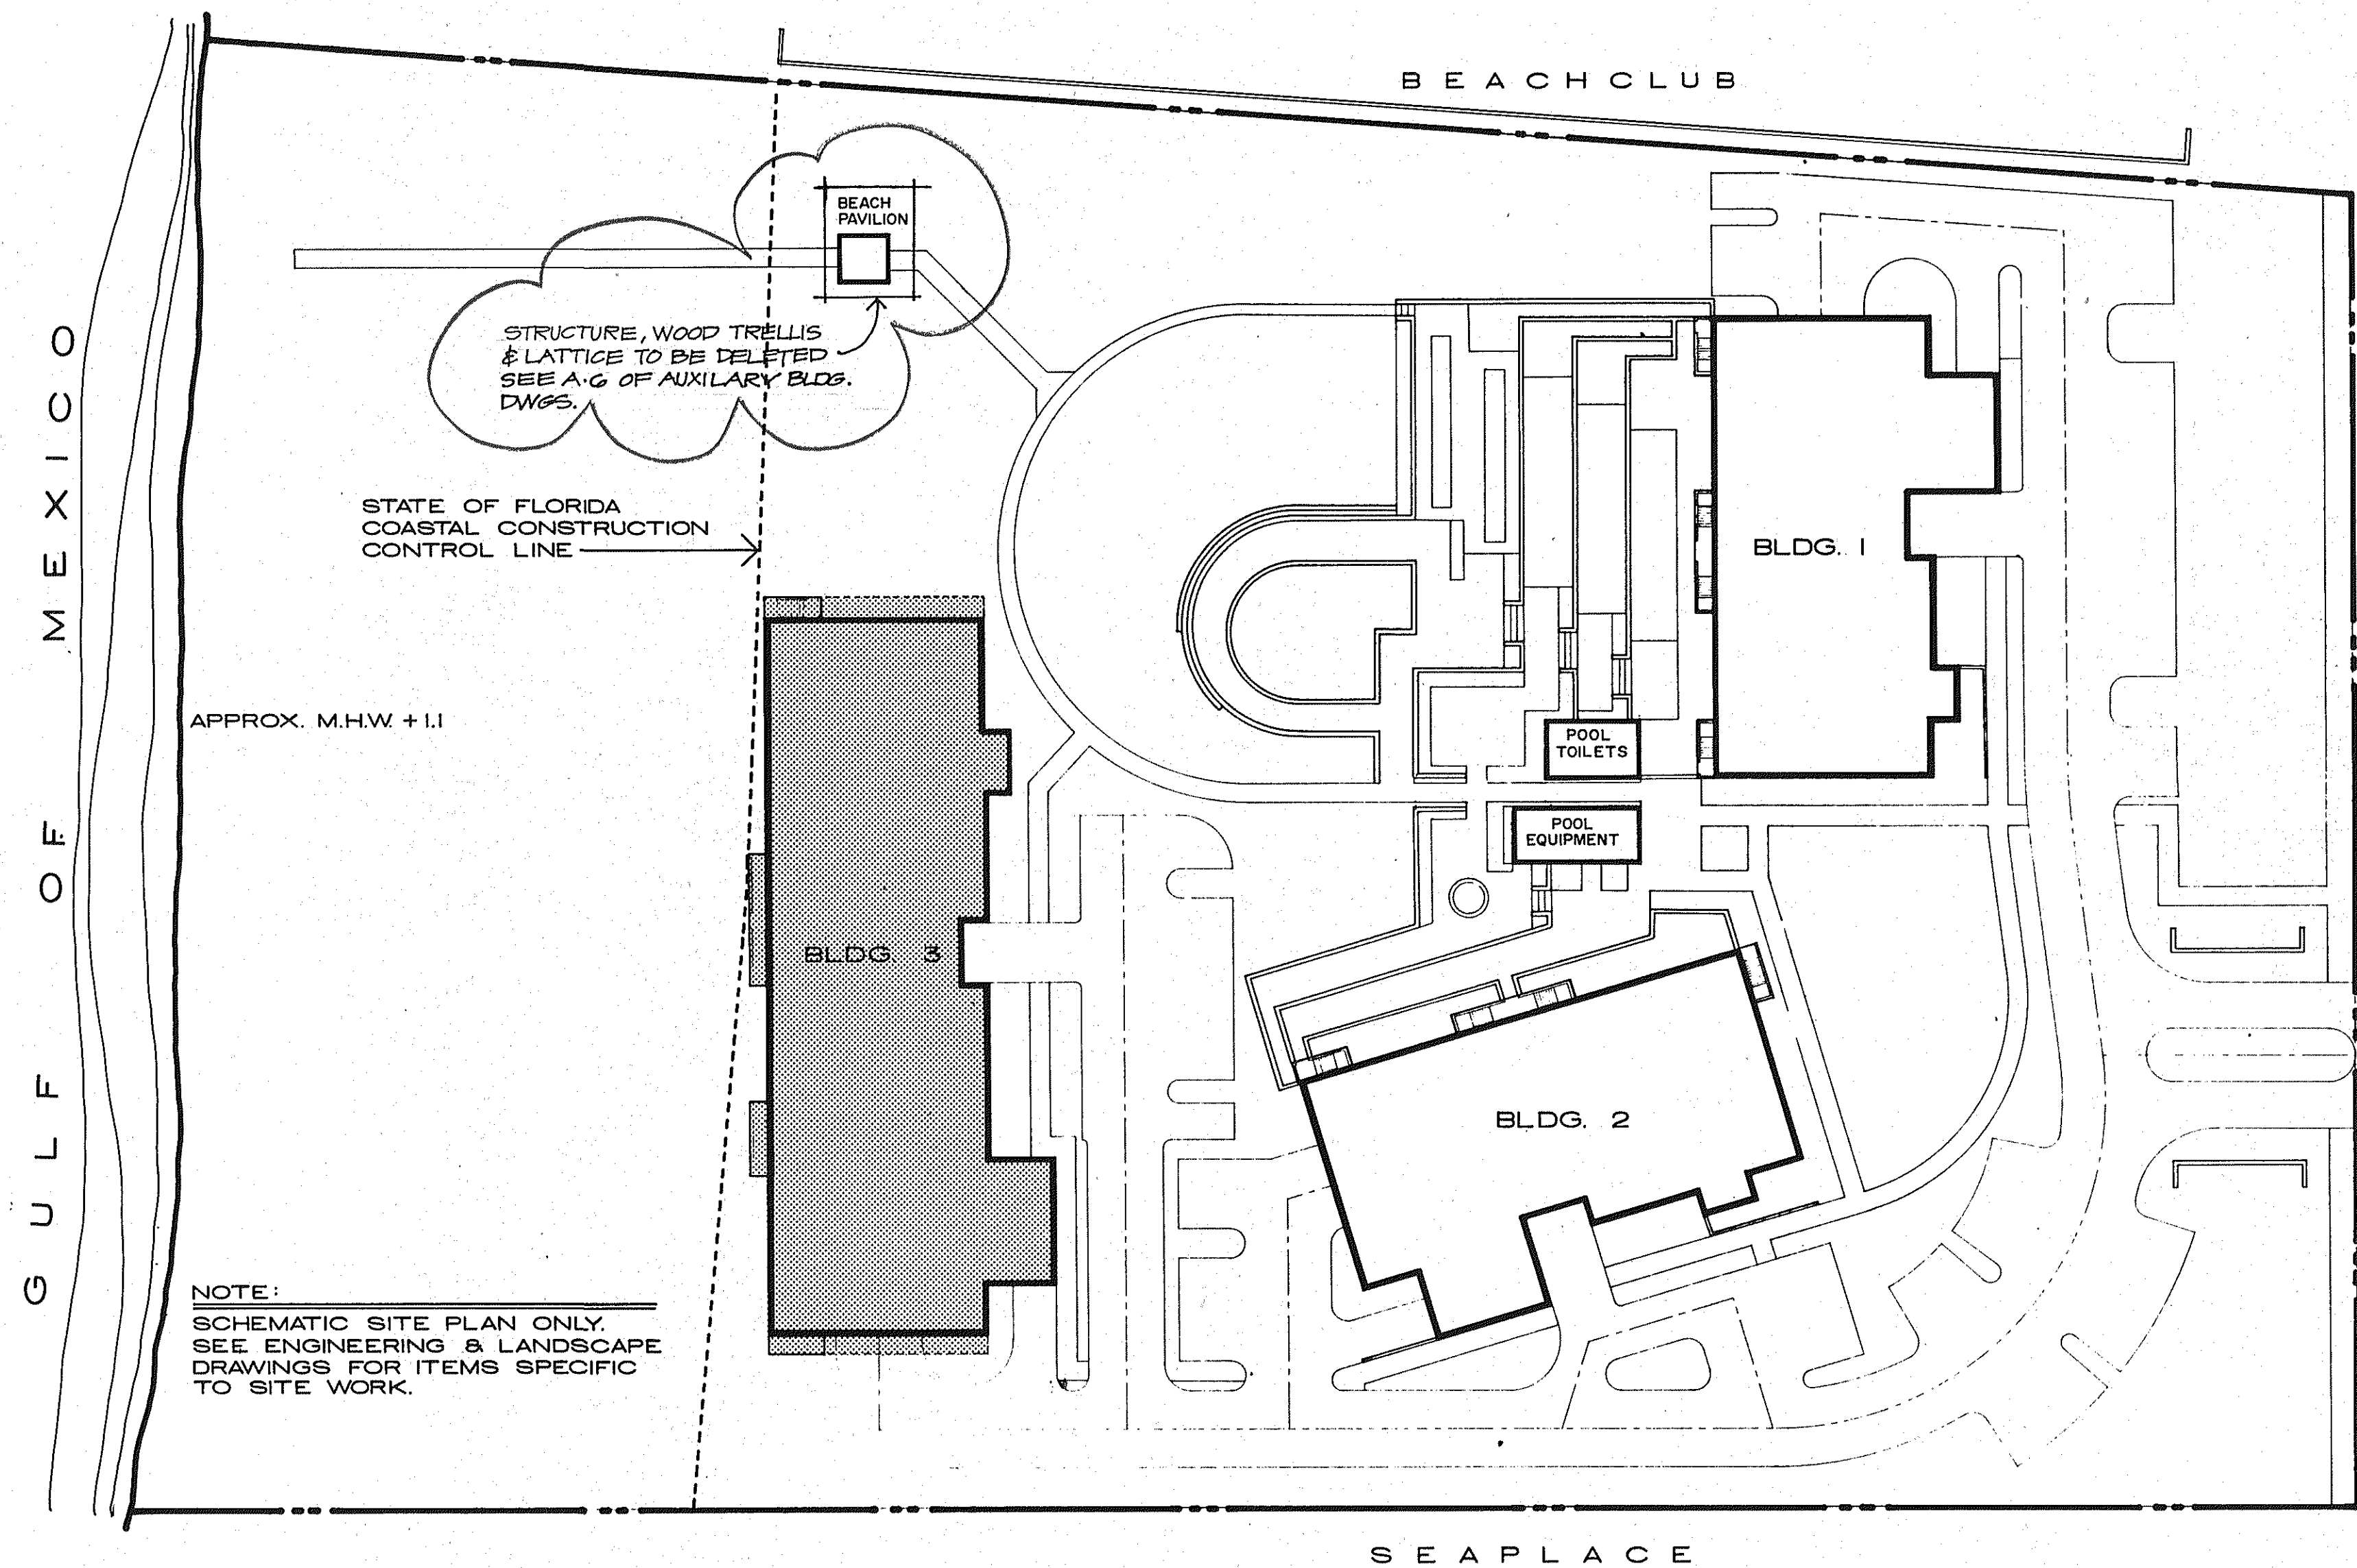

SITE PLAN

1" = 40'

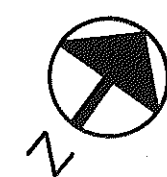