


OVERLAYS  
 1 1  
 2 2  
 3 3

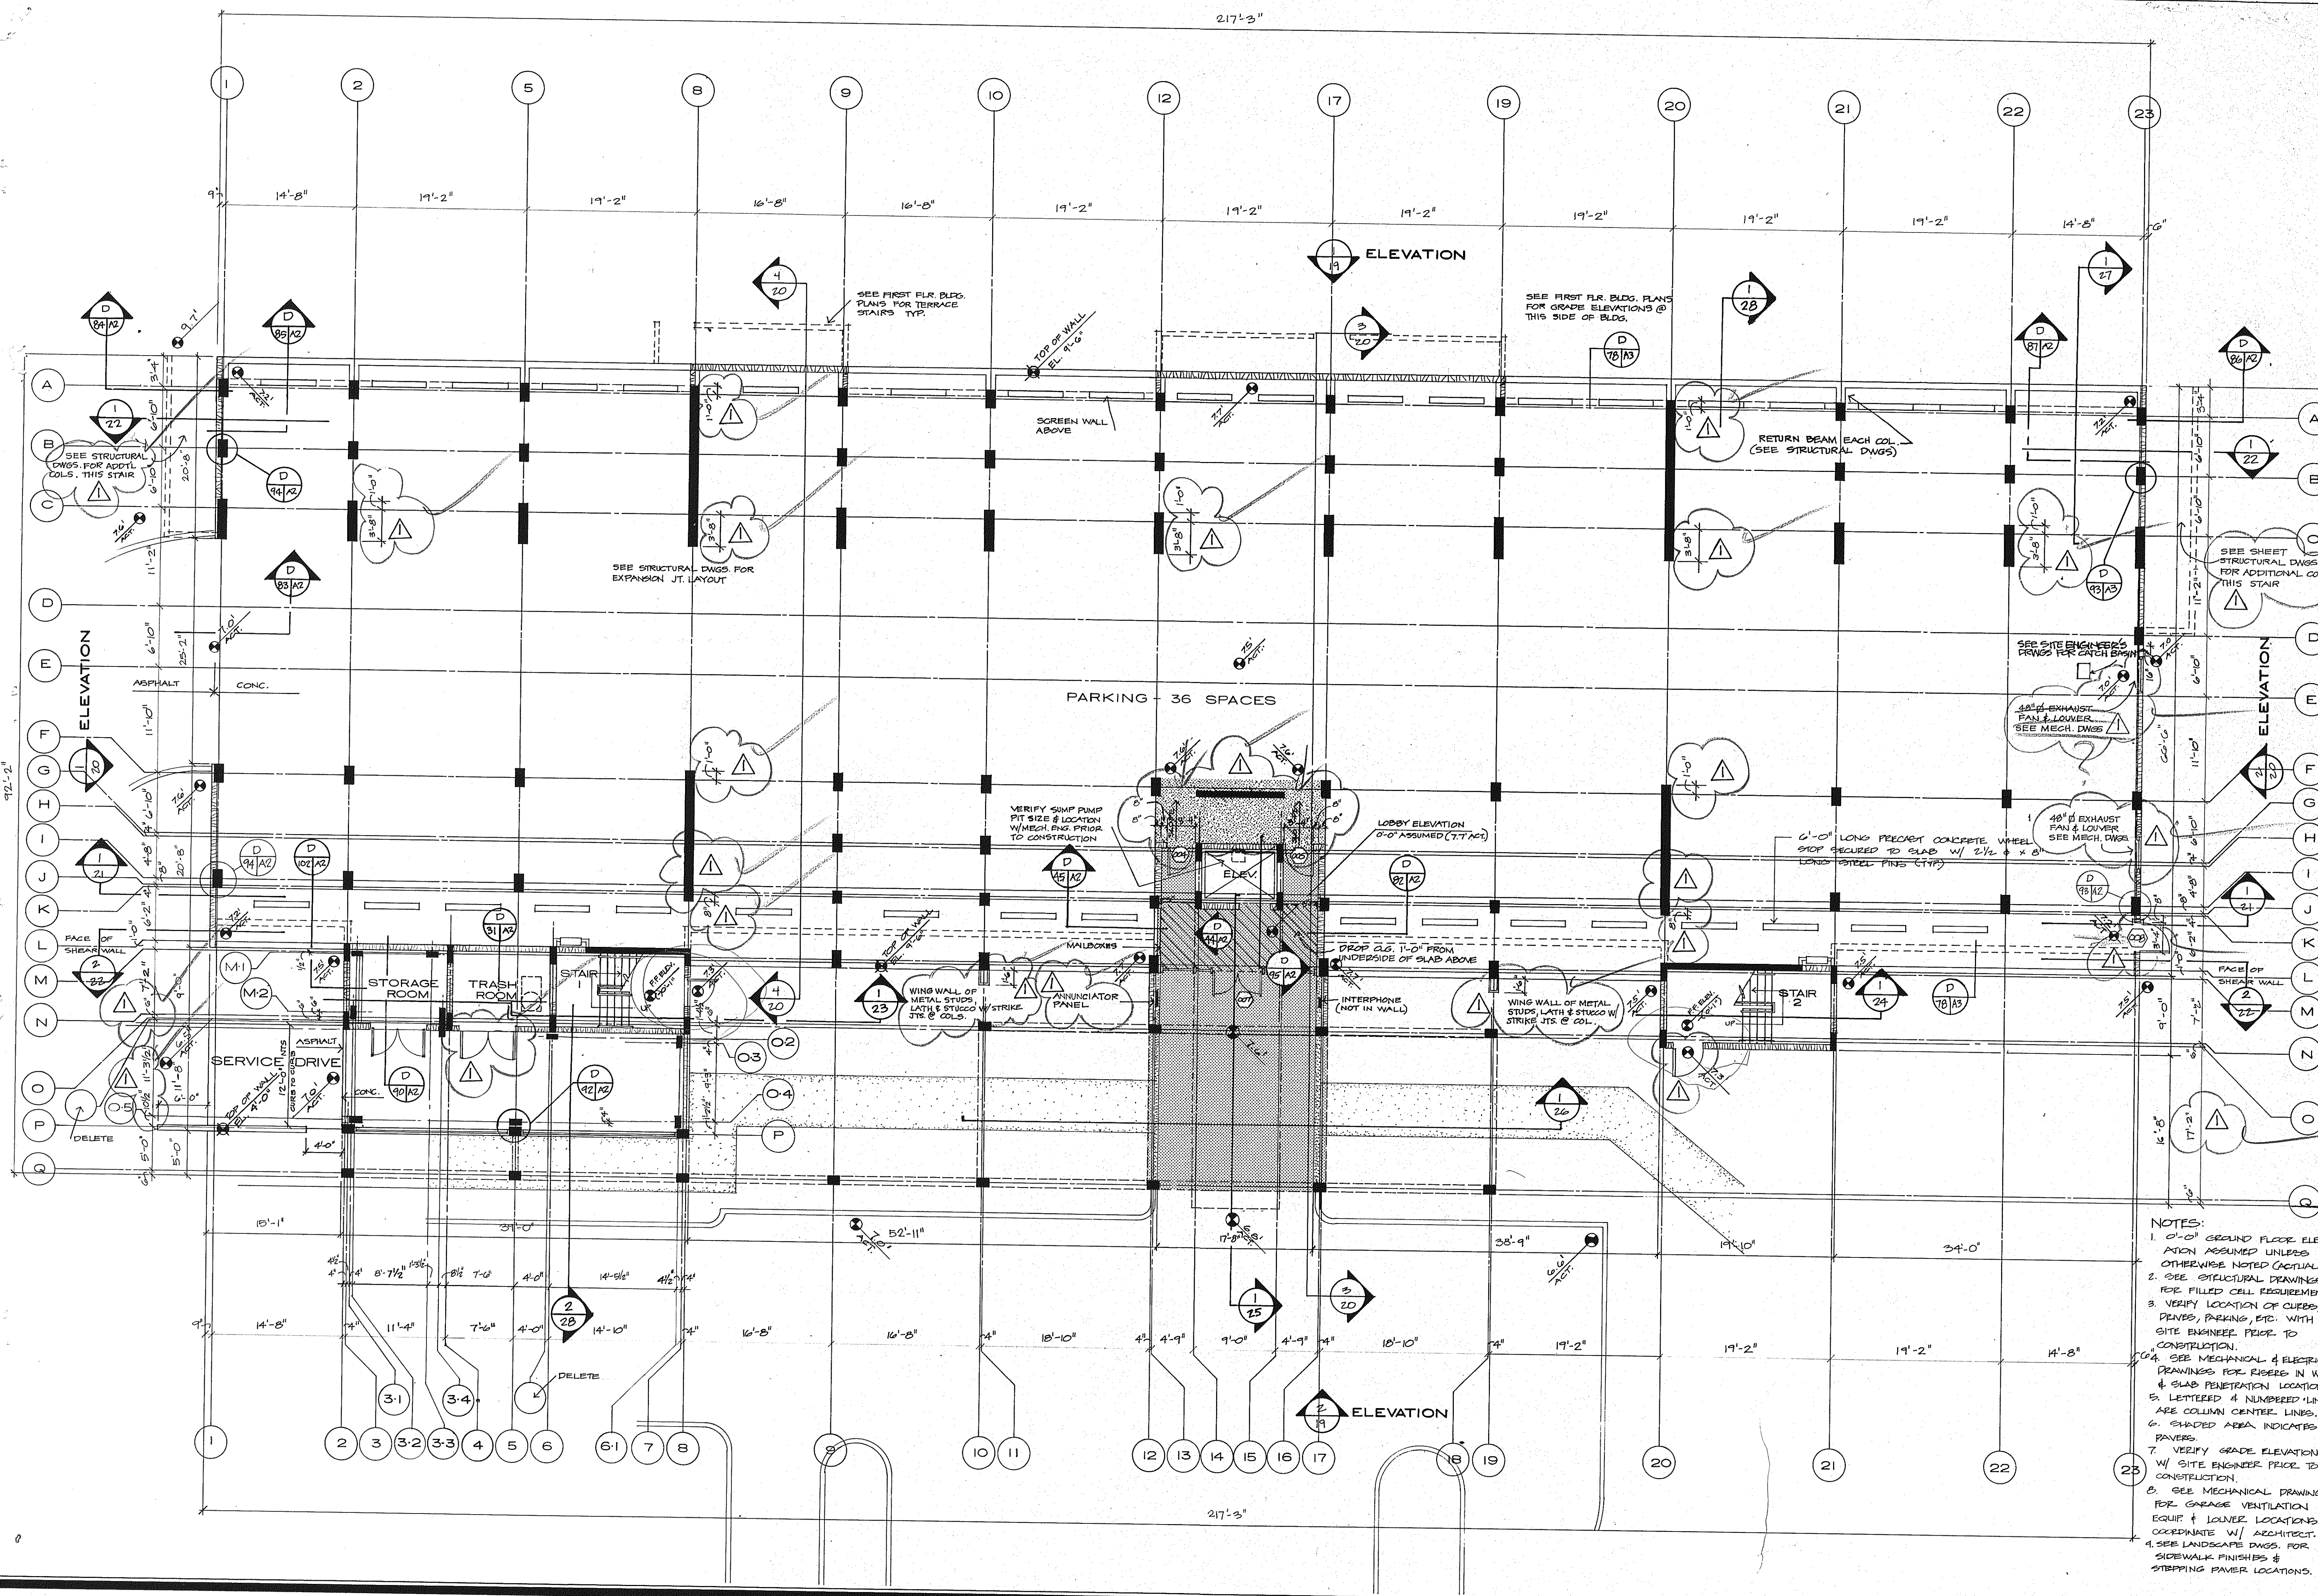

- NOTES:
- 0'-0" GROUND FLOOR ELEVATION ASSUMED UNLESS OTHERWISE NOTED (ACTUAL).
  - SEE STRUCTURAL DRAWINGS FOR FILLED CELL REQUIREMENTS.
  - VERIFY LOCATION OF CURBS, PAVES, PARKING, ETC. WITH SITE ENGINEER PRIOR TO CONSTRUCTION.
  - SEE MECHANICAL & ELECTRICAL DRAWINGS FOR RISERS IN WALL & SLAB PENETRATION LOCATIONS.
  - LETTERED & NUMBERED LINES ARE COLUMN CENTER LINES.
  - SHADED AREA INDICATES PAVERS.
  - VERIFY GRADE ELEVATIONS W/ SITE ENGINEER PRIOR TO CONSTRUCTION.
  - SEE MECHANICAL DRAWINGS FOR GARAGE VENTILATION EQUIP. & LOUVER LOCATIONS. COORDINATE W/ ARCHITECT.
  - SEE LANDSCAPE DWGS. FOR SIDEWALK FINISHES & STEPPING PAVES LOCATIONS.

BUILDING 3 GROUND FLOOR PLAN 1/8" = 1'-0"  
 ARVIDA CORPORATION · EDWARD J. SEIBERT, AIA, ARCHITECT & PLANNER, P.A. · THE SWA GROUP  
 BRABHAM, KUHNIS, DEBAY CONSULTING ENGINEERS · OLSEN WHITE & ASSOCIATES, STRUCTURAL ENGINEERS · BENNETT & BISHOP, INC., CONSULTING ENGINEERS & SURVEYORS  
 ISSUED 10 DEC 82  
 REVISED 4-1-83  
 SHEET A.2